
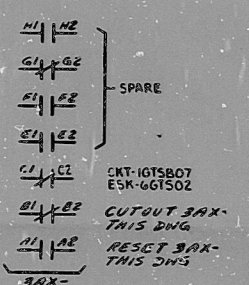
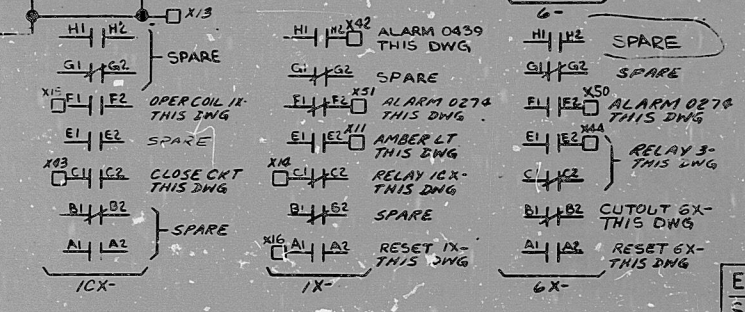


CONT'D FROM ESK-6GTS02-5M1

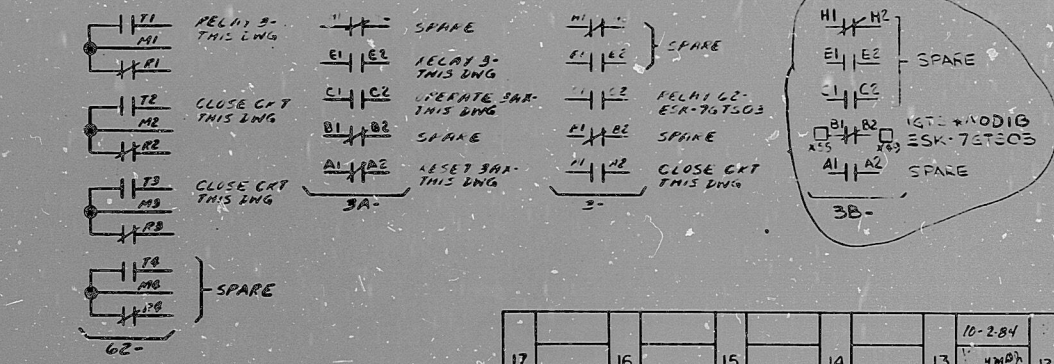

DOCUMENT USER  
CONSULT EADCR/NAD  
LISTING FOR CHANGES

NUCLEAR SAFETY RELATED  
QA CAT I & II

ELEM DIAG-480V SWGR  
STBY GAS TRTMT EXH FAN B  
RIVER BEND NUCLEAR STATION - UNIT 1  
GULF STATES UTILITIES COMPANY

STONE & WEBSTER ENGINEERING CORPORATION

12210-Esk-6GTS02 SH 2 OF 2

17	16	15	14	13	12	11	10	9	8	7	6	5	4	3	2	1
				10-2-84	10-2-84	3-18-81	2-14-81	1-21-81	1-21-81	1-21-81	1-21-81	1-21-81	1-21-81	1-21-81	1-21-81	1-21-81
				INCORP: EADCR SW1005 SW2000	INCORP: EADCR SW1005 SW2000	INCORP: EADCR SW1005 SW2000	INCORP: EADCR SW1005 SW2000	INCORP: EADCR SW1005 SW2000	INCORP: EADCR SW1005 SW2000	INCORP: EADCR SW1005 SW2000	INCORP: EADCR SW1005 SW2000	INCORP: EADCR SW1005 SW2000	INCORP: EADCR SW1005 SW2000	INCORP: EADCR SW1005 SW2000	INCORP: EADCR SW1005 SW2000	INCORP: EADCR SW1005 SW2000

TI  
APERTURE  
CARD

FOR INFORMATION ONLY

8412170570

FOR RIDS

