


J-14-0 SH. 1

REMOTE CONTROL PANEL C105

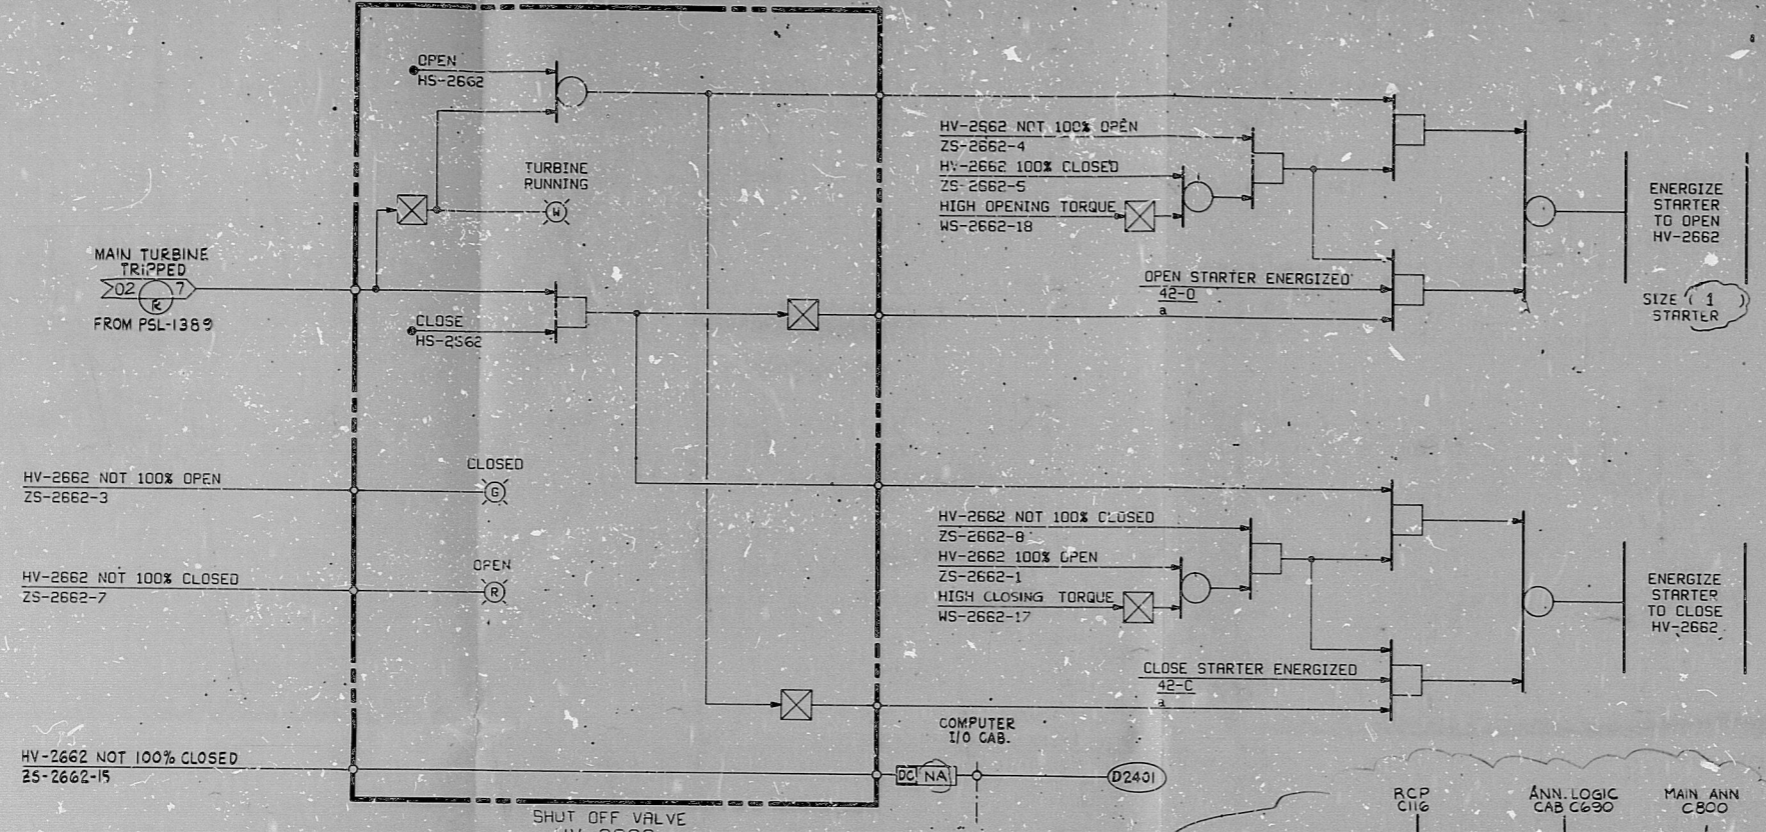


REFERENCES:



1	P & ID - TURBINE AUXILIARIES COOLING	M-14-1
2	DITS - SAFETY AND TURB. AUX. COOLING	D3.10
3	LOGIC DIAGRAM STANDARD SYMBOLS	J-00-0
4	DELETED	
5	SCHEMATIC	E-0241-0
6	WIRING DIAGRAM	J-02-0
7	LOGIC DIAGRAM-EXTRACTION STEAM	J-02-0
8	ISO-PHASE BUS COOLER CONTROL DIAG.	10855-EG-19

NOTE:

1. ISO-PHASE BUS COOLER PANEL, C116 IS WIRED AND FURNISHED BY VENDOR. FOR INTERNAL WIRING SEE REF. 8

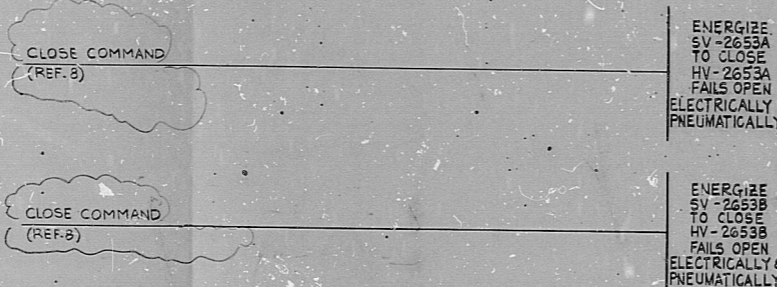

ISO-PHASE BUS COOLERS CLG WTR SHUTOFF VALVES

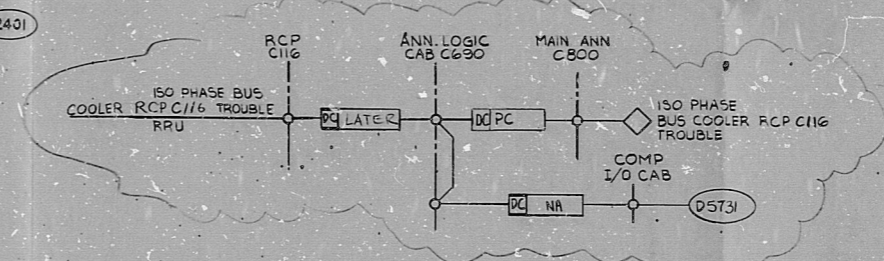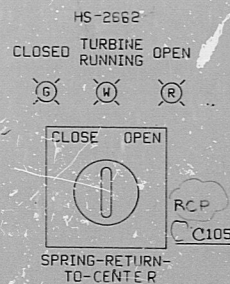

PRO APERTURE CARD

NO.	DATE	REVISIONS	BY	CHKD	DESIGN	ENGR	INSTR	APPR
1	10/1/79	DESIGN FREEZE ISSUE	JE	JE	JE	JE	JE	JE
2	9/1/79	REVISED AS NOTED	JE	JE	JE	JE	JE	JE
3	1/1/79	ISSUED FOR CONSTRUCTION	JE	JE	JE	JE	JE	JE

SCALE: NONE DESIGNED: JE DRAWN: REG

BECHTEL
SAN FRANCISCO

PUBLIC SERVICE ELECTRIC AND GAS COMPANY
HOPE CREEK GENERATING STATION

LOGIC DIAGRAM
TURBINE AUXILIARIES COOLING
TURBINE AUXILIARIES & ISO-PHASE BUS COOLERS SHUTOFF VALVES

JOB No.	DRAWING No.	REV.
10855	J-14-0 SH. 1	2

S/U - EG

RIDS

8307270494

