


J-18-0 SH. 2

RCP 00C118

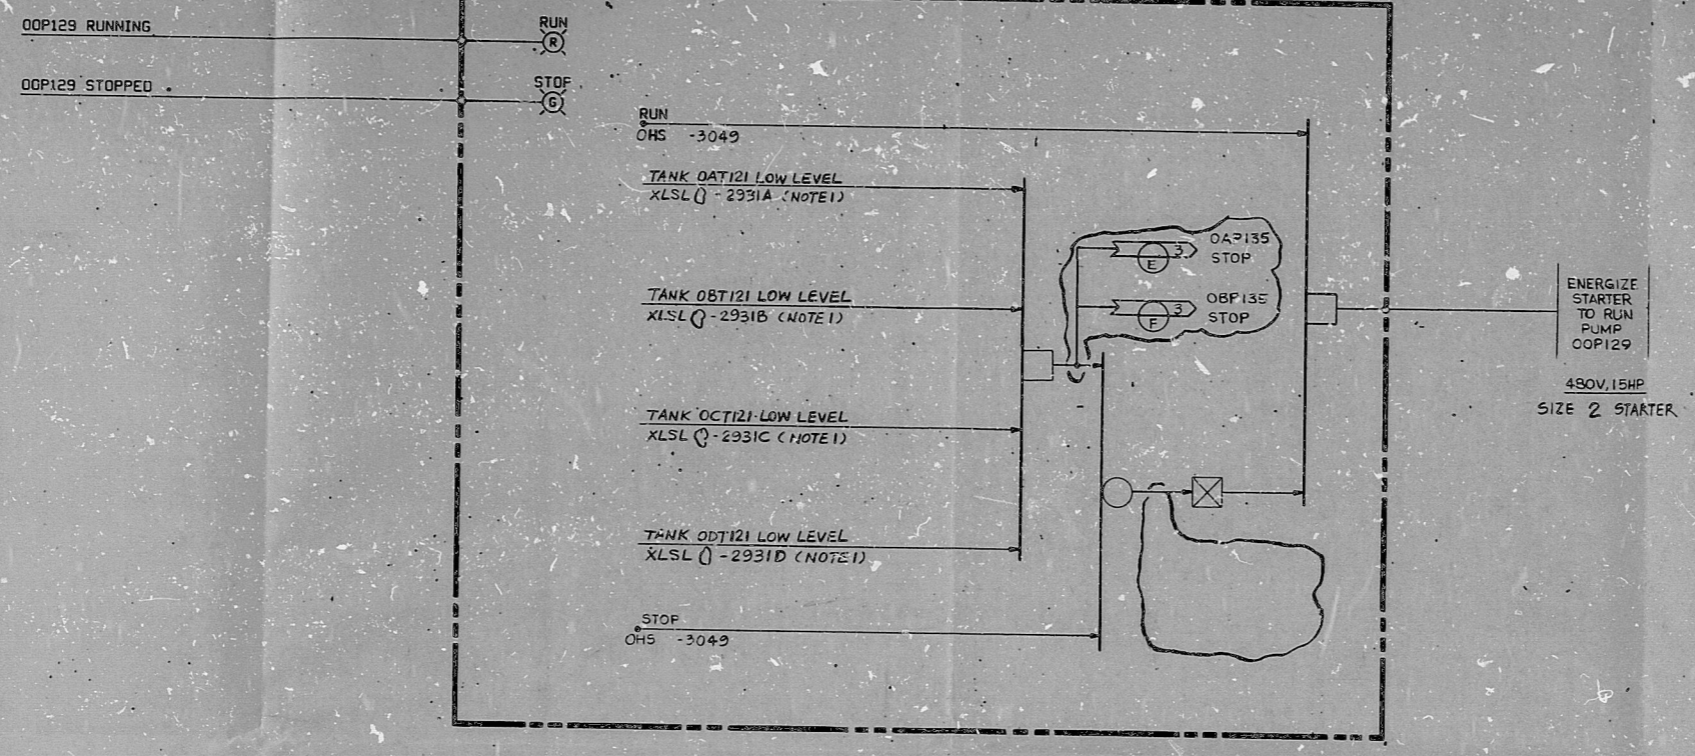

NOTES:
1. XLSL CONTACT OPEN ON LOW LEVEL.

JOCKEY PUMP OOP129

This drawing and the design it covers are the property of BECHTEL. They are hereby loaned and on the borrower's express agreement that they will not be reproduced, copied, loaned, exhibited, nor used except in the limited way and private use permitted by any written consent given by the lender to the borrower.



PRO APERTURE CARD

NO.	DATE	REVISIONS	BY	CHKD	DESIGN	APPV	DATE
1	10/12	DESIGN FREEZE ISSUE # UNIT 2 DELETION	SF	X.D.	S.F.S.		10/22
2	10/17	REVISED AS NOTED	jd	clp	ngb		10/27
3	11/13	REVISED AS NOTED	jd	clp	ngb		11/17
4	11/14	ISSUED FOR CONSTRUCTION	jd	clp	ngb		11/17

SCALE	NONE	DESIGNED	SF	DRAWN	RCG
BECHTEL SAN FRANCISCO					
PUBLIC SERVICE ELECTRIC AND GAS COMPANY HOPE CREEK GENERATING STATION					
LOGIC DIAGRAM DEMINERALIZED WTR MAKEUP STOR & XFR JOCKEY PUMP					
JOB No.	DRAWING No.	REV.			
10855	J-18-0	SH. 2	3		

S/U-AN

21 x 27 1/2" SIZE

RIDS

8307270515

