


2 3 4 5 6 7 8 9 10 11 12

GENERAL ELECTRIC 828531AA  
 REACTOR PROTECTION SYSTEM  
 FIRST MADE FOR

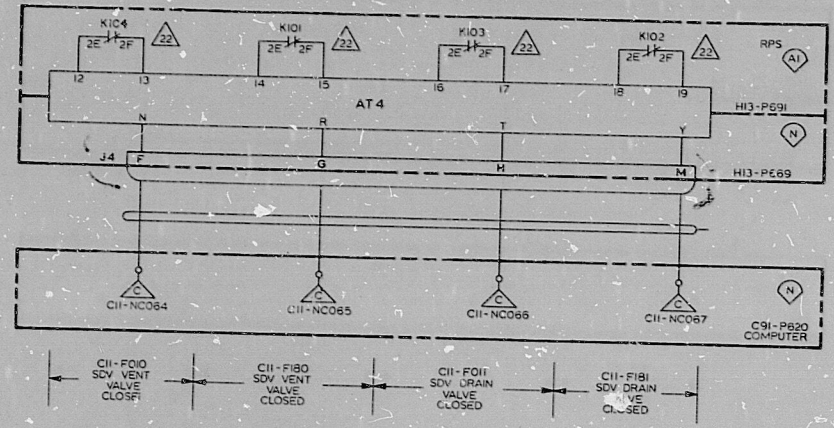

CII-F010 SOV VENT VALVE CLOSED  
 CII-F180 SOV VENT VALVE CLOSED  
 CII-F011 SOV DRAIN VALVE CLOSED  
 CII-F181 SOV DRAIN VALVE CLOSED

TI APERTURE CARD

2 3 4 5 6 7 8 9 10 11 12

REV	DATE	BY	CHK	DESCRIPTION
0				
1				
2				

LOC-1 3-16-83  
 NC 6.1  
 SAN JOSE  
 828531AA  
 12 CHK BY NAM 3-21-85

8412180156

PDR RIDS

