



J-19-0 SHT 3

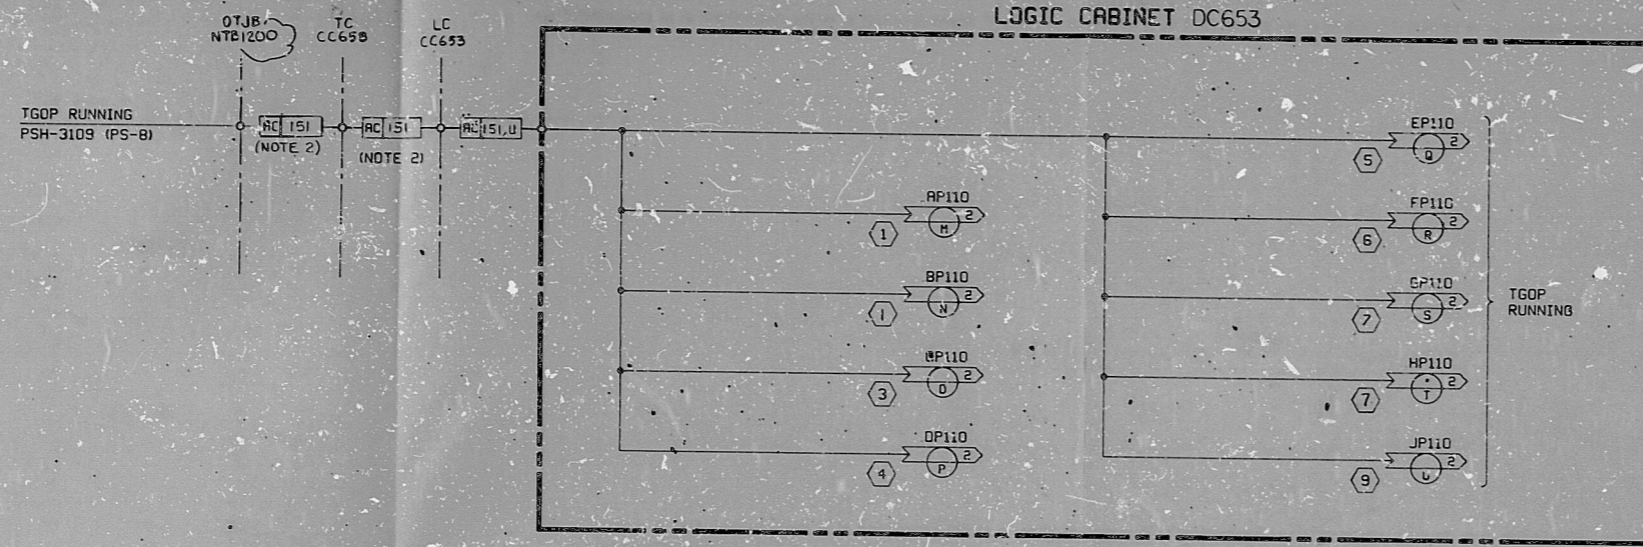

LIFT PUMP AUTO START
S/U-CB

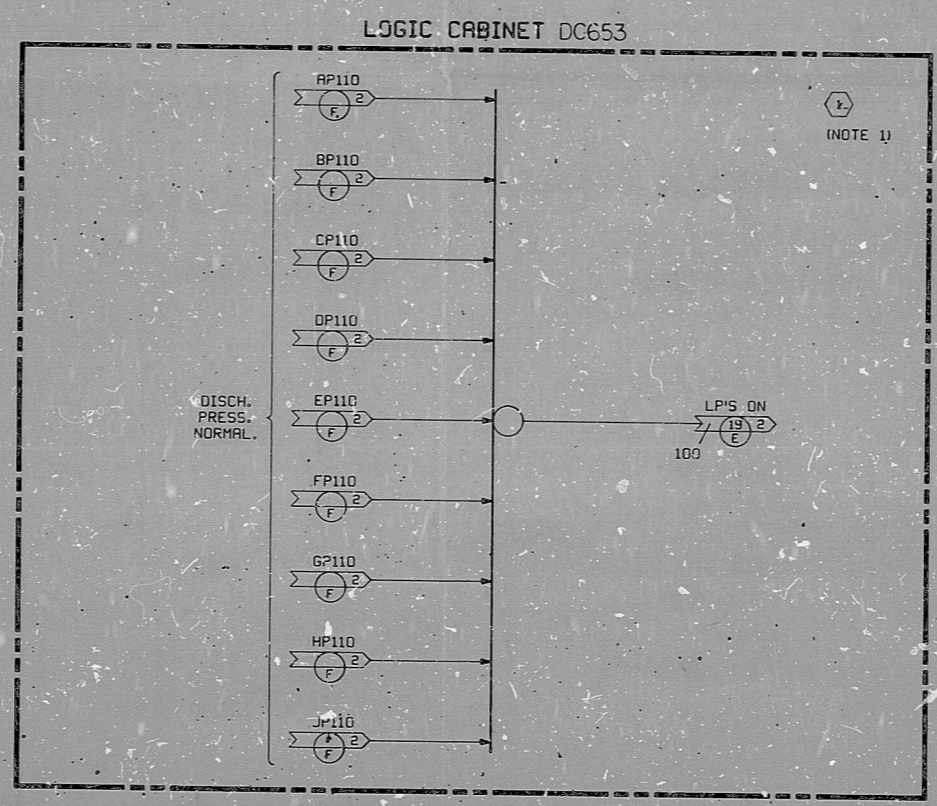

TURNING GEAR INTERLOCK
S/U-AC

- NOTES:
1. CIRCUIT NUMBER APPLIES TO AND ORIGINATES ON J-100-0 SHT 2.
 2. AC SUPPLIED FROM TGOP CONTROL POWER TRANSFORMER. SEE SHEET 4.

This drawing and the design it covers are the property of BECHTEL. They are hereby loaned and on this borrower's express agreement that they will not be reproduced, copied, loaned, sold, or used except in the limited way and private use permitted by any written consent given by the lender to the borrower.

P.R.C.
APERTURE
CARD

NO.	DATE	REVISIONS	BY	CHKD	DESIGN	SUPV	ENGR	PROJ	APPR
1	4/14/70	DESIGN FREEZE ISSUE	TP	80	300				
2	7/1/71	REVISED BAILEY INTERFACE AND AS NOTED							
3	7/1/71	REVISED AS NOTED							
4	11/1/72	REVISED AS NOTED							
5	2/1/73	REVISED AS NOTED							
6	2-9-76	ISSUED FOR CONSTRUCTION							

SCALE: NONE DESIGNED: CHS DRAWN: RGS

BECHTEL
SAN FRANCISCO

PUBLIC SERVICE ELECTRIC AND GAS COMPANY
HOPE CREEK GENERATING STATION

LOGIC DIAGRAM
LUBE OIL
PUMP INTERLOCKS

JOB No.	DRAWING No.	REV.
10855	J-19-0 SHT 3	5

22 X 34 "D" SIZE

S/U-AC, CB

RIDS

83077052

