

11

11

8.5

8.5

11

17

11


11

8.5

8.5

11

17

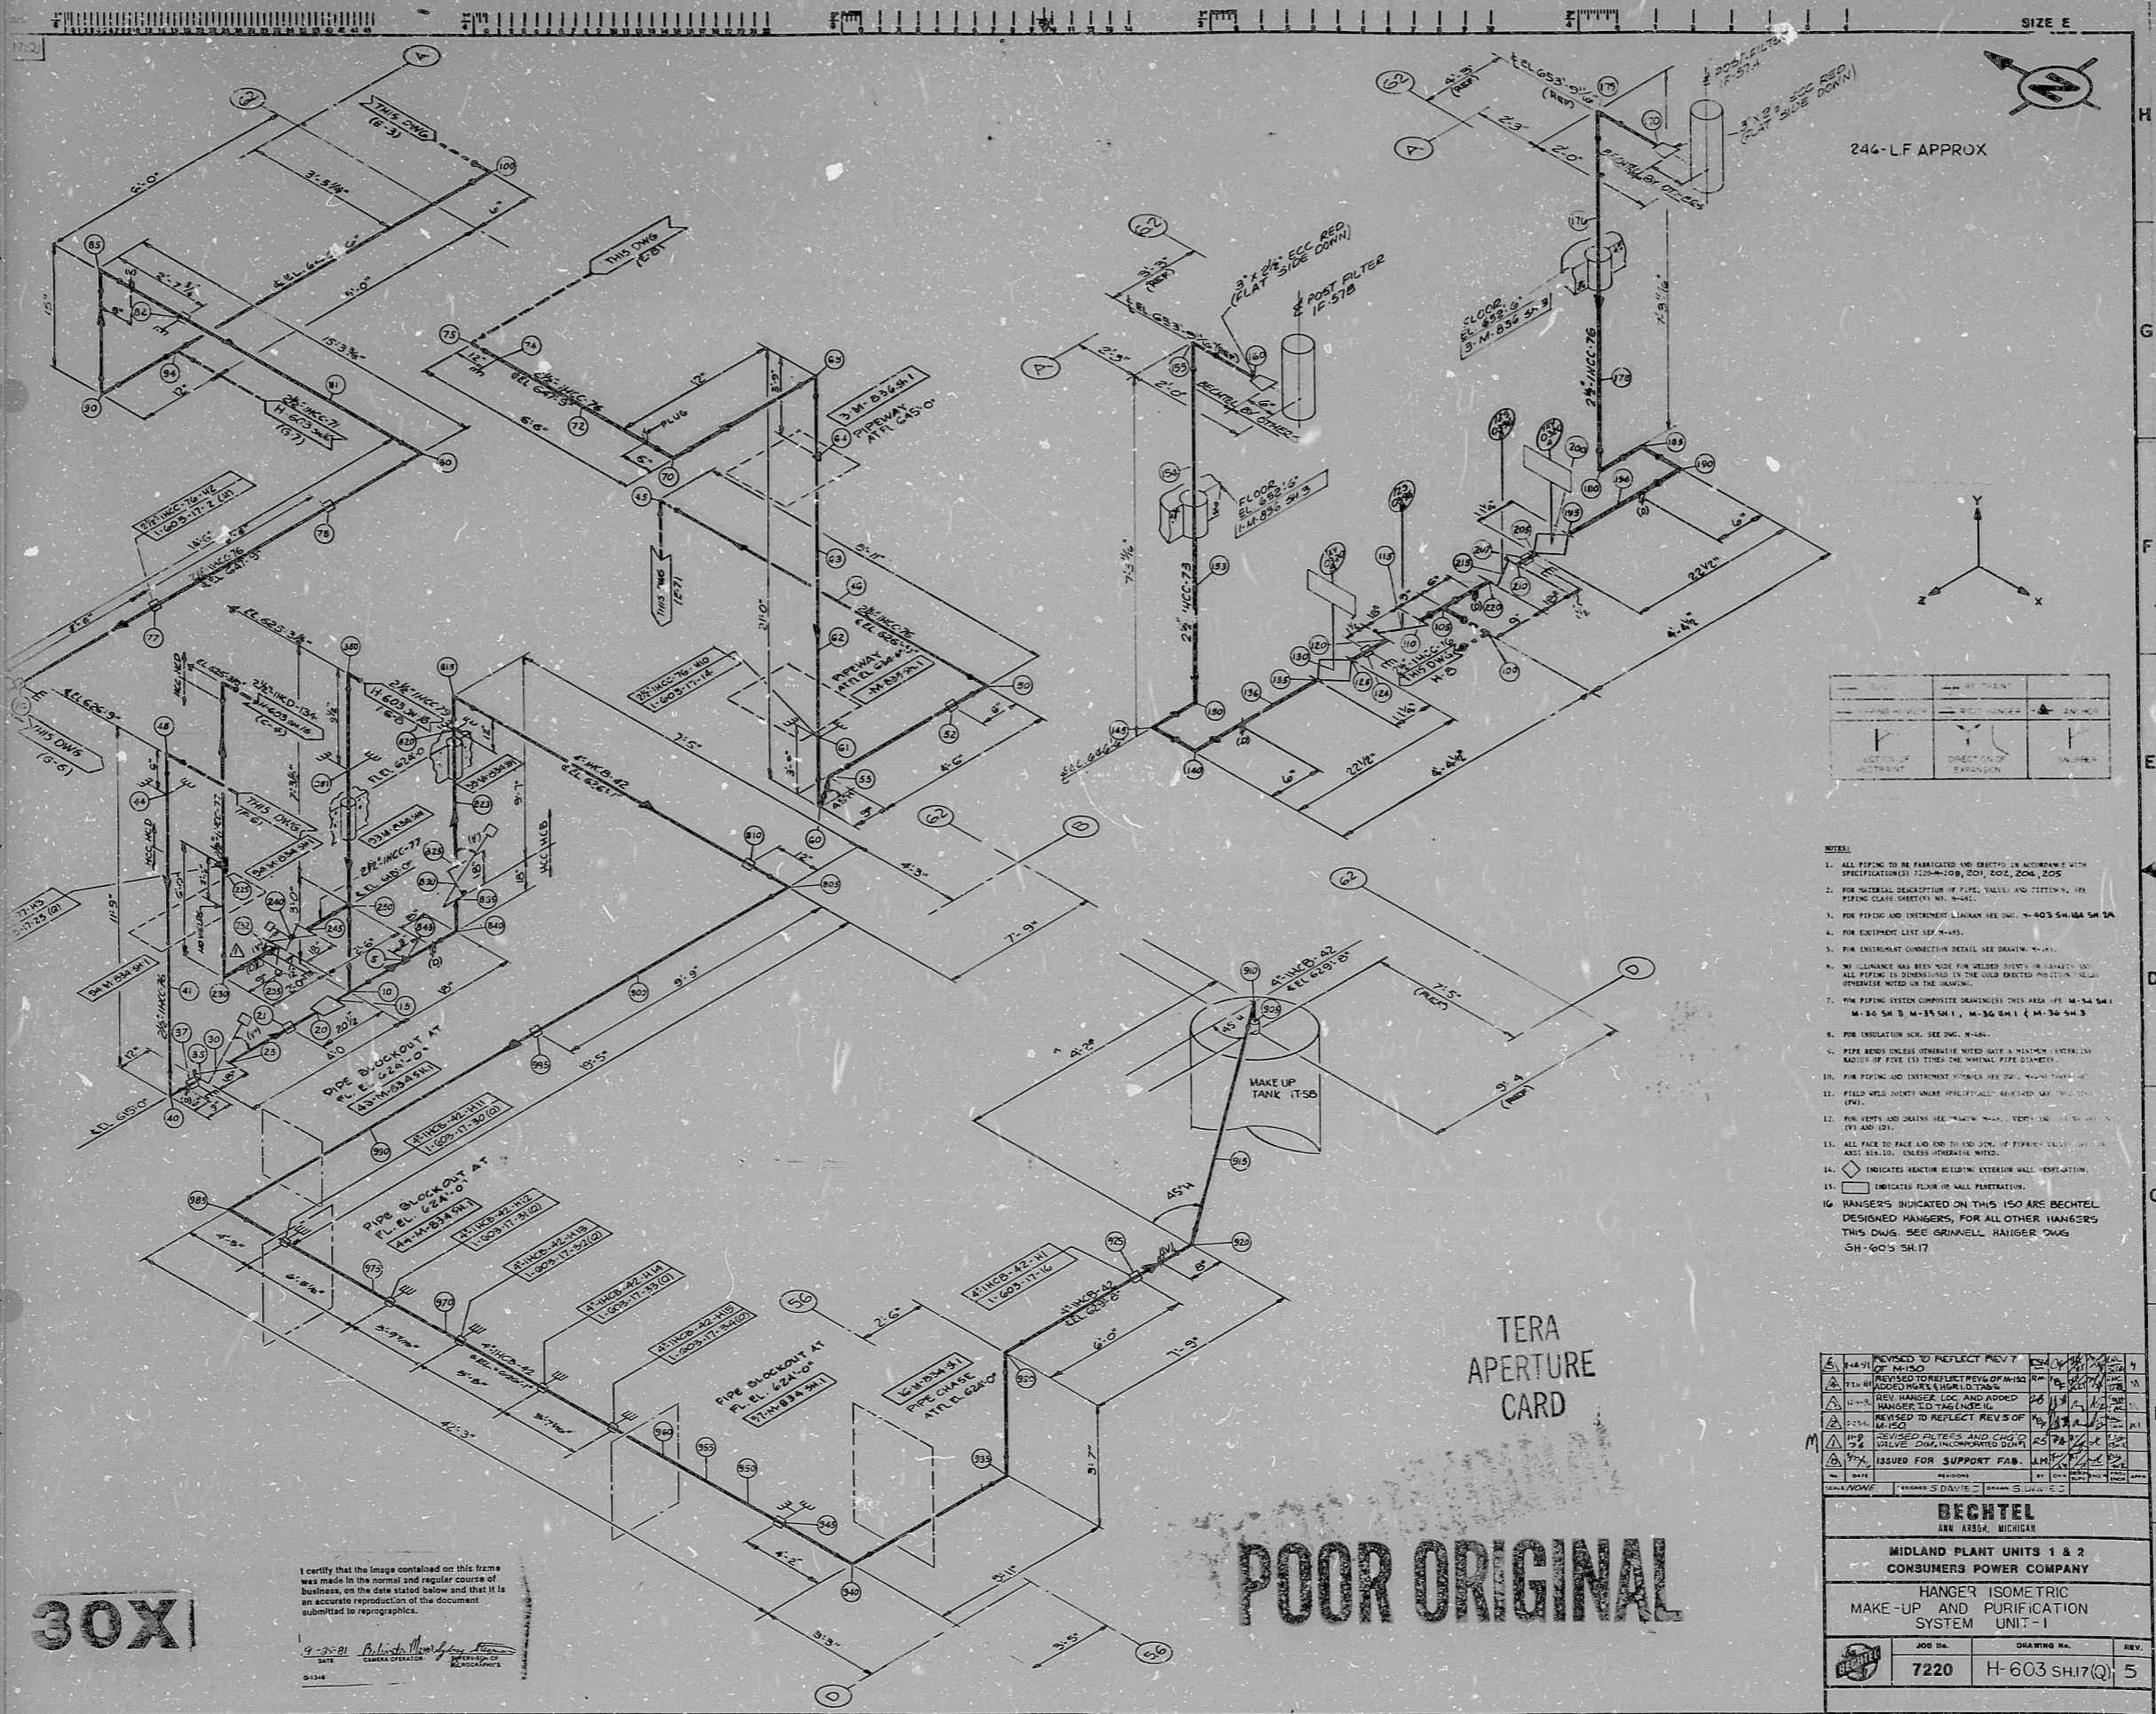

30X

I certify that the image contained on this frame was made in the normal and regular course of business, on the date stated below and that it is an accurate reproduction of the document submitted to reprographics.

9-22-81
DATE
REPRODUCTION
OPERATOR
REPROGRAPHICS
2014

POOR ORIGINAL

REVISED TO REFLECT REV. 7	DATE	BY	CHKD
REVISED TO REFLECT REV. 6	DATE	BY	CHKD
REVISED TO REFLECT REV. 5	DATE	BY	CHKD
REVISED TO REFLECT REV. 4	DATE	BY	CHKD
REVISED TO REFLECT REV. 3	DATE	BY	CHKD
REVISED TO REFLECT REV. 2	DATE	BY	CHKD
REVISED TO REFLECT REV. 1	DATE	BY	CHKD
ISSUED FOR SUPPORT FAB.	DATE	BY	CHKD
DATE	BY	CHKD	DATE
BECHTEL ANN ARBOR, MICHIGAN			
MIDLAND PLANT UNITS 1 & 2 CONSUMERS POWER COMPANY			
HANGER ISOMETRIC MAKE-UP AND PURIFICATION SYSTEM UNIT-1			
JOB NO.	DRAWING NO.	REV.	
7220	H-603 SH17(Q)	5	

RIDS

81222070

