


J-19-0 SHY. 9

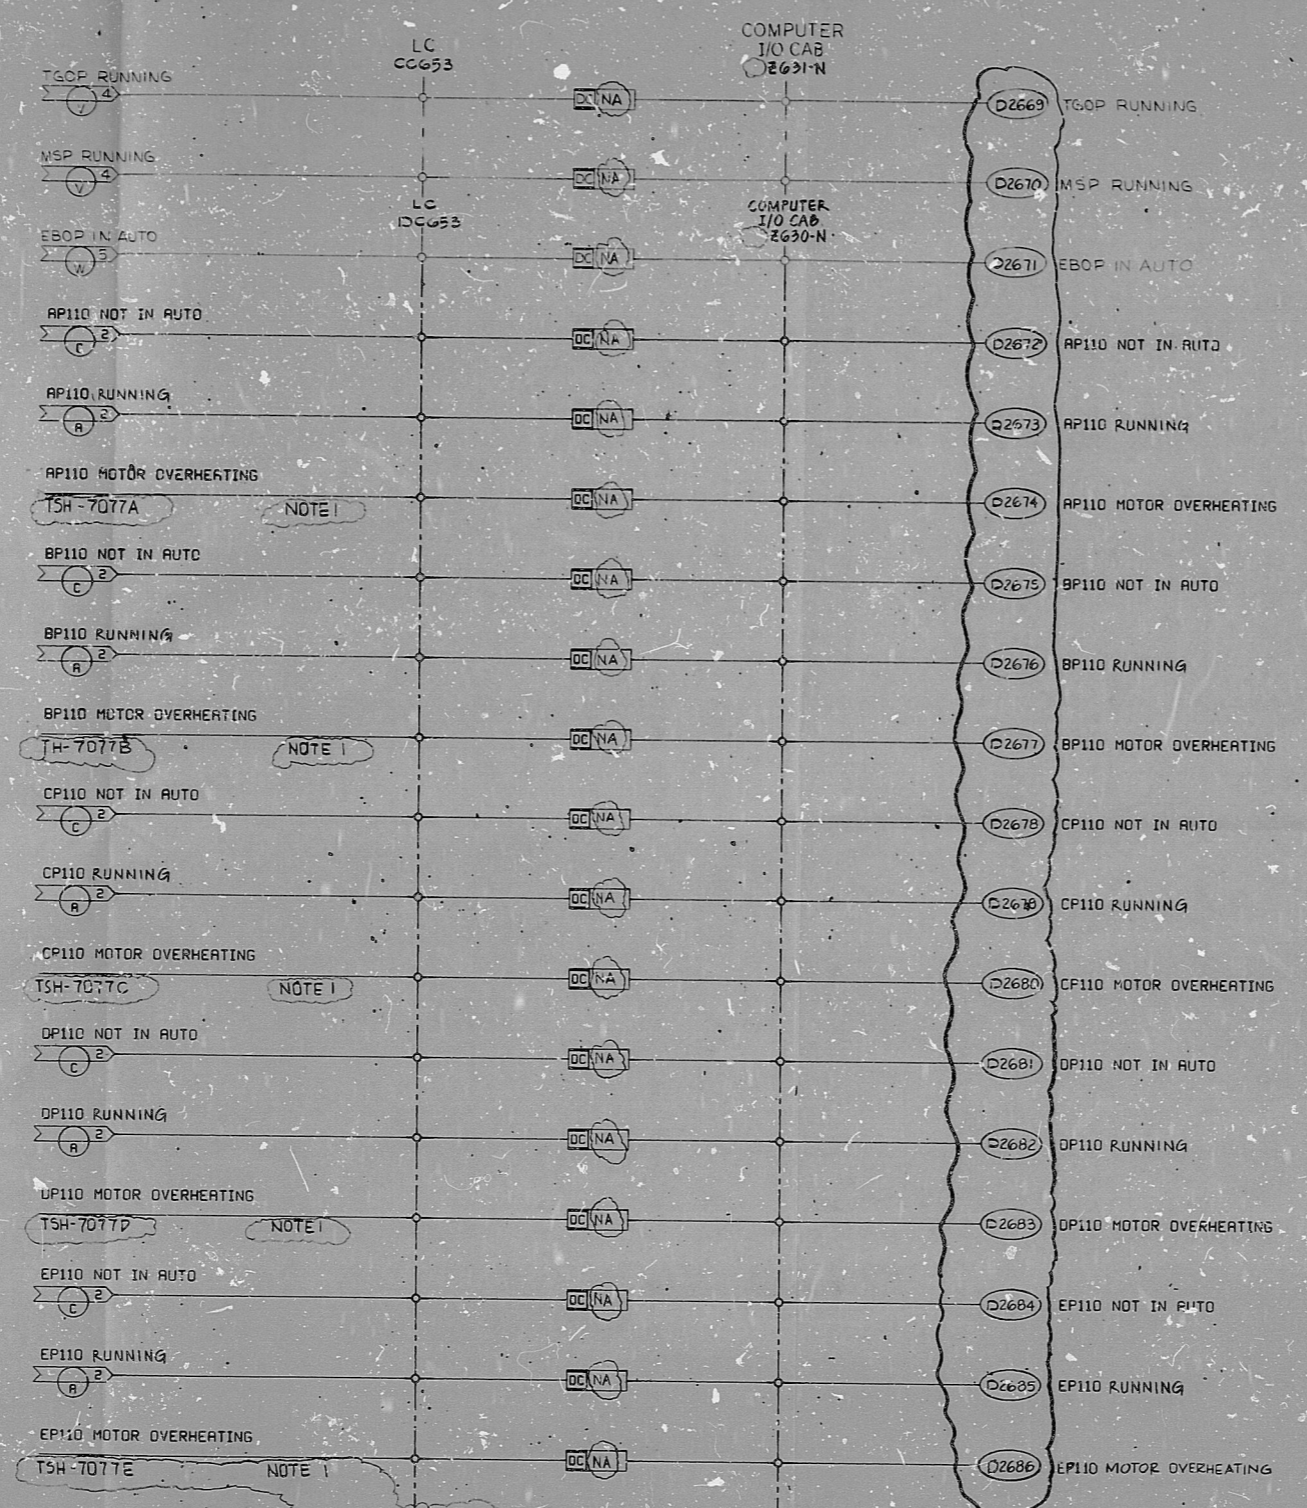

NOTES:
1. CONTACTS OPEN UPON CONDITIONS STATED

PRO APERTURE CARD

| NO. | DATE | REVISIONS | BY | CHKD | DESIGN | ENR | APPR |
|-----|---------|-------------------------|----|------|--------|-----|------|
| 1 | 1/1/72 | DESIGN FREEZE ISSUE | TP | 20 | 20 | 20 | 20 |
| 2 | 7/1/72 | REVISED AS NOTED | CH | 22 | 18 | 18 | 18 |
| 3 | 11/1/72 | REVISED AS NOTED | CH | 22 | 18 | 18 | 18 |
| 4 | 7/1/72 | REVISED AS NOTED | CH | 22 | 18 | 18 | 18 |
| 5 | 1/1/76 | ISSUED FOR CONSTRUCTION | CH | 22 | 18 | 18 | 18 |

| | | |
|--|---------------|-------------|
| SCALE: NONE | DESIGNED: CHS | DRAWN: PCCG |
| BECHTEL SAN FRANCISCO | | |
| PUBLIC SERVICE ELECTRIC AND GAS COMPANY HOPE CREEK GENERATING STATION | | |
| LOGIC DIAGRAM LURE OIL | | |
| LOGIC CABINET COMPUTER INPUTS | | |
| JOB No. | DRAWING No. | REV. |
| 10855 | J-19-0 SHY. 9 | 4 |

This drawing and the design it covers are the property of BECHTEL. They are hereby loaned and on the borrower's express agreement that they will not be reproduced, copied, loaned, exhibited, nor used except in the limited way and private use permitted by any written consent given by the lender to the borrower.

22"
17"
11"
8.5"
8.5"
11"
17"
22"

22"
17"
11"
8.5"
8.5"
11"
17"
22"

RIDS

8307270526

