


J-19-0 SHT. 10

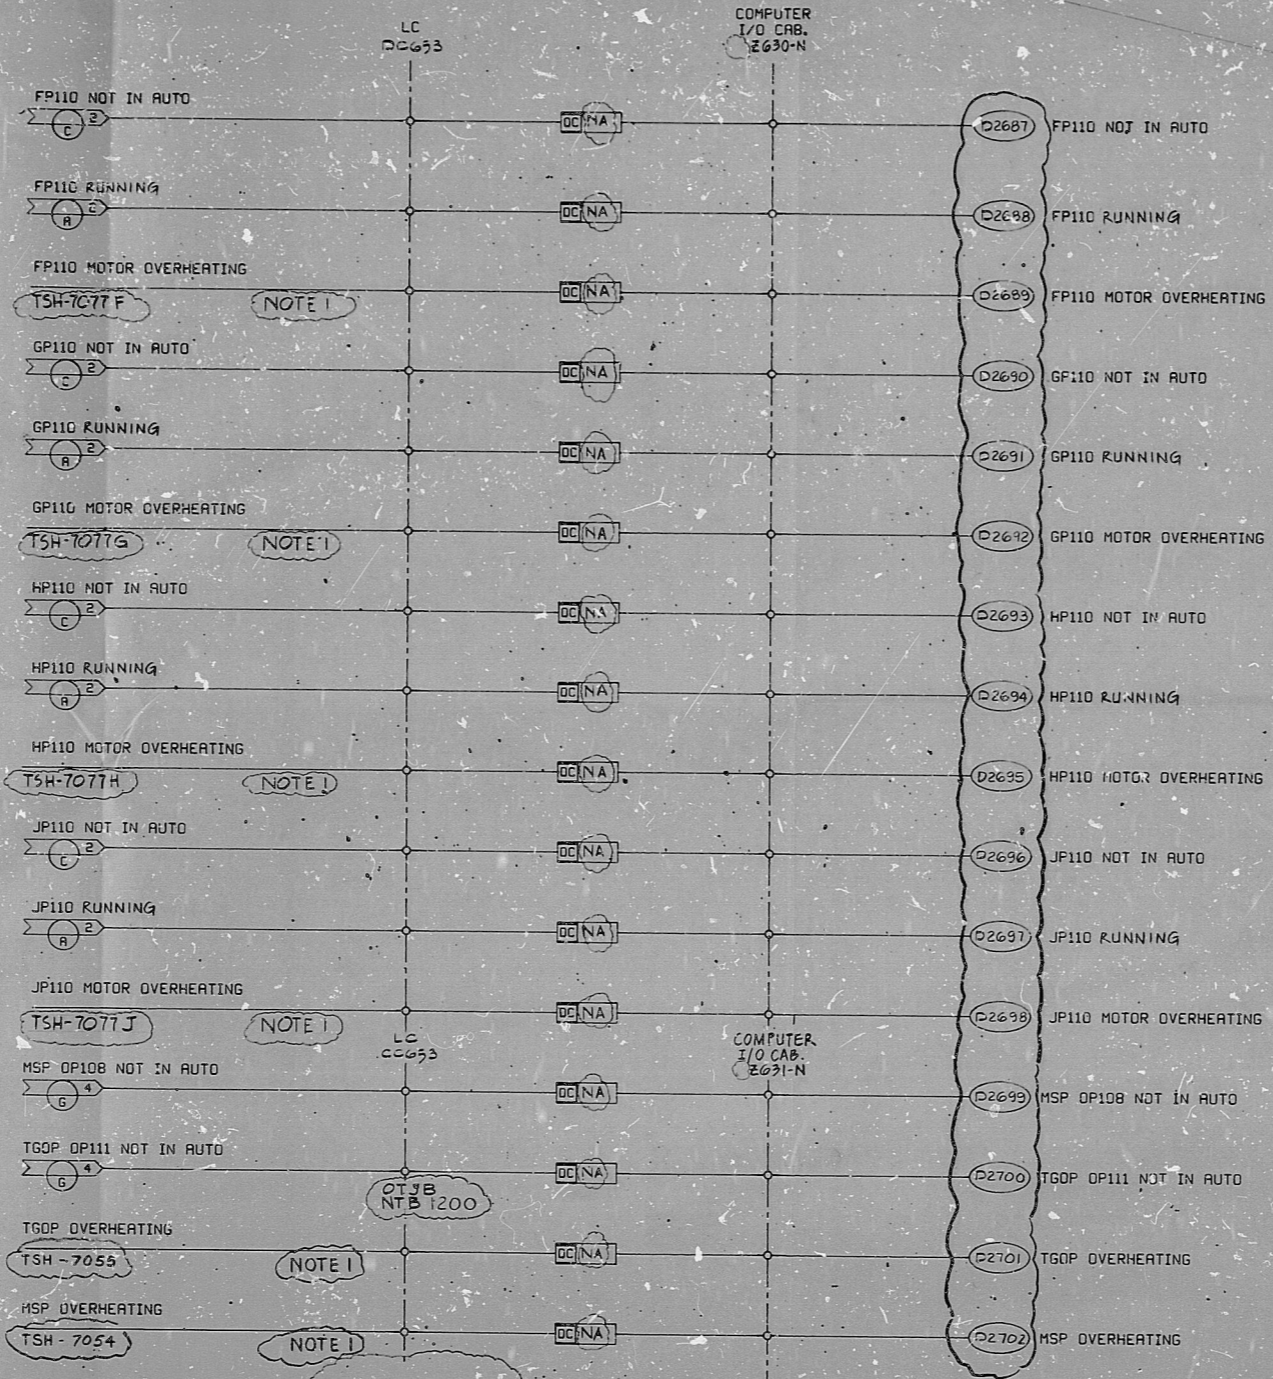

NOTES:
1. CONTACTS OPEN UPON CONDITIONS STATED

P.P.C
APERTURE
CARD

NO.	DATE	REVISIONS	BY	CHKD	DESIGN	ENGR	ENGR	APPR
1	6/4/62	DESIGN FREEZE ISSUE	TP	SL	SL	SL	SL	SL
2	9/11/62	REVISED AS NOTED	CA	SL	SL	SL	SL	SL
3	10/1/62	REVISED AS NOTED	WD	SL	SL	SL	SL	SL
4	10/1/62	REVISED AS NOTED	SL	SL	SL	SL	SL	SL
5	9/9/62	ISSUED FOR CONSTRUCTION	SL	SL	SL	SL	SL	SL

SCALE NONE DESIGNED CHS DRAWN RGS

BECHTEL
SAN FRANCISCO

PUBLIC SERVICE ELECTRIC AND GAS COMPANY
HOPE CREEK GENERATING STATION

LOGIC DIAGRAM
LUBE OIL

LOGIC CABINET COMPUTER INPUTS

JOB No.	DRAWING No.	REV.
10855	J-19-0 SHT. 10	4

SJU-CB-PJ

This drawing and its design, if shown, are the property of BECHTEL. They are hereby loaned, and on the borrower's express agreement that they will not be reproduced, copied, leased, exhibited, nor used except in the limited way and under the conditions permitted by any written consent given by the lender to the borrower.

RIDS

8307270527

