

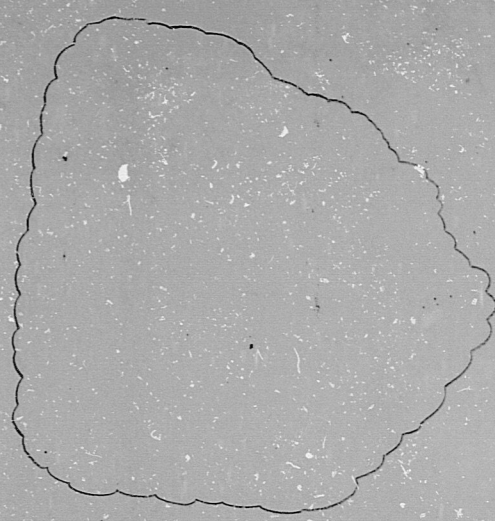


J-19-0 SHT. 11

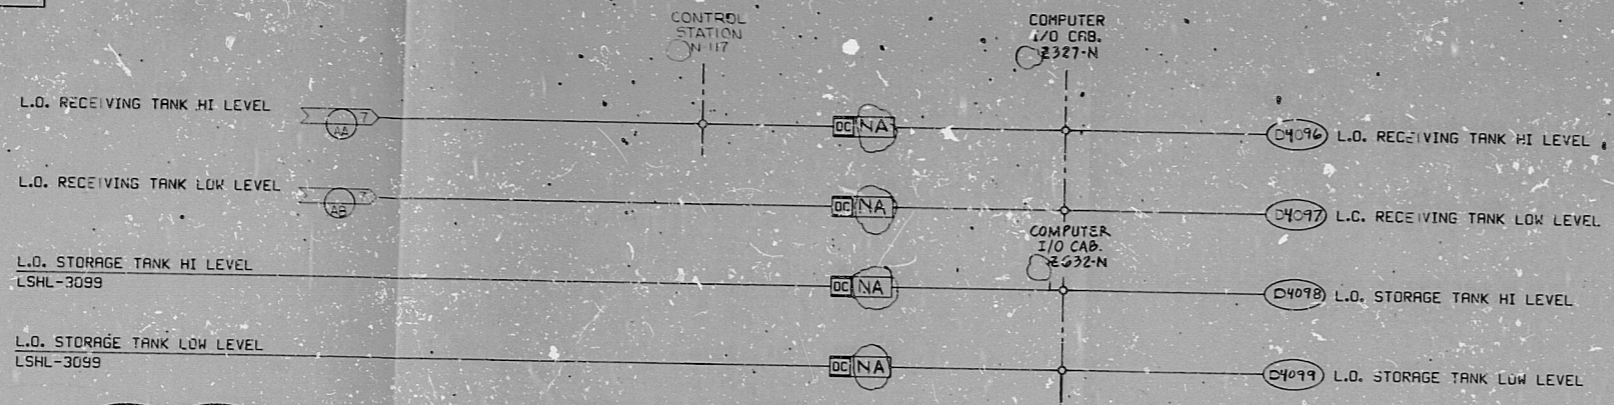

This drawing and the design it covers are the property of BECHTEL. They are hereby loaned and on the borrower's express agreement that they will not be reproduced, copied, loaned, exhibited, nor used except in the limited way and under the conditions set forth in the written consent given by the lender to the borrower.

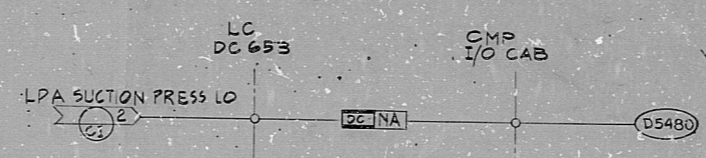

SERVICE DESCRIPTION	CMP ID.	WIRE #
LP. APIO SUCT PRESS LO	D 5480	NA
	D 5431	NA
	D 5482	NA
	D 5483	NA
	D 5484	NA
	D 5485	NA
	D 5486	NA
	D 5487	NA
	D 5488	NA

PRO APERTURE CARD

NO.	DATE	REVISIONS	BY	CHKD	DESIGN SUPV	DRWR	PROJ APPR
1	6/2/82	DESIGN FREEZE ISSUE	TP	208	555	208	208
2	7/1/82	REVISED BAILEY INTERFACE AND AS NOTED	CA	211	555	211	211
3	7/1/82	REVISED AS NOTED	W	211	555	211	211
4	7/1/82	REVISED AS NOTED	CA	211	555	211	211
5	7/9/82	ISSUED FOR CONSTRUCTION	CA	211	555	211	211

SCALE NONE DESIGNED CHS DRAWN RCG

**BECHTEL**  
SAN FRANCISCO

PUBLIC SERVICE ELECTRIC AND GAS COMPANY  
HOPE CREEK GENERATING STATION

LOGIC DIAGRAM  
LUBE OIL  
FIG. 2 COMPUTER INPUTS

JOB No.	DRAWING No.	REV.
10855	J-19-0 SHT 11	1

S/U-CF, CB

22 X 34 1/2" SIZE

RIDS

8397270528

