



J-19-0 SHL 14

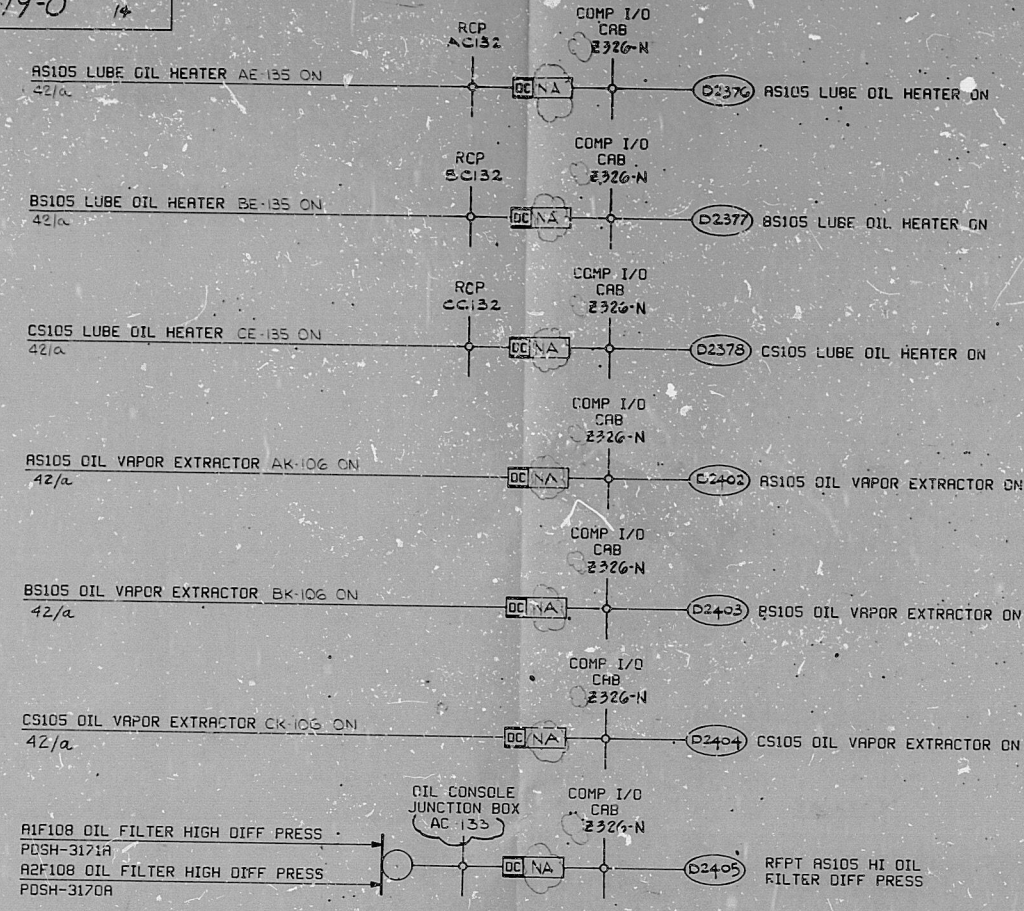

CROSS REFERENCE TABLE

TURBINE	FILTER NO.1/ PRESS SW.	FILTER NO.2/ PRESS SW.	JUNCTION BOX	WIRE NO.	COMP I/O CAB	COMPUTER INPUT NO.
AS105	A1F10B/PDSH-317IA	A2F10B/PDSH-3170A	AC 133	(N/A)	2326-N	D2405
BS105	B1F10B/PDSH-317IB	B2F10B/PDSH-3170B	BC 133			D2406
CS105	C1F10B/PDSH-317IC	C2F10B/PDSH-3170C	CC 133			D2407

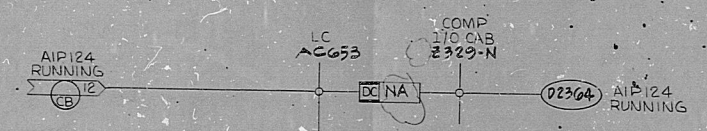

CROSS REFERENCE TABLE

PUMP	ARROW I.D.	LOGIC CAB	WIRE NO.	COMP I/O	COMP INPUT NO.	DESCRIPTION
AIP124	CB SHT.12	AC653	NA	2329-N	D2364	AIP124 RUNNING
A2P124	CB SHT.12	B		33	D2367	A2P124 RUNNING
AP125	CB SHT.13	A		29	D2370	AP125 RUNNING
BIP124	CB SHT.12	B		33	D2365	BIP124 RUNNING
B2P124	CB SHT.12	C		31	D2366	B2P124 RUNNING
BP125	CB SHT.13	B		33	D2371	BP125 RUNNING
CIP124	CB SHT.12	A		31	D2366	CIP124 RUNNING
C2P124	CB SHT.12	A		32	D2368	C2P124 RUNNING
CP125	CB SHT.13	C		31	D2372	CP125 RUNNING
AIP124	CA SHT.12	A		29	D4037	AIP124 IN AUTO
A2P124	CA SHT.12	E		33	D4040	A2P124 IN AUTO
AP125	CD SHT.13	A		29	D4043	AP125 IN AUTO
BIP124	CA SHT.12	B		33	D4038	BIP124 IN AUTO
B2P124	CA SHT.12	C		31	D4041	B2P124 IN AUTO
BP125	CD SHT.13	B		33	D4044	BP125 IN AUTO
CIP124	CA SHT.12	A		31	D4039	CIP124 IN AUTO
C2P124	CA SHT.12	A		29	D4042	C2P124 IN AUTO
CP125	CD SHT.13	C		31	D4045	CP125 IN AUTO

NOTE:
1 DELETED

PRO
APERTURE
CARD

NO.	DATE	REVISIONS	BY	CHKD	DESIGN	ENGR	APPV
1	11/12	DESIGN FREEZE ISSUE	7P	20	ES		
2	1/10	REVISED BAILEY INTERFACE AS NOTED	AL	11			
3	11/18	REVISED AS NOTED	MO	18			
4	11/10	REVISED AS NOTED	EL	10			
5	11/93	ISSUED FOR CONSTRUCTION					

SCALE: NONE DESIGNED: CHS DRAWN: RCG

BECHTEL
SAN FRANCISCO

PUBLIC SERVICE ELECTRIC AND GAS COMPANY
MCPE CREEK GENERATING STATION

LOGIC DIAGRAM
LUPE OIL
RFT OIL SYSTEM COMPUTER INPUTS

JOB No.	DRAWING No.	REV.
10855	J-19-0 SHL 14	4

S/U - CJ

22 X 34 "D" SIZE

This drawing and the design it covers are the property of BECHTEL. They are hereby loaned, and on the borrower's express agreement that they will not be reproduced, copied, loaned, exhibited, or used except in the manner way and private use permitted by any written consent given by the lender to the borrower.

RIDS

8307270531

