


J-05-0 SHT. 4

This drawing and the design it covers are the property of BECHTEL. They are merely loaned and on the borrower's express agreement that they will not be reproduced, copied, loaned, exhibited, nor used except in the limited way and private use permitted by any written consent given by the lender to the borrower.

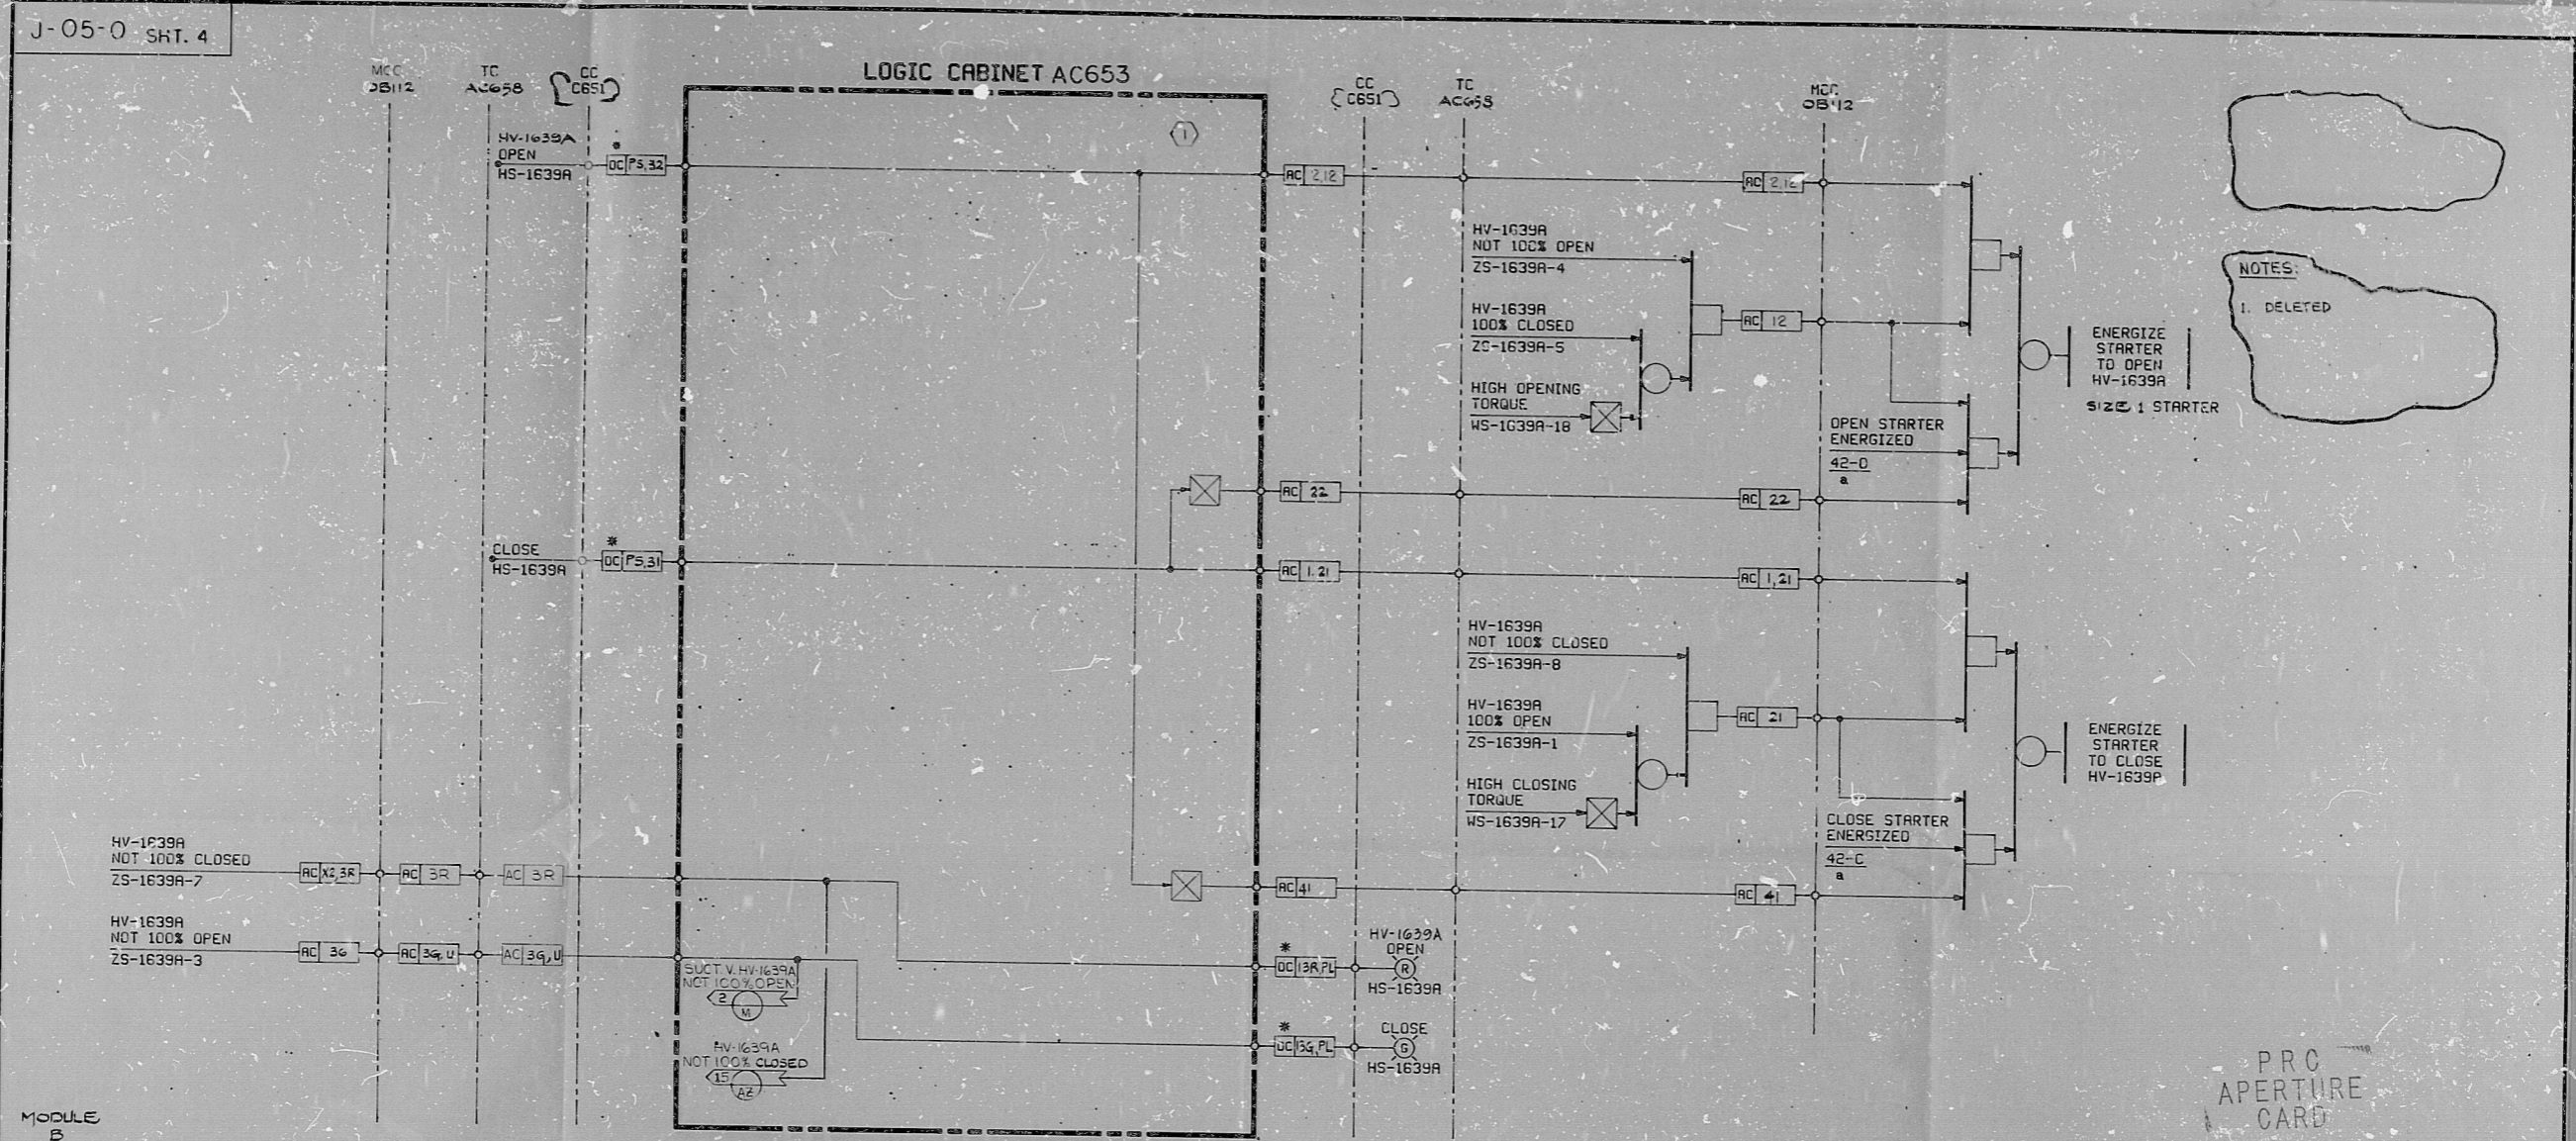

NOTES:
1. DELETED

PRC APERTURE CARD

MODULE B

HV1639A	OPEN (R)	SEC 1 HS-1639A
	CLOSE (G)	
	LOCKOUT (A)	NOT USED
	AUTO (M)	
HV-1639A	OPEN (R)	SEC 2 HS-1639A SHT. 3
	CLOSE (G)	CONTROL CONSOLE CL51A

CROSS REFERENCE TABLE

VALVE NO.	COND PUMP NO.	HAND SWITCH NO.	POSITION SWITCH (NOTE-1)	TORQUE SWITCH (NOTE-1)	MCC	TC NO.	CIRCUIT NO.	LOGIC CABINET	HAND SWITCH LAYOUT
	PRIMARY							MODULE	SECTION
HV-1639R	API02	HS-1639A	ZS-1639A	WS-1639A	OB112	AC658	1	AC653	B
HV-1639B	BPI02	HS-1639B	ZS-1639B	WS-1639B	OB141	BC658	2	BC653	B
HV-1639C	CPI02	HS-1639C	ZS-1639C	WS-1639C	OB122	CC658	3	CC653	B

NO.	DATE	REVISIONS	BY	CHKD	DESIGN	SUPV	ENGR	APPR
1	8/11/74	DESIGN FREEZE ISSUE						
2	11/1/74	REVISED AS NOTED						
3	1/1/75	REVISED AS INDICATED						
4	1/25/75	ISSUED FOR CONSTRUCTION						

BECHTEL
SAN FRANCISCO

PUBLIC SERVICE ELECTRIC AND GAS COMPANY
HOPE CREEK GENERATING STATION

LOGIC DIAGRAM
CONDENSATE SYSTEM
PRIMARY CNDP PUMP SUCT VALVES

JOB No.	DRAWING No.	REV.
10855	J-05-0 SHT. 4	3

S/U - AD

4/76 K0414 J001-753 343

RIDS

11071094

