


J-05-0 SHT. 8

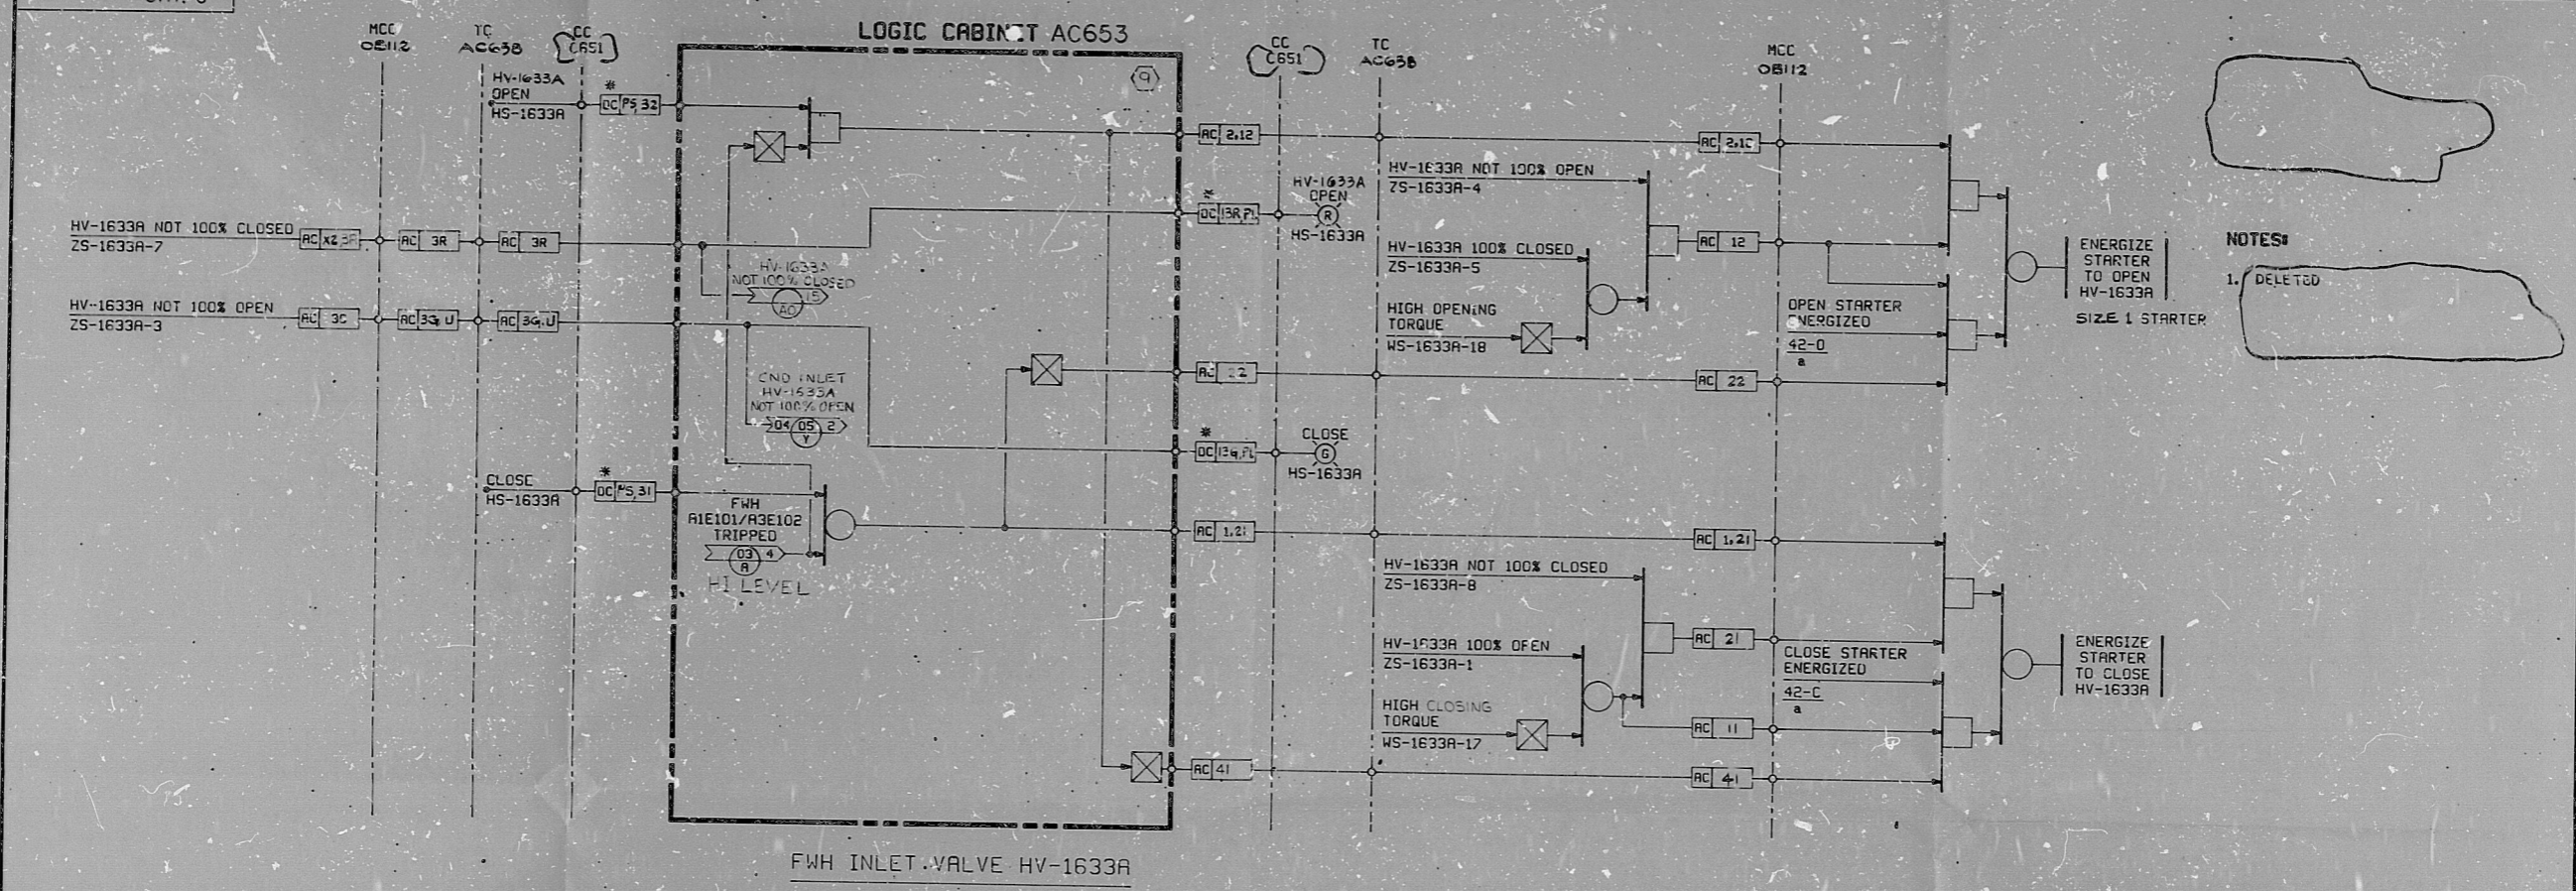


NOTES:
1. DELETED

CROSS REFERENCE TABLE

NO.	VALVE SERVICE	POSITION SWITCH (NOTE 1)	TORQUE SWITCH (NOTE 1)	HAND SWITCH	MCC	FWH TRIPPED		TERMINAL CABINET	LOGIC CABINET	CIRCUIT NO.	HAND SWITCH LAYOUT		
						ARROW CONT.	J-O3;ARROW/RIGHT. 4				MODULE	SECTION	
HV-1633A	FWH INLET	R1E101	ZS-1633A	WS-1633A	HS-1633A	08112	R3E102/R1E101	J-O3;ARROW/RIGHT. 4	AC658	AC653	9	H	3
HV-1633B	FWH INLET	B1E101	ZS-1633B	WS-1633B	HS-1633B	08141	B3E102/B1E101	J-O3;ARROW/RIGHT. 4	BC658	BC653	10	I	3
HV-1633C	FWH INLET	C1E101	ZS-1633C	WS-1633C	HS-1633C	08122	C3E102/C1E101	J-O3;ARROW/RIGHT. 4	CC658	CC653	11	J	3
HV-1620A	FWH OUTLET	A3E102	ZS-1620A	WS-1620A	HS-1620A	08112	R1E101/R3E102	J-O3;ARROW/RIGHT. 4	AC658	AC653	9	H	1
HV-1620B	FWH OUTLET	B3E102	ZS-1620B	WS-1620B	HS-1620B	08141	B1E101/B3E102	J-O3;ARROW/RIGHT. 4	BC658	BC653	10	I	1
HV-1620C	FWH OUTLET	C3E102	ZS-1620C	WS-1620C	HS-1620C	08122	C1E101/C3E102	J-O3;ARROW/RIGHT. 4	CC658	CC653	11	J	1

This drawing and the design it covers are the property of BECHTEL. They are hereby loaned and on the borrower's express agreement that they will not be reproduced, copied, loaned, simulated, nor used except in the limited way and private use permitted by any written consent given by the lender to the borrower.

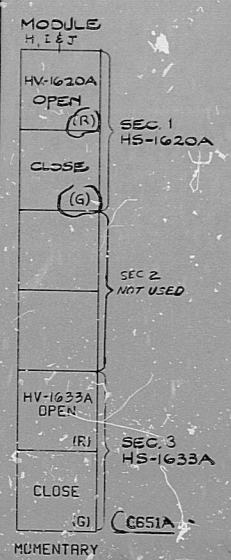

MUMENTARY

P.P.C. APERTURE CARD

NO.	DATE	REVISIONS	BY	CHKD	DESIGN	ENGR	PROJ	APPR
1	10/1/78	DESIGN FREEZE ISSUE						
2	10/2/78	REVISED BAILEY INTERFACE AS NOTED						
3	10/1/78	REVISED AS INDICATED						
4	10/1/78	REVISED AS INDICATED						
5	10/2/78	ISSUED FOR CONSTRUCTION						

BECHTEL
SAN FRANCISCO

PUBLIC SERVICE ELECTRIC AND GAS COMPANY
HOPE CREEK GENERATING STATION

LOGIC DIAGRAM
CONDENSATE SYSTEM

FWH #1 & 2 CND'S VALVES

JOB No.	DRAWING No.	REV.
10855	J-05-0 SHT. 8	4

S/U - AD

22 X 34 "D" SIZE

RIDS

8307270545

