


J-05-0 SHT. 12

This drawing and the design it covers are the property of BECHTEL. They are loaned and on the borrower's express agreement that they will not be reproduced, copied, loaned, exhibited, nor used except in the limited way and private use permitted by any written consent given by the lender to the borrower.

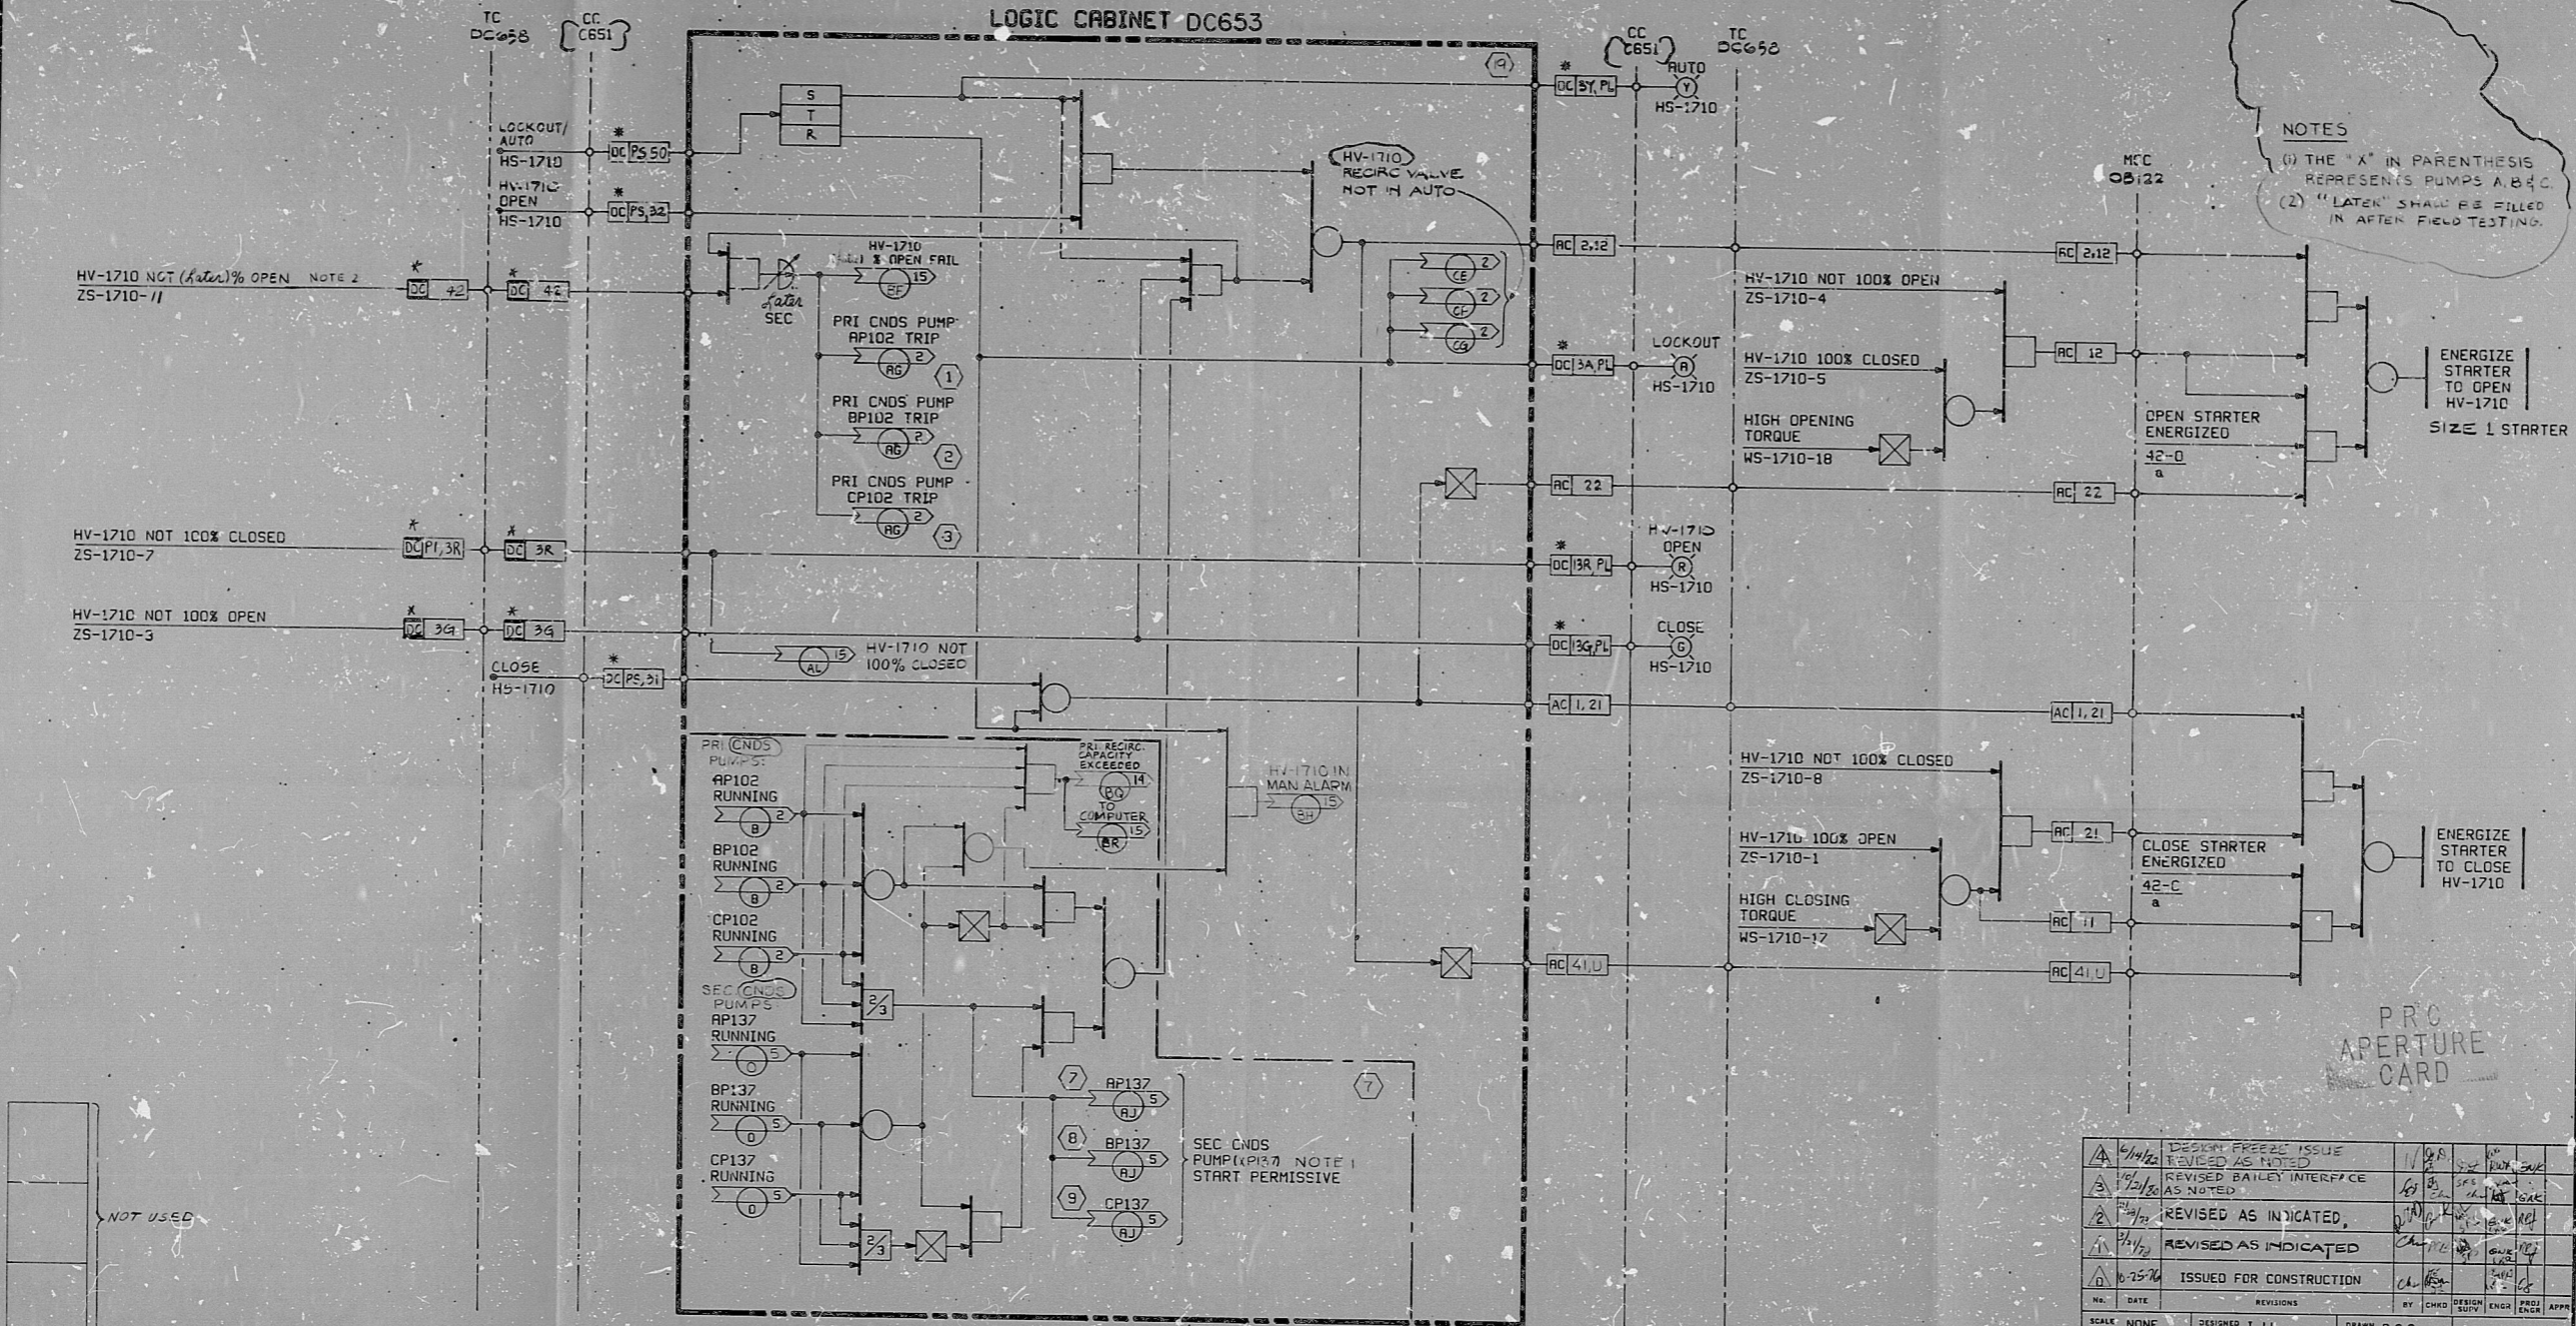

**NOTES**  
 (1) THE "X" IN PARENTHESIS REPRESENTS PUMPS A, B & C  
 (2) "LATEN" SHALL BE FILLED IN AFTER FIELD TESTING.

LOCKOUT (A)	
AUTO (Y)	
HV-1710 OPEN (R)	HV-1710
CLOSE (G)	CONTROL CONSOLE C651A
MOMENTARY	

6/14/74	DESIGN FREEZE ISSUE				
6/14/74	REVISED AS NOTED				
6/14/74	REVISED BAILEY INTERFACE AS NOTED				
6/14/74	REVISED AS INDICATED				
6/14/74	REVISED AS INDICATED				
6/25/74	ISSUED FOR CONSTRUCTION				
NO.	DATE	REVISIONS	BY	CHKD	DESIGN
SCALE	NONE	DESIGNED I.J.L.	DRAWN R.C.G.		

**BECHTEL**  
SAN FRANCISCO

PUBLIC SERVICE ELECTRIC AND GAS COMPANY  
**HOPE CREEK GENERATING STATION**

**LOGIC DIAGRAM  
CONDENSATE SYSTEM**

PRI CNDS PMP MIN FLOW RECIRC VALVE HV-1710

JOB No.	DRAWING No.	REV.
10855	J-05-0 SHT 12	4

S/U - AD

22 X 34 1/4" SIZE

RIDS

8307270549

