



J-05-0 SHT. 13

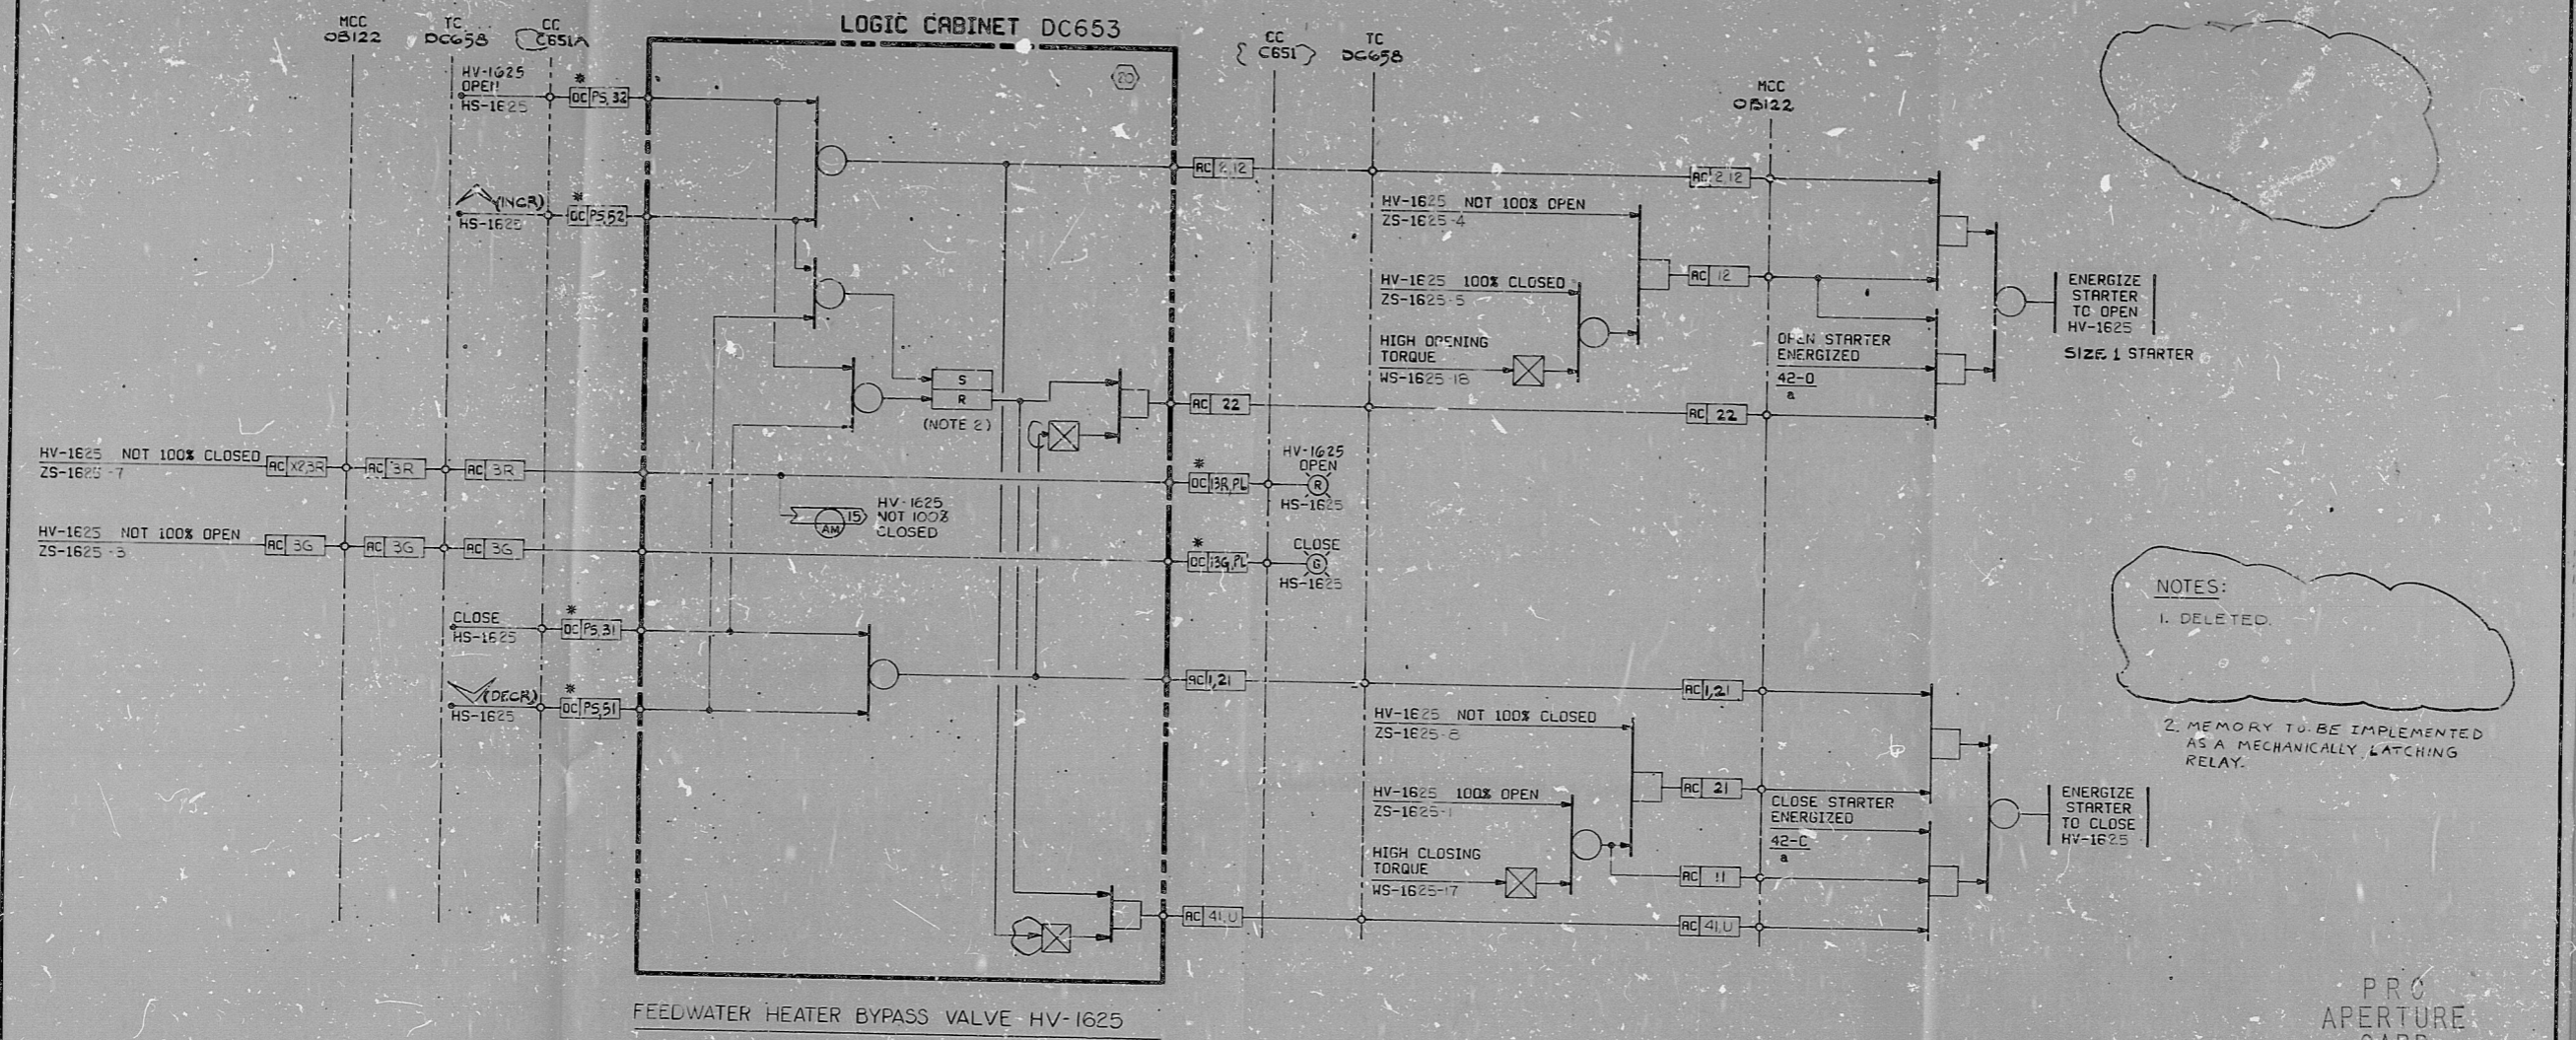

FEEDWATER HEATER BYPASS VALVE HV-1625

NOTES:  
 1. DELETED.  
 2. MEMORY TO BE IMPLEMENTED AS A MECHANICALLY LATCHING RELAY.

PRO APERTURE CARD

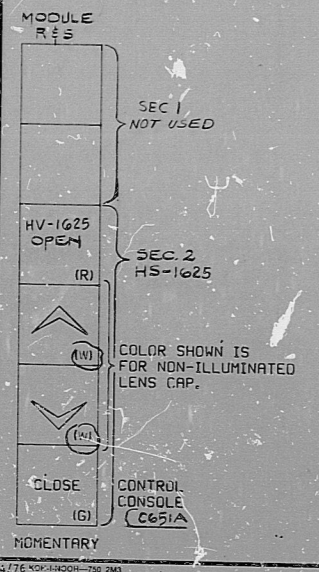

CROSS REFERENCE TABLE

VALVE NO.	FEEDWATER HEATERS BYPASSED	HAND SWITCH	POSITION SWITCH (NOTE-1)	TORQUE SWITCH (NOTE-1)	MCC	TC	CIRCUIT NO.	LOGIC CABINET	HAND SWITCH LAYOUT MODULE SECTION
HV-1625	NOS 1 & 2	HS-1625	ZS-1625	WS-1625	OB122	DC658	20	DC653	R 2
HV-1623	NOS 3, 4 & 5	HS-1623	ZS-1623	WS-1623	OB132	DC658	21	DC653	S 2

NO.	DATE	BY	CHKD	DESIGN	ENGR	PROJ	APPR
1	6/14/62						
2	7/14/62						
3	11/14/62						
4	10/25/62						

SCALE: NINE

DESIGNED: I.J.L. DRAWN: R.C.G.

**BECHTEL**  
 SAN FRANCISCO

PUBLIC SERVICE ELECTRIC AND GAS COMPANY  
 HOPE CREEK GENERATING STATION

LOGIC DIAGRAM  
 CONDENSATE SYSTEM  
 FEEDWATER HEATER BYPASS VALVES

JOB No.	DRAWING No.	REV.
10855	J-05-0 SHT 13	4

S/U - AD

22 X 34 "D" SIZE

RIDS

83072J0550

