



J-05-0 SHT 17

This drawing and the design it covers are the property of BECHTEL. They are merely loaned and on the borrower's express agreement that they will not be reproduced, copied, loaned, exhibited, nor used except in the limited way and private use permitted by any written consent given by the lender to the borrower.

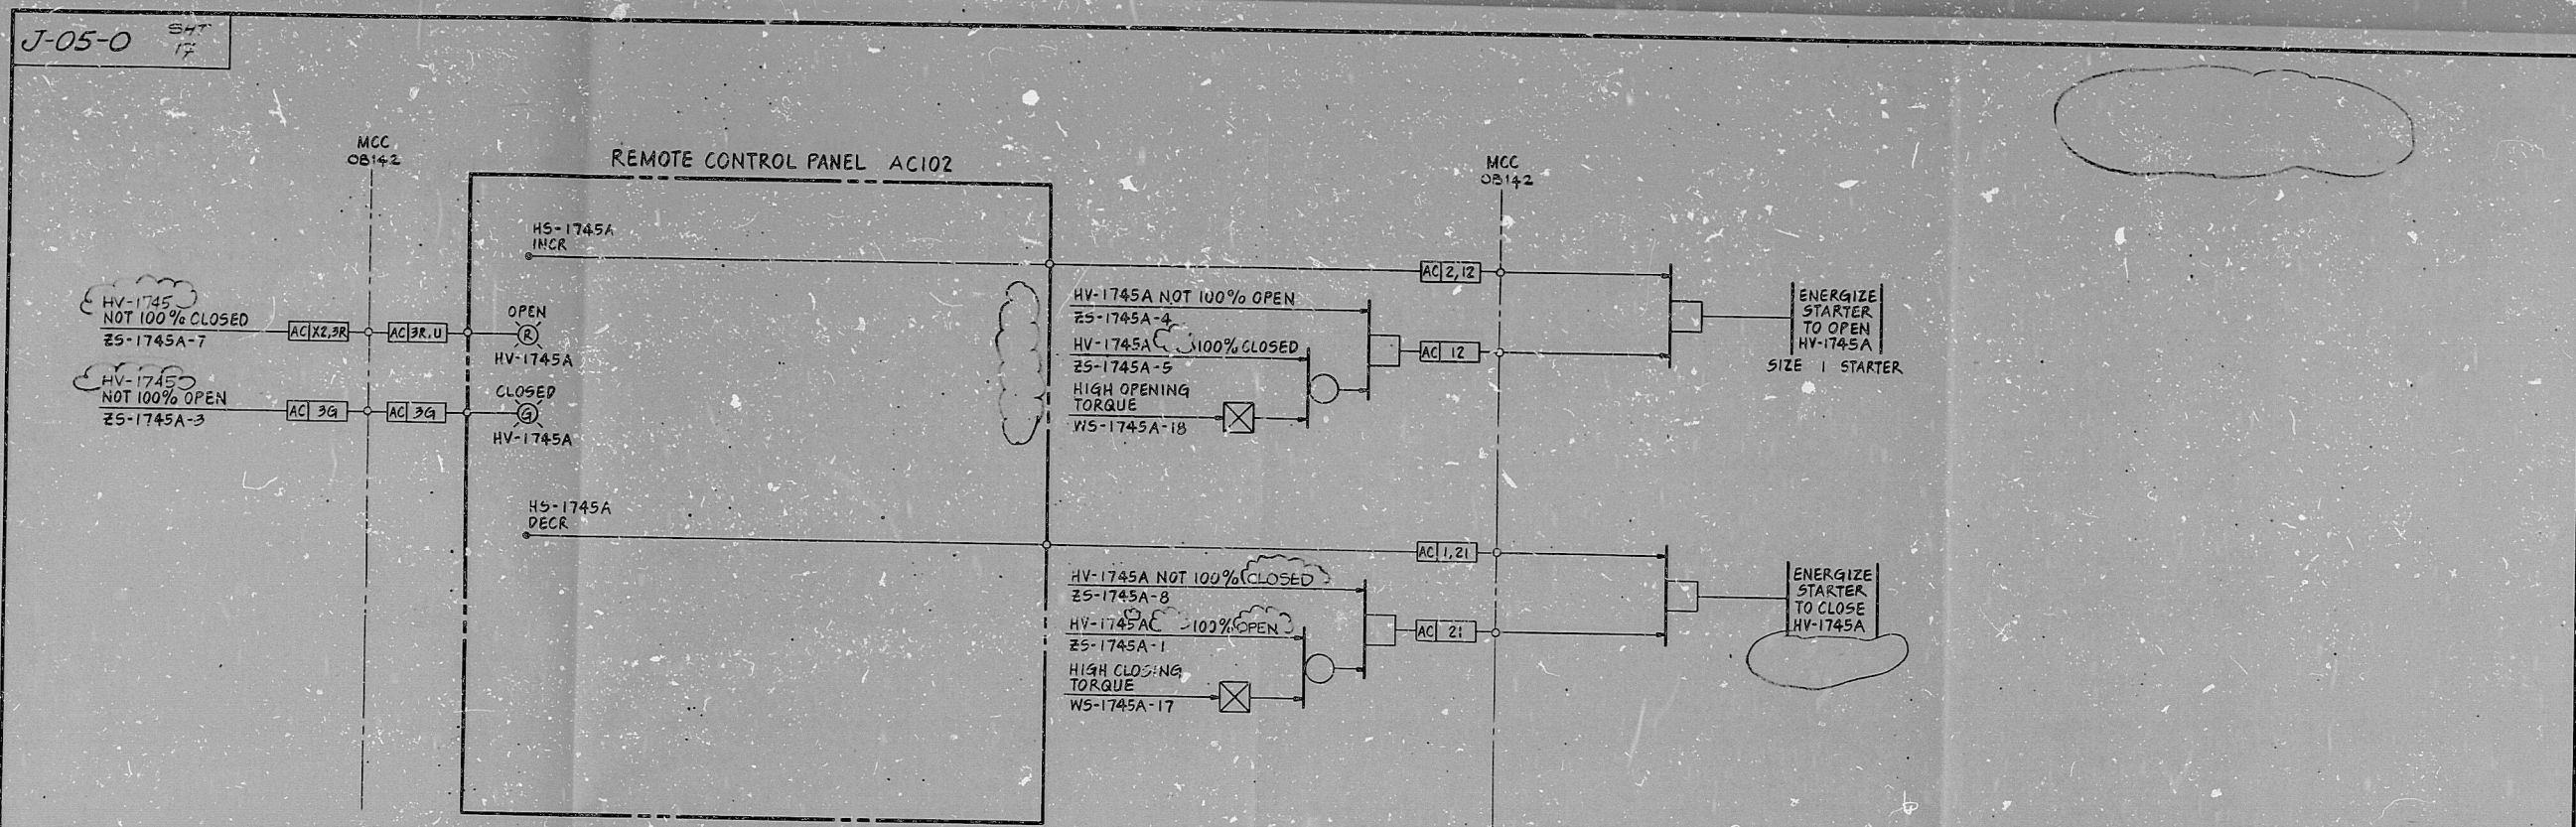

FWH BYPASS VALVE HV-1745A

FUNCTION, BYPASS FWH OUTLET VALVE	CONTROL SWITCH	VALVE NO	RCP	MCC	CIRCUIT NO.
BYPASS V FWH 5A	HS-1745A	HV-1745A	AC102	10B142	24
5B	5B	5B	B	10B123	25
5C	5C	5C	C	10B132	26
2A	6A	6A	A	10B142	27
2B	6B	6B	B	10B123	28
2C	6C	6C	C	10B132	29

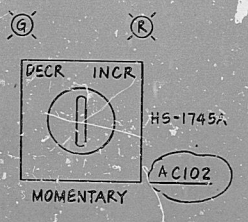

PRC APERTURE CARD

△									
△									
△	1/14/78	DESIGN FREEZE ISSUE REVISED AS NOTED	TY	25A	25B	25C	25D	25E	25F
△	1/17/78	ISSUED FOR CONSTRUCTION	WJ	10B	10C	10D	10E	10F	10G
No.	DATE	REVISIONS	BY	CHKD	DESIGN SUPP	ENGR	DRWG	APPR	
SCALE	NONE	DESIGNED	RCD	DRAWN	WL				
BECHTEL SAN FRANCISCO									
PUBLIC SERVICE ELECTRIC AND GAS COMPANY NOPE CREEK GENERATING STATION									
LOGIC DIAGRAM CONDENSATE SYSTEM FWH BYPASS VALVE									
JOB No.			DRAWING No.			REV.			
10855			J-05-0 SHT 17			1			

S/U-AD

22 x 34 1/2" SIZE

RIDS

8307270554

