
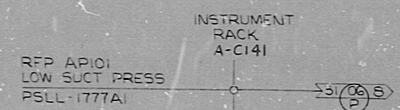


J-06-0 SHT. 6

This drawing and the design it covers are the property of BECHTEL. They are hereby loaned to the borrower's express agreement that they will not be reproduced, copied, loaned, exhibited, or used except in the limited way and under the conditions set forth in the loan agreement given to the borrower.

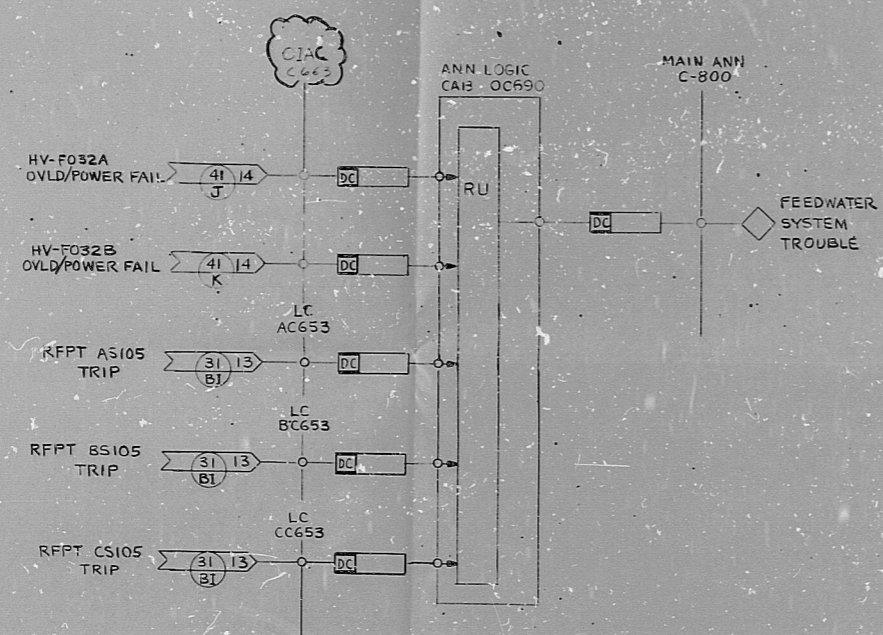

TRIP INTERLOCKS

PRESSURE SWITCH	SERVICE	INSTRUMENT RACK	ARROW LETTER	ARROW DWG. SHT.
PSLL-1777A1	LOW AP101 SUCT. PRESS. TRIP	AC141	F	J-31 8
PSLL-1777A2	LOW AP101 SUCT. PRESS. TRIP		Q	J-31 8
PSLL-1777A3	LOW AP101 SUCT. PRESS. TRIP		R	J-31 8
PSLL-1777B1	LOW BP101 SUCT. PRESS. TRIP	BC141	S	J-31 8
PSLL-1777B2	LOW BP101 SUCT. PRESS. TRIP		T	J-31 8
PSLL-1777B3	LOW BP101 SUCT. PRESS. TRIP		U	J-31 8
PSLL-1777C1	LOW CP101 SUCT. PRESS. TRIP	CC 141	V	J-31 8
PSLL-1777C2	LOW CP101 SUCT. PRESS. TRIP		W	J-31 8
PSLL-1777C3	LOW CP101 SUCT. PRESS. TRIP		X	J-31 8
PSHH-1788-1	HIGH FEED PUMP DISCH. PRESS.	OC 130	Y	J-31 7
PSHH-1788-2	HIGH FEED PUMP DISCH. PRESS.		Z	J-31 7
PSHH-1788-3	HIGH FEED PUMP DISCH. PRESS.		AA	J-31 7

NOTES:

1. THE LOGIC CABINET OUTPUT DRIVER CONTACTS SHALL BE NORMALLY OPEN, CLOSE TO ALARM.

PRO APERTURE CARD

NO.	DATE	REVISIONS	BY	CHKD	DESIGN SUPV.	ENGR	PROJ ENGR	APPR
1	4/1/72	DESIGN FREEZE ISSUE	JAV	RCG	RCG	RCG	RCG	RCG
2	4/1/72	REVISED AS SHOWN	JAV	RCG	RCG	RCG	RCG	RCG
3	4/1/72	REVISED BAILEY INTERFACE AS NOTED	JAV	RCG	RCG	RCG	RCG	RCG
4	4/1/72	REVISED AS NOTED	JAV	RCG	RCG	RCG	RCG	RCG
5	4/1/72	REVISED AS NOTED	JAV	RCG	RCG	RCG	RCG	RCG
6	4/1/72	ISSUED FOR CONSTRUCTION	JAV	RCG	RCG	RCG	RCG	RCG

SCALE: NONE

DESIGNED: JAV

DRAWN: RCG

**BECHTEL**  
SAN FRANCISCO

PUBLIC SERVICE ELECTRIC AND GAS COMPANY  
NOPE CREEK GENERATING STATION

**LOGIC DIAGRAM**  
**FEEDWATER SYSTEM**  
ALARMS/RFPT TRIP INTERLOCKS

JOB No.	DRAWING No.	REV.
10855	J-06-0	SHT 6 4

S/U - RK, RE

RIDS

8307270561

