



J-06-0 SHT. 8

THIS DRAWING AND THE DESIGN IT COVERS ARE THE PROPERTY OF BECHTEL. THEY ARE HEREBY LOANED TO THE BORROWER'S EXPRESS AGREEMENT THAT THEY WILL NOT BE REPRODUCED, COPIED, LOANED, EXHIBITED, NOR USED EXCEPT IN THE MANNER AND FOR THE PURPOSES SPECIFIED BY THE BORROWER.

REMOTE CONTROL PANEL AC102

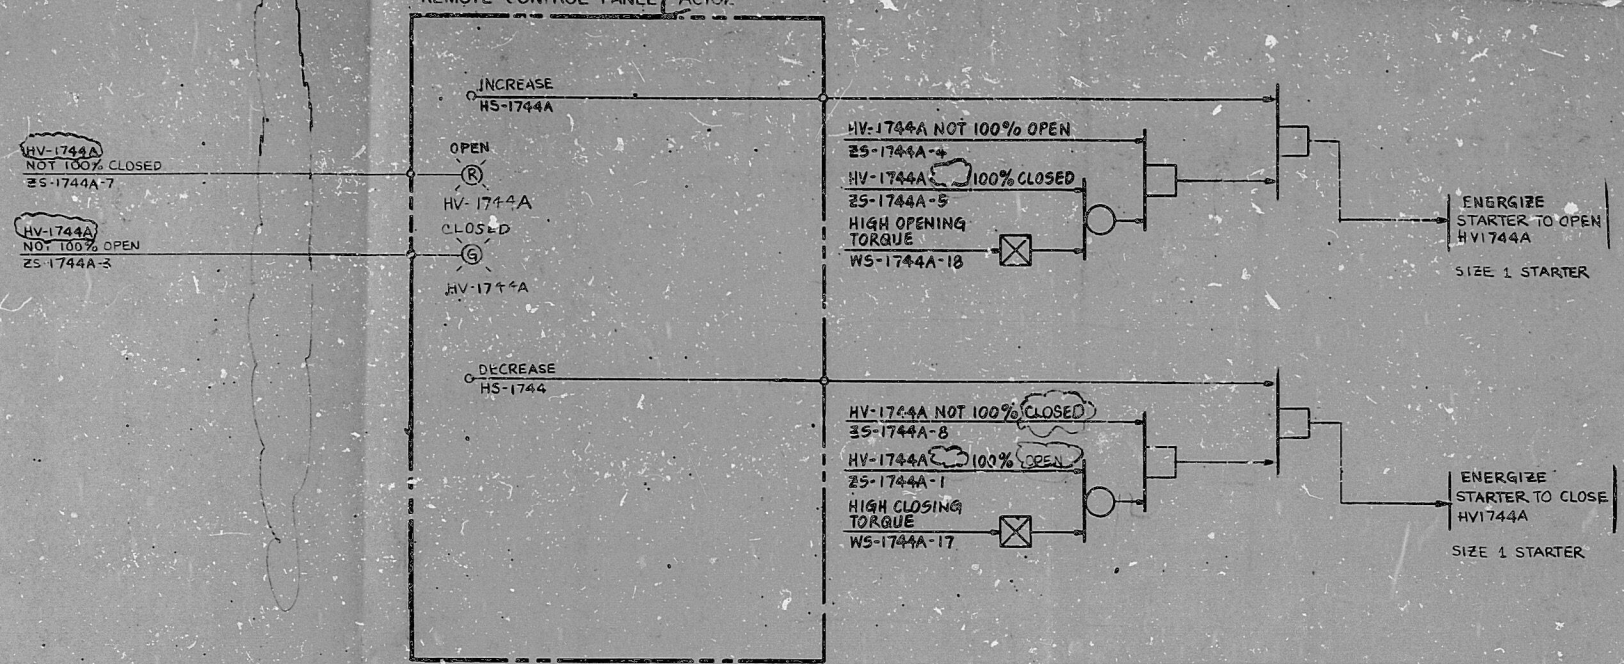

FWB BYPASS VALVE HV-1744A

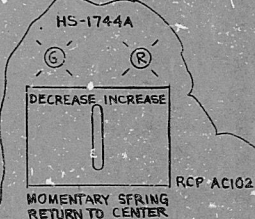

CROSS REFERENCE TABLE

VALVE	APPLICATION	POSITION SWITCH	TORQUE SWITCH	HAND SWITCH	PANEL	CIRCUIT NO.
HV-1744A	FEEDWATER HTR AE 106 OUTLET VALVE BYPASS	ZS-1744A	WS-1744A	HS-1744A	AC102	18
HV-1744B	FEEDWATER HTR BE 106 OUTLET VALVE BYPASS	ZS-1744B	WS-1744B	HS-1744B	BC102	19
HV-1744C	FEEDWATER HTR CE 106 OUTLET VALVE BYPASS	ZS-1744C	WS-1744C	HS-1744C	CC102	20

PRC APERTURE CARD

DESIGNED	DRAWN	CHECKED	APPROVED
NONE	WL		
BECHTEL SAN FRANCISCO			
PUBLIC SERVICE ELECTRIC AND GAS COMPANY HOPE CREEK GENERATING STATION			
LOGIC DIAGRAM FEEDWATER SYSTEM FWB BYPASS VALVE			
JOB NO.	DRAWING NO.	REV.	
10055	J-06-0 SHT. 8	1	

S/U-AD, AE

RIDS

830770563

