


D1 UNLESS OTHERWISE INDICATED
 DIV. 1

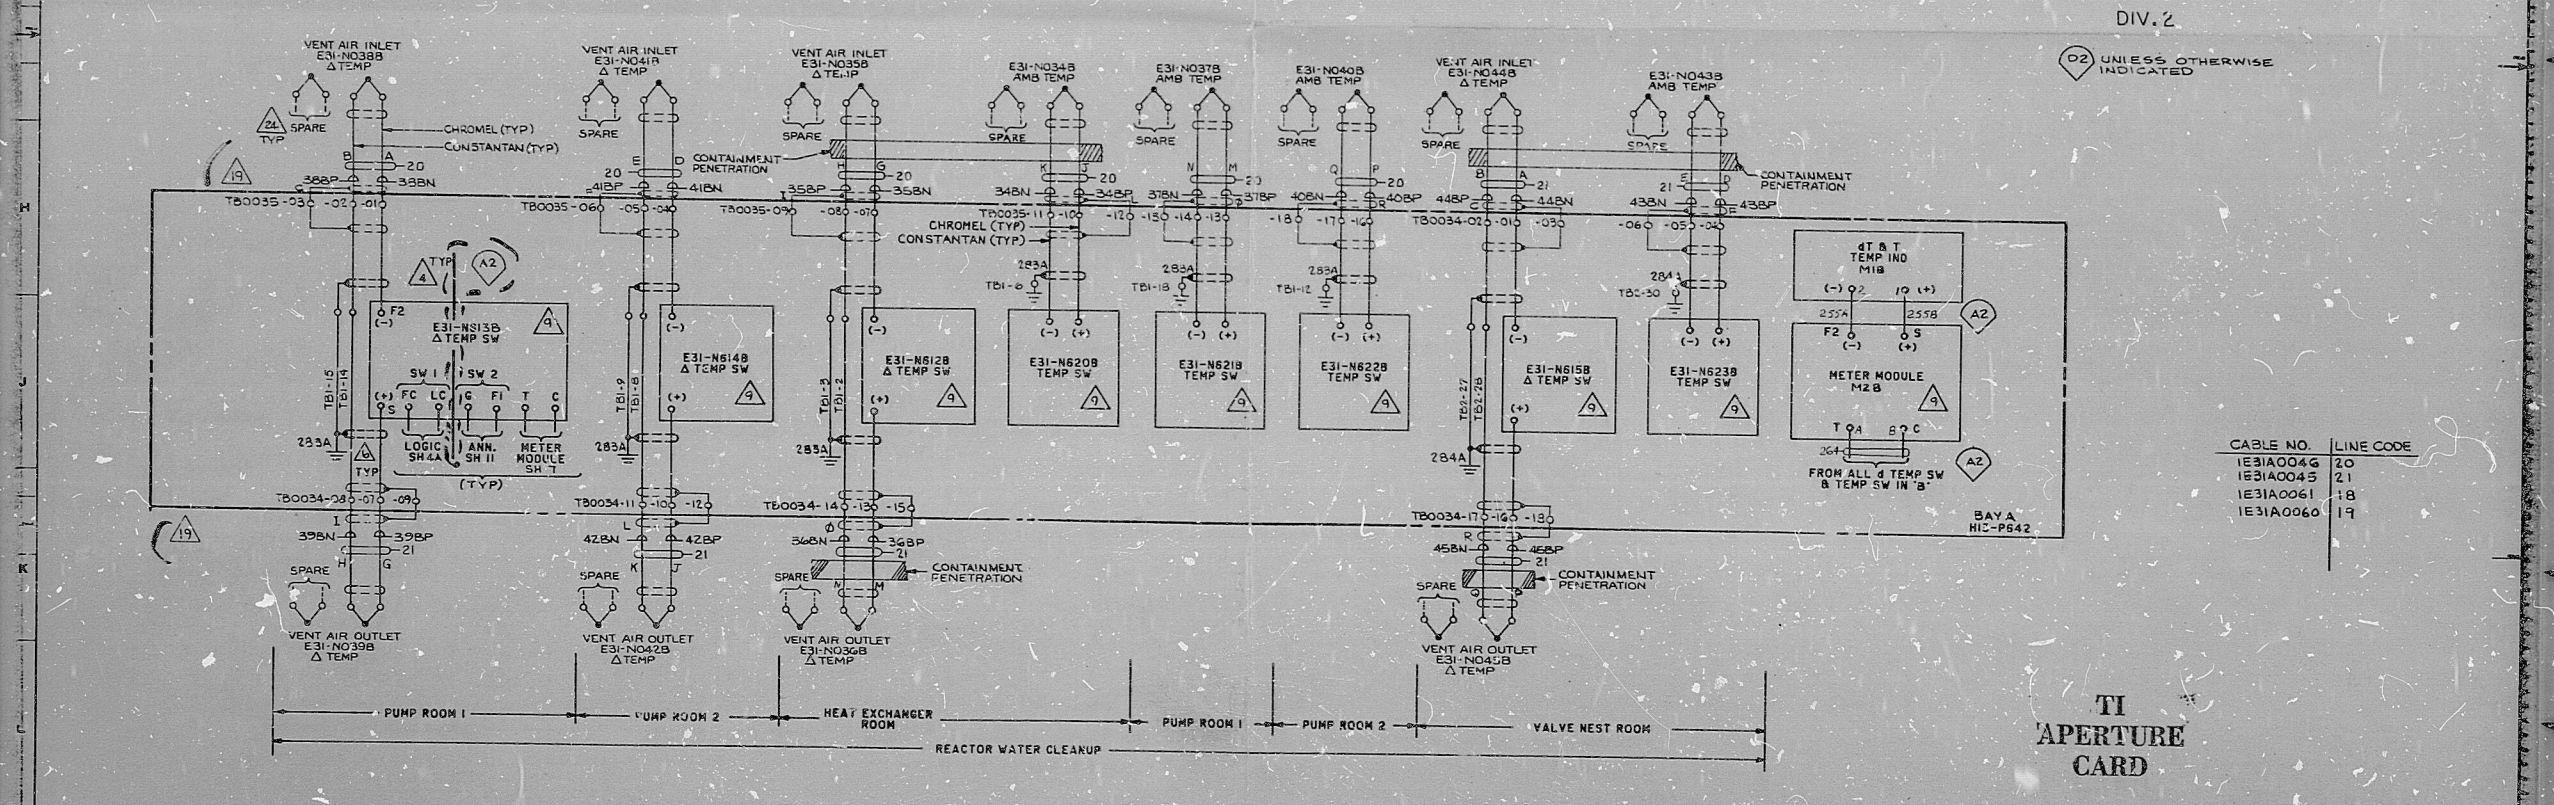

D2 UNLESS OTHERWISE INDICATED
 DIV. 2

CABLE NO.	LINE CODE
IE31A0046	20
IE31A0045	21
IE31A0061	18
IE31A0060	19

TI APERTURE CARD

LINE CODES: 18-21, 284, 285, 283, 286

NO.	DESCRIPTION	DATE	BY
3	NJ18389	11-2-77	CJ
12	NJ53065	11-2-77	CJ

85E1602AA
 SAN JOSE
 V. BURT

8412190105

PDR RIDS

