


UNLESS OTHERWISE INDICATED
 DIV. 1

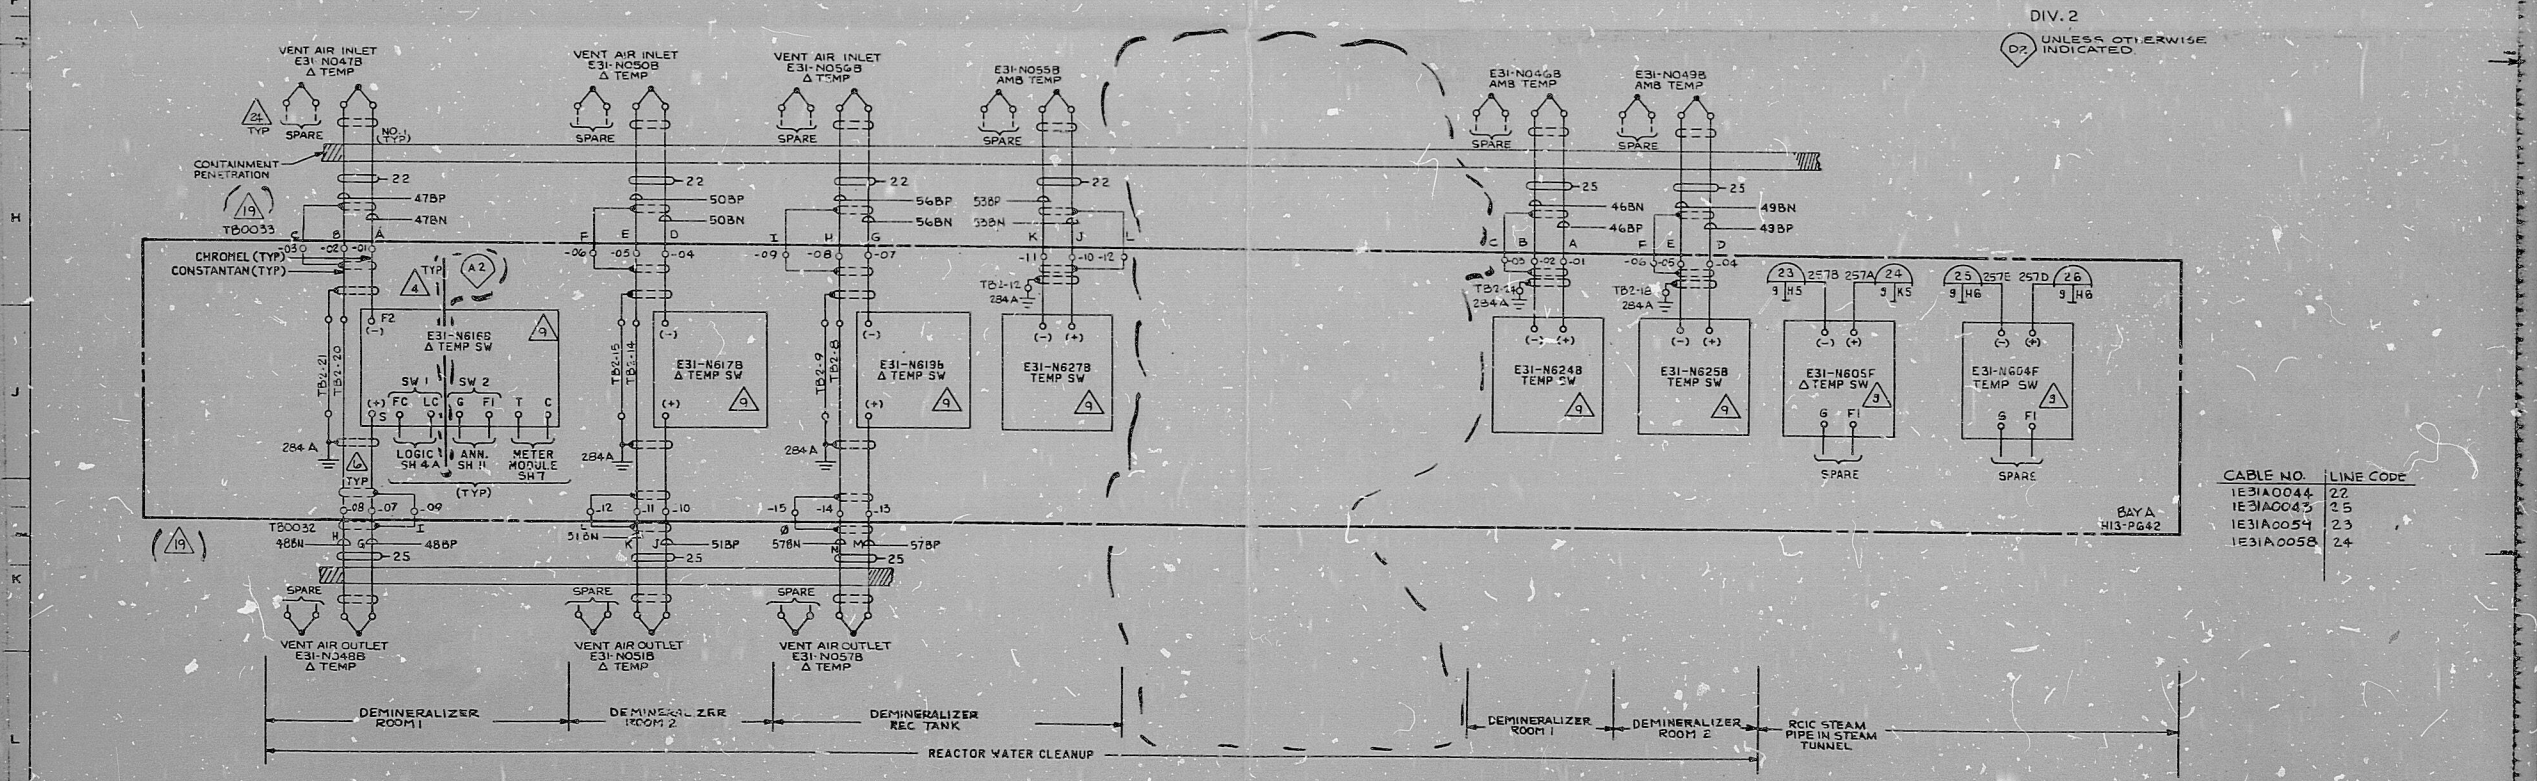

UNLESS OTHERWISE INDICATED
 DIV. 2

CABLE NO.	LINE CODE
1E31A0044	22
1E31A0045	25
1E31A0054	23
1E31A0058	24

TI
 APERTURE
 CARD

LINE CODES: 22-25
 256, 257

NO.	DESCRIPTION	QUANTITY	UNIT
12	NJ53465	3	PCB
3	NJ16849	1	PCB
5	NJ25566	1	PCB
7	NJ35704	1	PCB

851E602AA
 12 CIND BY V.BURT
 18 18

66 11

66 11

66 5.8

8.9"

11"

17"

66 11

66 11

66 5.8

8.5"

11"

17"

8412190108

PDR RIDS

