


J-07-0 SHT. 9

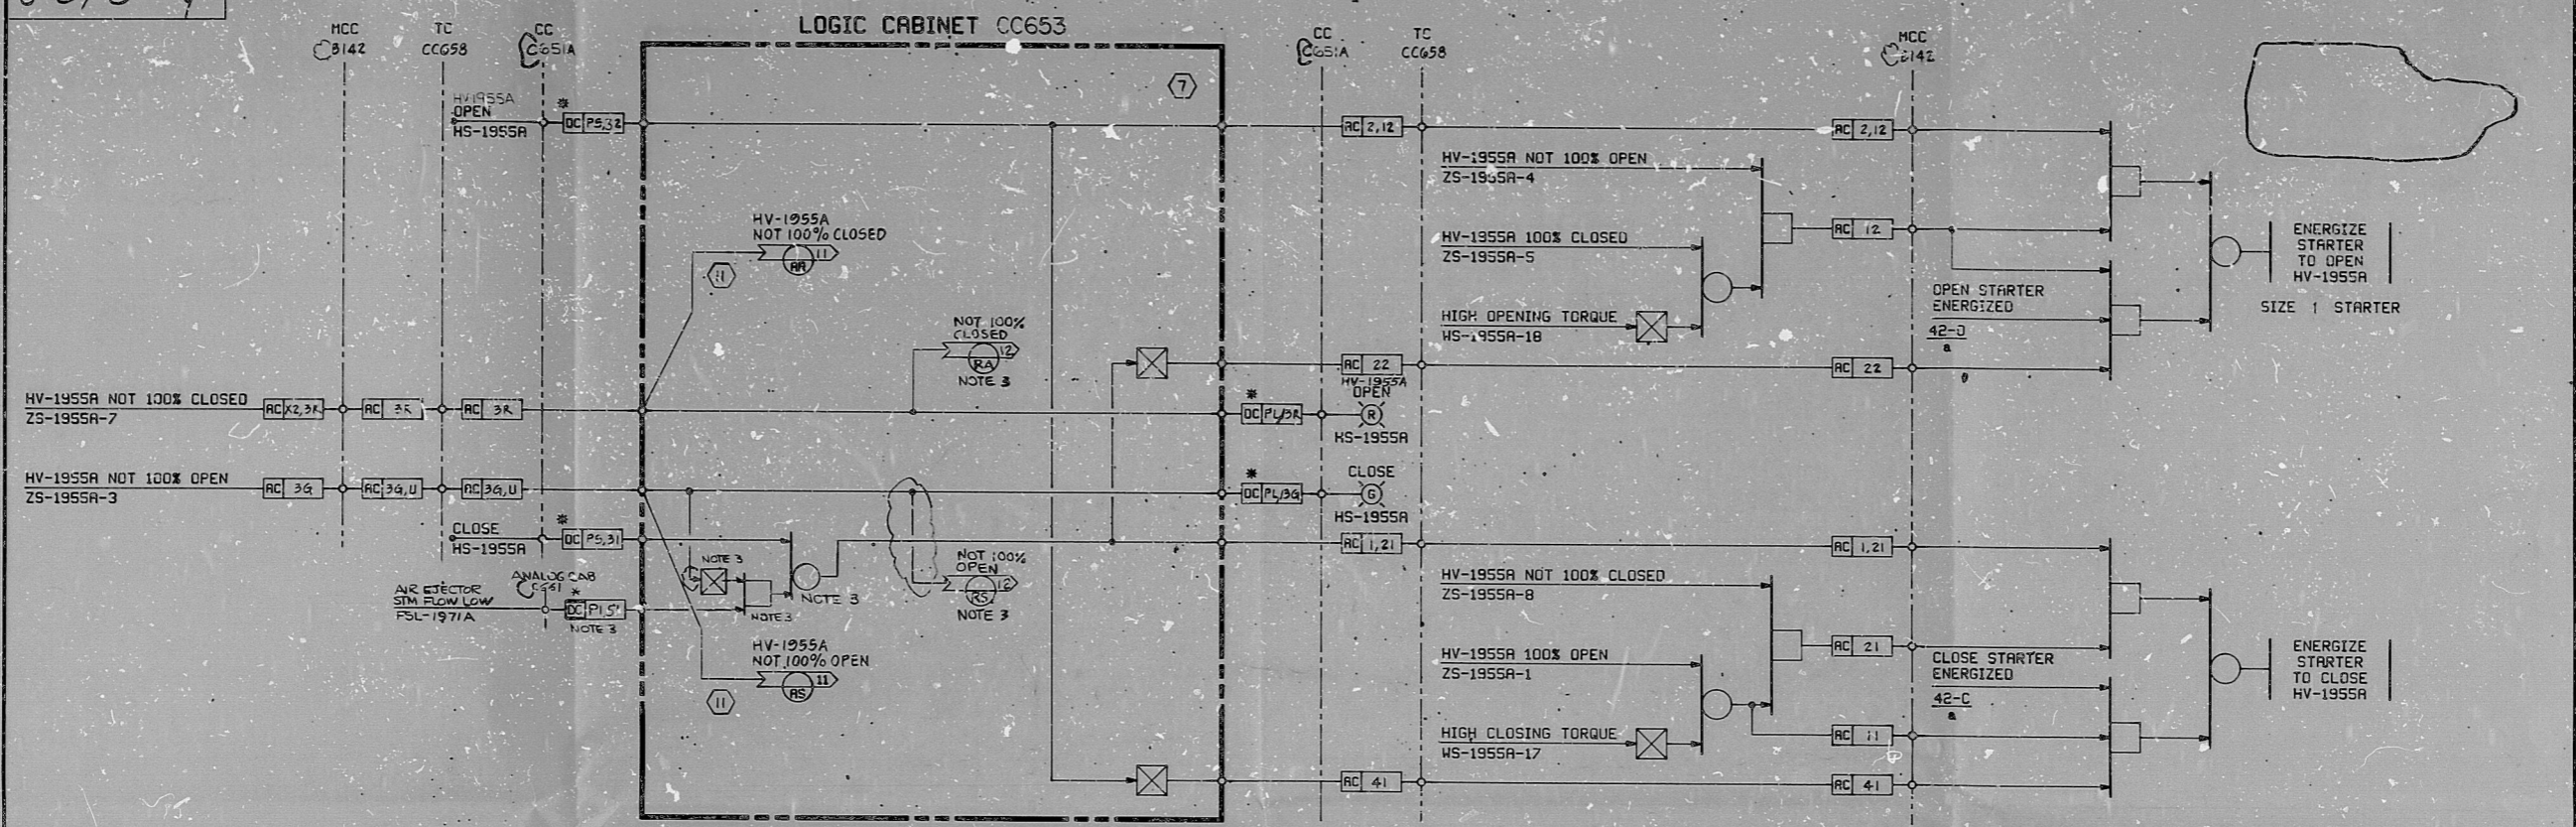


A-EJECTOR 3RD STAGE JET STEAM SUPPLY HV-1955A

- NOTES:
1. DELETED
  2. HV-2016A & HV-2016B ARE IN S/U SYSTEM AB; ALL OTHERS ON THIS SHEET ARE IN S/U SYSTEM CG.
  3. APPLIES TO HV-2016A & B ONLY.

PRO APERTURE CARD

CROSS REFERENCE TABLE

VALVE	HAND SWITCH	POSITION SWITCH (NOTE 1)	TURQUE SWITCH (NOTE 1)	AR/RS ARROWS	TC	MCC	CIRCUIT NUMBER	LOW FLOW SW	VALVE SERVICE	LOGIC CAB	HAND SWITCH LAYOUT	MODULE	SECTION	SHT
HV-1955A	HS-1955A	ZS-1955A	WS-1955A	SHT 11	CC658	Q142	7	N/A	A-EJECTOR 3RD STAGE JET STEAM SUPPLY	CC653	C	2	8	
HV-1955B	HS-1955B	ZS-1955B	WS-1955B	SHT 11	CC658	Q123	8	N/A	B-EJECTOR 3RD STAGE JET STEAM SUPPLY	CC653	D	2	8	
HV-1963A	HS-1963A	ZS-1963A	WS-1963A	N/A	CC658	Q142	7	N/A	A-EJECTOR 2ND STAGE JET STEAM SUPPLY	CC653	E	2	9	
HV-1963B	HS-1963B	ZS-1963B	WS-1963B	N/A	CC658	Q123	8	N/A	B-EJECTOR 2ND STAGE JET STEAM SUPPLY	CC653	F	2	9	
HV-1967A	HS-1967A	ZS-1967A	WS-1967A	N/A	CC658	Q142	7	N/A	A-EJECTOR 1ST STAGE JET STEAM SUPPLY	CC653	A	2	6	
HV-1967B	HS-1967B	ZS-1967B	WS-1967B	N/A	CC658	Q123	8	N/A	B-EJECTOR 1ST STAGE JET STEAM SUPPLY	CC653	B	2	6	
HV-1959A	HS-1959A	ZS-1959A	WS-1959A	N/A	CC658	Q142	7	N/A	A-EJECTOR INTER CONDENSER DRAIN	CC653	A	1	6	
HV-1959B	HS-1959B	ZS-1959B	WS-1959B	N/A	CC658	Q123	8	N/A	B-EJECTOR INTER CONDENSER DRAIN	CC653	B	1	6	
HV-2016A	HS-2016A	ZS-2016A	WS-2016A	SHT 12	CC658	Q142	7	FSL-1971A	A-EJECTOR MAIN STEAM SUPPLY SHUT OFF	CC653	G	2	9	
HV-2016B	HS-2016B	ZS-2016B	WS-2016B	SHT 12	CC658	Q123	8	FSL-1971B	B-EJECTOR MAIN STEAM SUPPLY SHUT OFF	CC653	G	3	9	

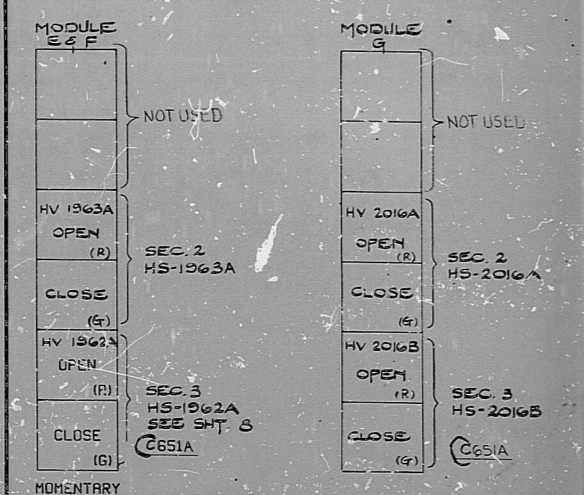

NO.	DATE	REVISIONS	BY	CHKD	DESIGN	ENGR	PROJ	APPR
1	11/12	DESIGN FREEZE ISSUE REVISED AS NOTED	...	...	...	...	...	...
2	11/13	REVISED AS NOTED	...	...	...	...	...	...
3	11/17	REVISED AS NOTED	...	...	...	...	...	...
4	11/18	REVISED AS NOTED	...	...	...	...	...	...
5	11/18	REVISED AS NOTED	...	...	...	...	...	...
6	11/17	ISSUED FOR CONSTRUCTION	...	...	...	...	...	...

SCALE: NONE

DESIGNED: C.H.S. DRAWN: R.C.G.

**BECHTEL**  
SAN FRANCISCO

PUBLIC SERVICE ELECTRIC AND GAS COMPANY  
HOPE CREEK GENERATING STATION

LOGIC DIAGRAM  
CONDENSER AIR REMOVAL SYSTEM  
MISCELLANEOUS VALVES

JOB No.	DRAWING No.	REV.
10855	J-07-0 SHT 9	5

S/U - CG AB

RIDS

8307270572

