



J-07-0 SH 11

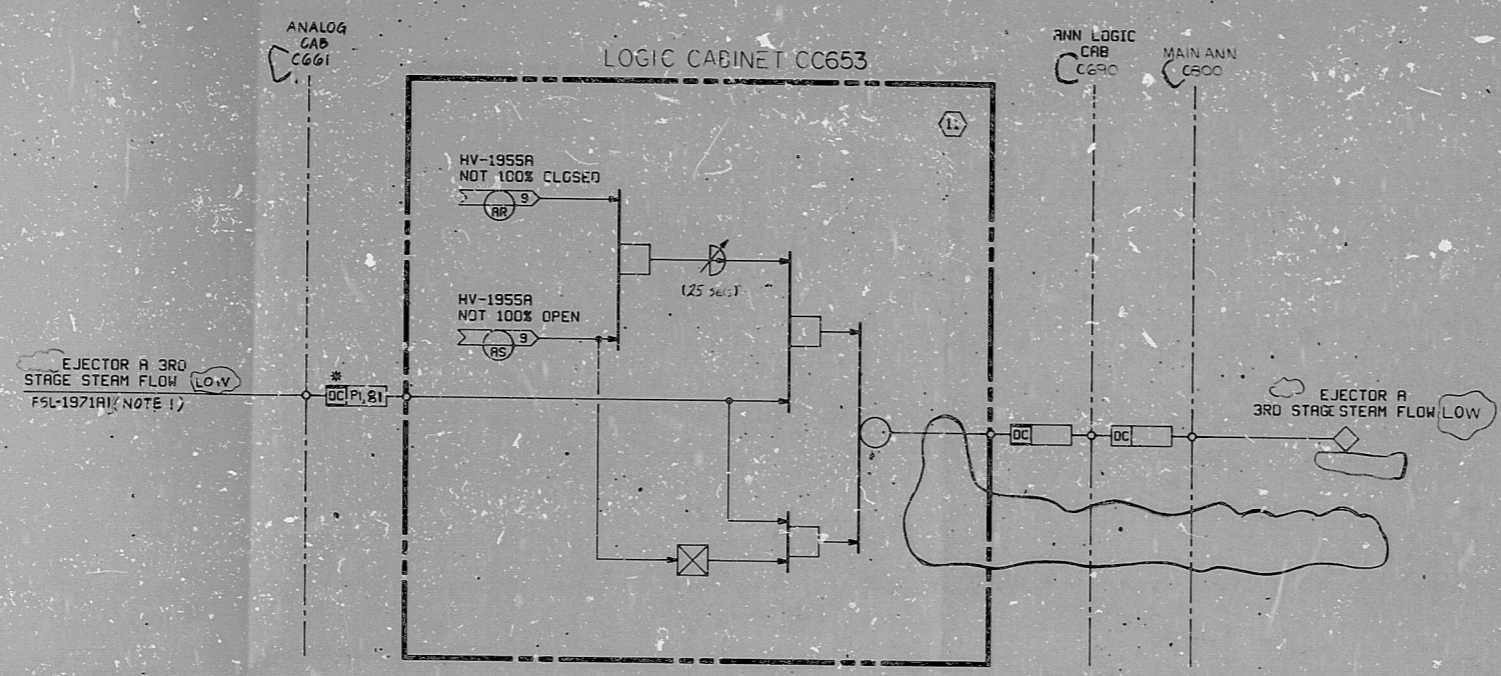

3 RD STAGE STEAM FLOW ALARM

AIR EJECTOR	LOW FLOW SWITCH	HAND VALVE	CIRCUIT NUMBER	ANALOG CAB	LOGIC CAB
A	FSL-1971A	HV-1955A	11	C661	CC653
B	FSL-1971B	HV-1955B	12	C661	CC653

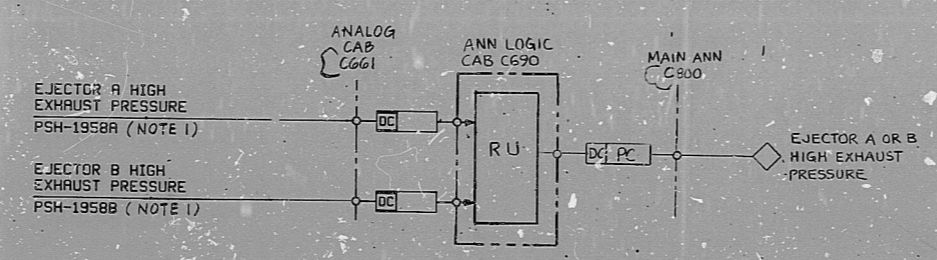

NOTES:  
 1. CONTACTS OPEN ON CONDITIONS STATED.  
 2. DELETED

PRC APERTURE CARD

NO.	DATE	REVISIONS	BY	CHKD	DESIGN	ENGR	PROJ	APPR
1	1/14/62	DESIGN FREEZE ISSUE REVISED AS NOTED	SV	SA	SA	SA	SA	SA
2	1/15/62	REVISED SWITCH INTERFACE AS NOTED	SA	SA	SA	SA	SA	SA
3	1/24/62	REVISED AS NOTED	SA	SA	SA	SA	SA	SA
4	1/24/62	ISSUED FOR CONSTRUCTION	SA	SA	SA	SA	SA	SA

SCALE: NONE    DESIGNED: C.H.S.    DRAWN: RCG

**BECHTEL**  
 SAN FRANCISCO

PUBLIC SERVICE ELECTRIC AND GAS COMPANY  
 HOPE CREEK GENERATING STATION

LOGIC DIAGRAM  
 AIR REMOVAL SYSTEM  
 ALARMS

JOB No.	DRAWING No.	REV.
10855	J-07-0 SH 11	3

S/U - CG

This drawing and the design it covers are the property of BECHTEL. They are made based and on the drawings, designs, specifications and data furnished by the owner to the contractor. They are not to be reproduced, copied, loaned, exhibited, nor used except in the limited way and private use permitted by any written consent given by the owner to the contractor.

4/76 HOPE-NDR-175-202

17 X 34 "D" SIZE



RIDS

8307270574

