



M-459 SH1B

SIZE D

This drawing and all design it contains are the property of BENTON. They are hereby loaned to you for the purpose of design. They are not to be reproduced, copied, loaned, modified, or used in any way without the written consent of BENTON.

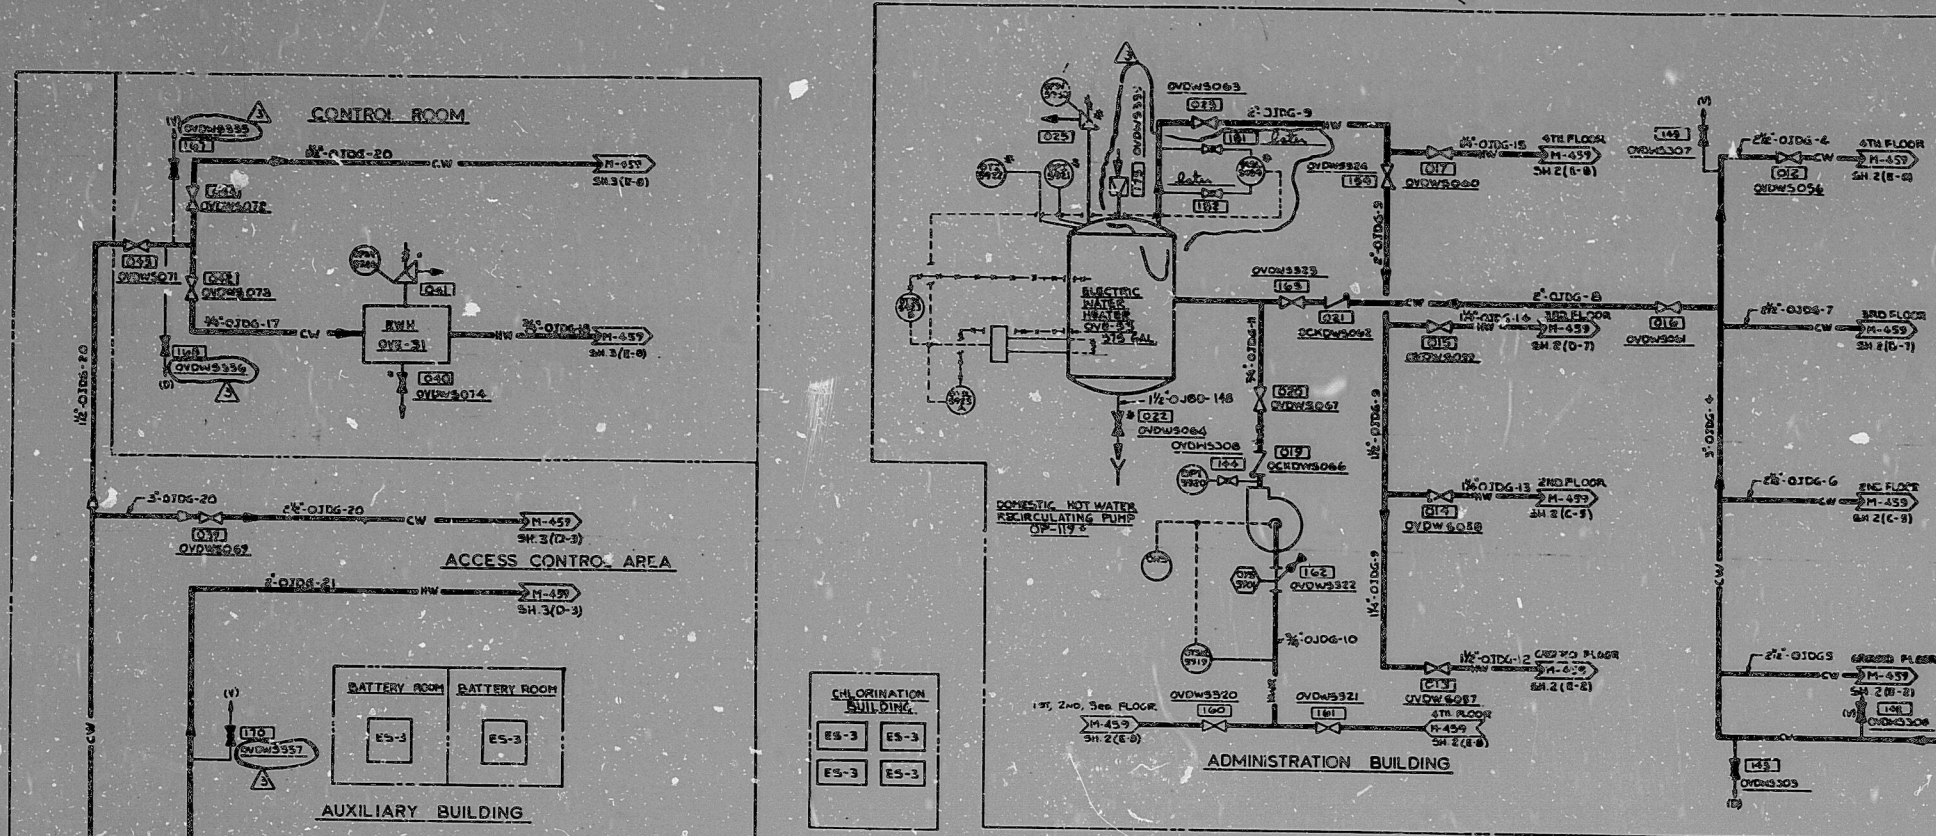

POOR ORIGINAL

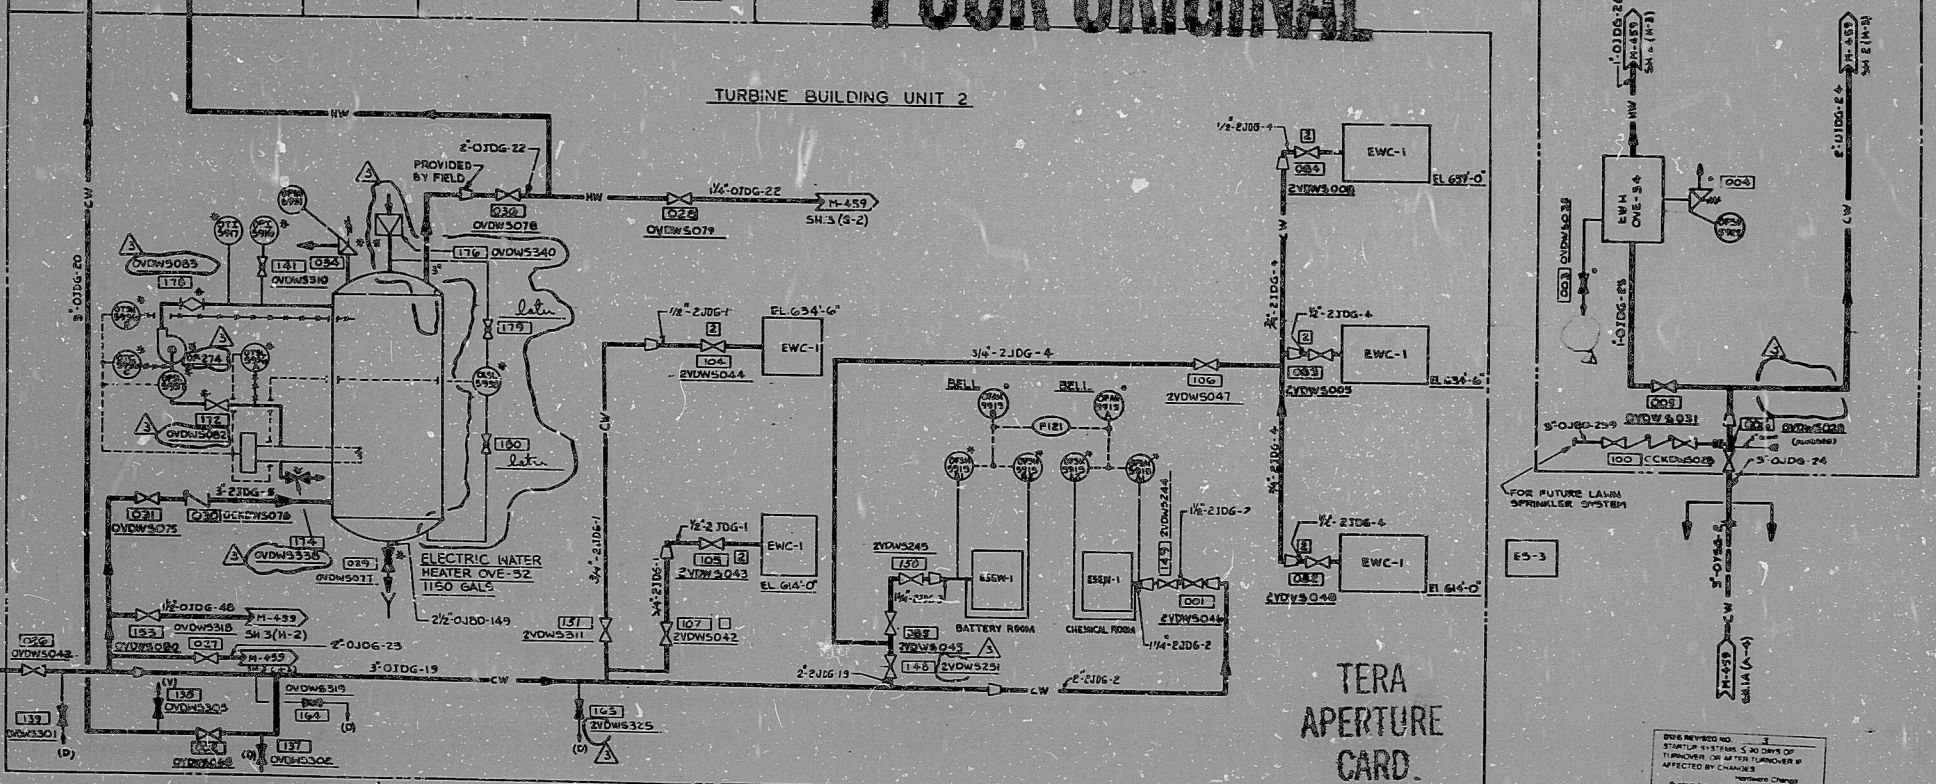

TERA APERTURE CARD.

30X

any that the image contained on this page was made in the normal and regular course of business on the date stated above and that it is an accurate reproduction of the document submitted to the undersigned.

- CW - DOMESTIC COLD WATER
 - HW - DOMESTIC HOT WATER SUPPLY
 - RHW - DOMESTIC HOT WATER RETURN
 - EWH - ELECTRIC WATER HEATER
 - YARD PIPING
- LEGEND:
- ESW-1 - EMERGENCY DRAIN SHOWER AND EYEWASH UNIT
 - ES-3 - EYE/FACE/HEAD SPRAY UNIT (PORTABLE TRAY)
 - EWC-1 - ELECTRIC WATER COOLER-1 (WALL MOUNTED)
- NOTES:
- A FOR FUTURE DETAILS REFER TO SPECIFICATION 722C-4-340
 - B ISOLATION VALVES IN EACH AREA SHALL BE ACCESSIBLE FOR MAINTENANCE
 - C LOCKS KEY HANDLE STOP VALVE
 - D EXISTING VALVE

NO.	DATE	BY	CHKD.	DESCRIPTION
1				ISSUED FOR CONSTRUCTION
2				REVISION
3				REVISION

BENTON
 ANS. INC. ENGINEERS
 MIDLAND PLANT UNITS 1 & 2
 CONSUMERS POWER COMPANY
 PIPING AND INSTRUMENT DIAGRAM
 DOMESTIC WATER

JOB NO. 7220 DRAWING NO. M-459SH1B REV. 3

8.5"

11"

17"

8.5"

11"

17"

R. D. S.

8112230060

