


J-08-0 SHT. 7

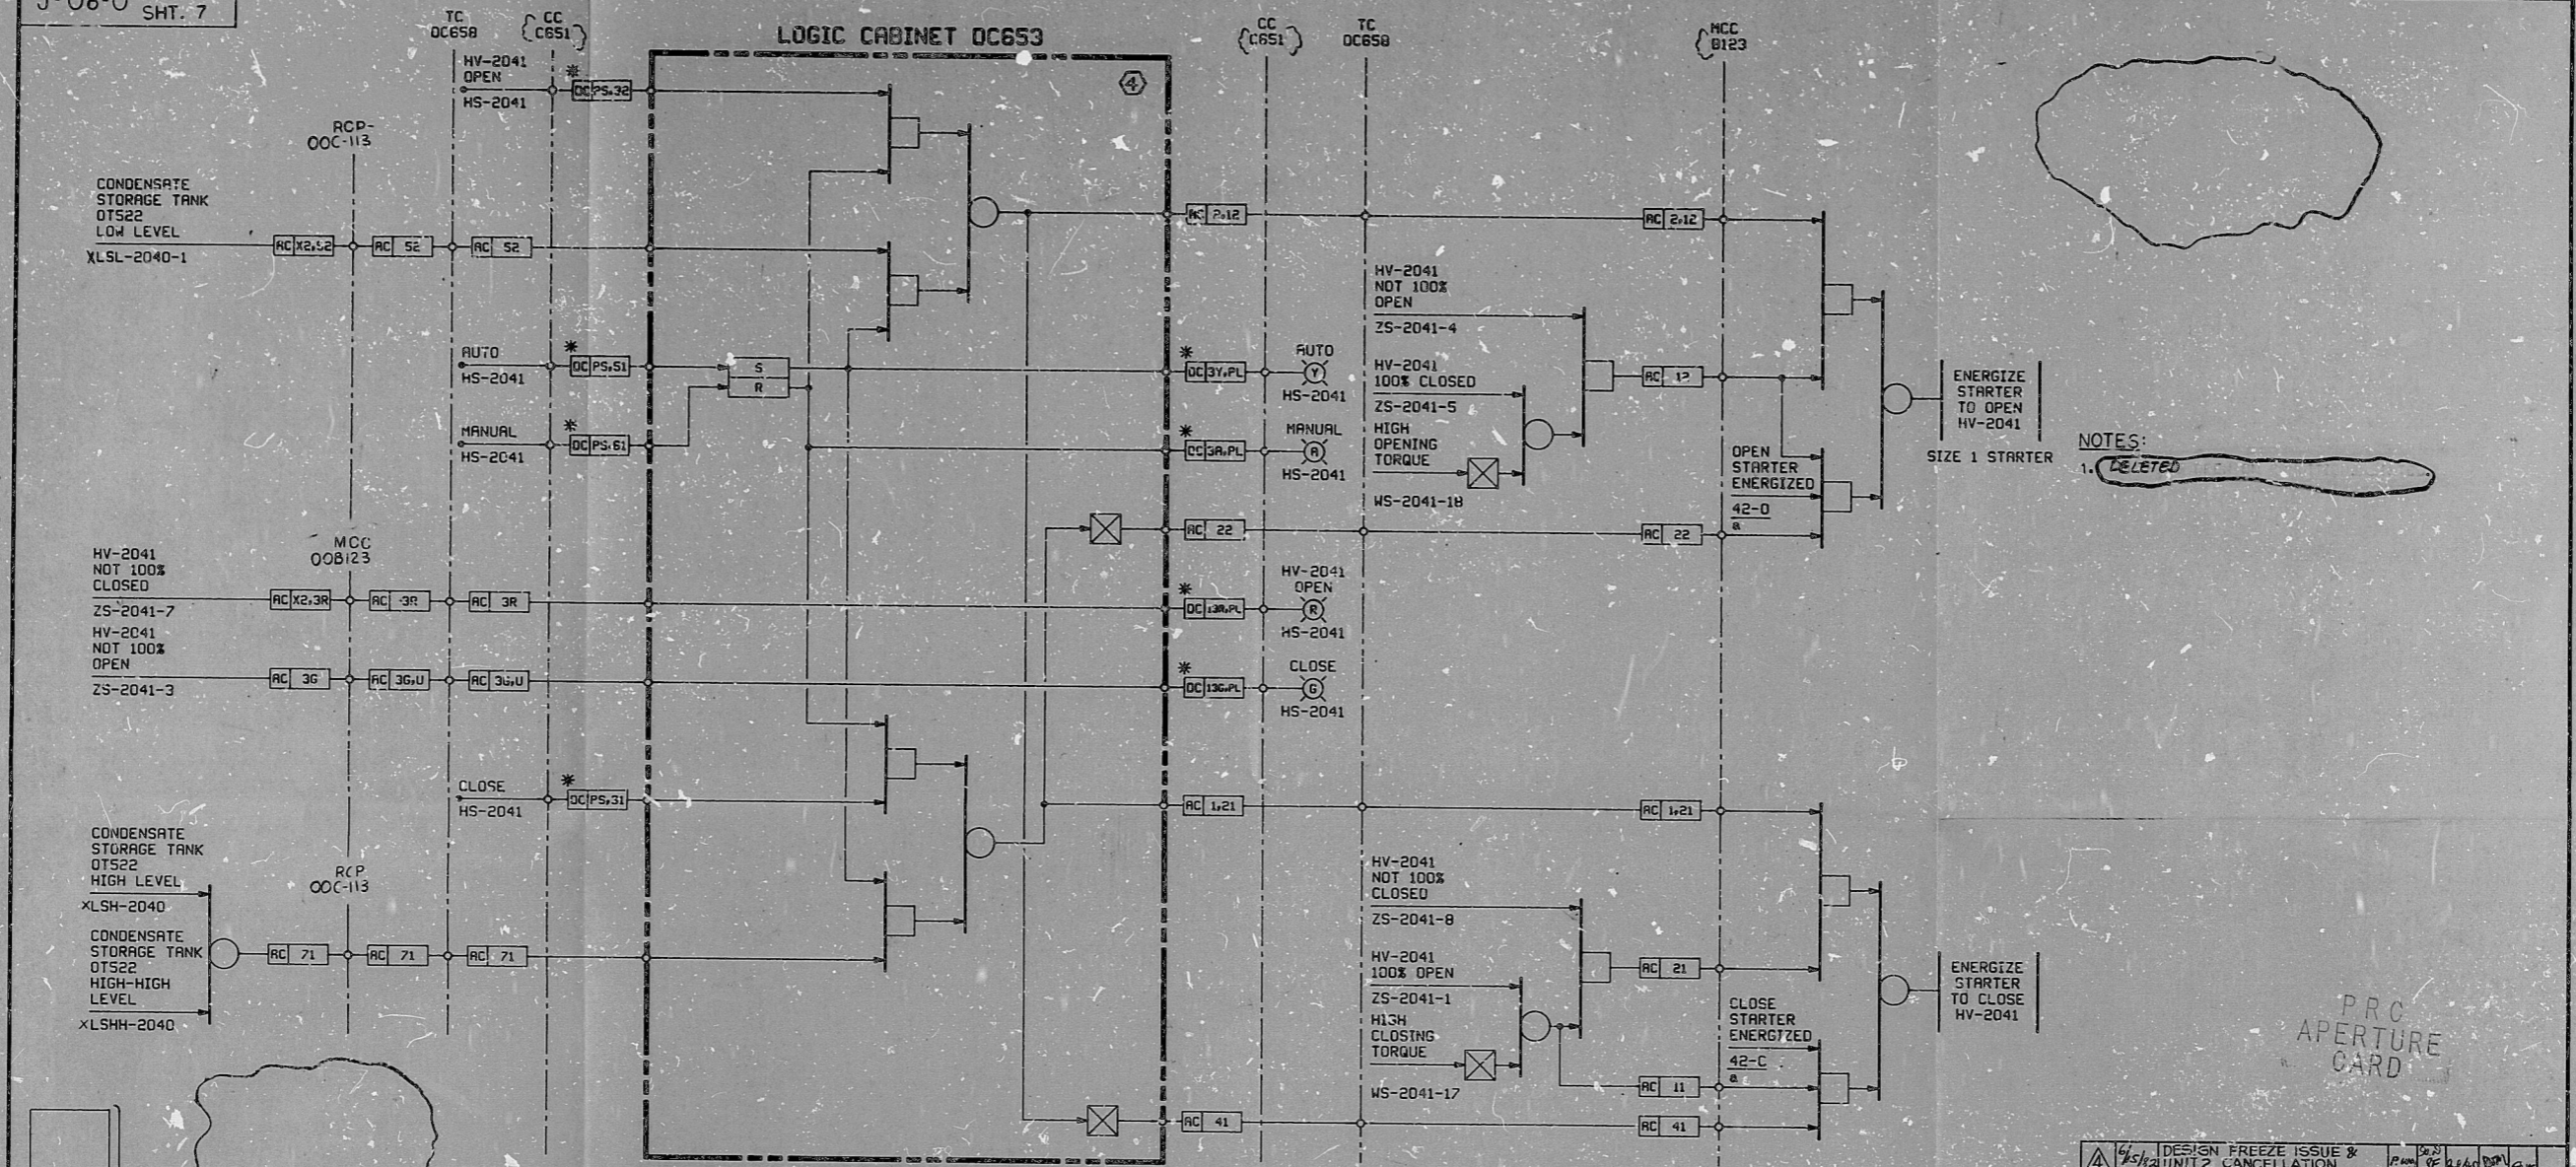

NOTES:  
1. DELETED

PRC APERTURE CARD

This drawing and the design it covers are the property of BECHTEL. They are hereby loaned and on the borrower's express agreement that they will not be reproduced, copied, loaned, exhibited, nor used except in the limited way and private use permitted by any written consent given by the issuer to the borrower.

NOT USED	
MANUAL (A)	
AUTO (Y)	HS-2041
HV-2041 OPEN (R)	
CLOSE (G)	CC C 6516

MOMENTARY

CONDENSATE TANK DEMINERALIZED WATER MAKEUP VALVE HV-2041

4/5/72	DESIGN FREEZE ISSUE & UNIT 2 CANCELLATION	FROM	BY	DATE
7/1/72	REVISED AS NOTED	J. W. ...	...	...
7/1/72	REVISED AS NOTED	...	...	...
10/20/72	ISSUED FOR CONSTRUCTION	S I G N E D		

SCALE: NONE

DESIGNED: P. WONG

DRAWN: RCG

**BECHTEL**  
SAN FRANCISCO

PUBLIC SERVICE ELECTRIC AND GAS COMPANY  
HOPE CREEK GENERATING STATION

**LOGIC DIAGRAM**  
CONDENSATE REFUELING WATER STORAGE & TRANSFER  
CONDENSATE TANK DEMINERALIZED WATER MAKEUP VALVE HV-2041

JOB No.	DRAWING No.	REV.
10955	J-08-0 SHT. 7	4

S/U - RP

22 x 30 1/2" SIZE

RIDS

830728000

