
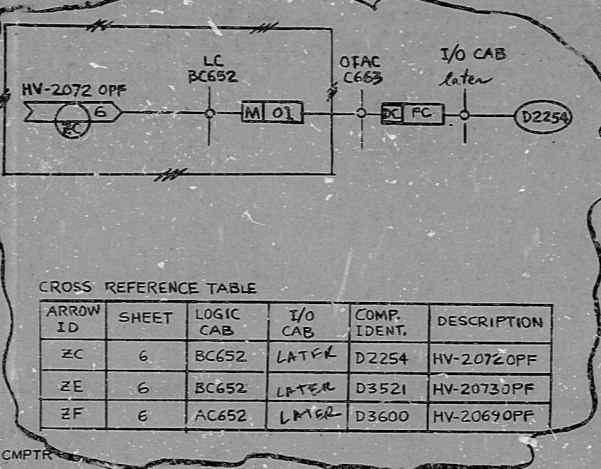
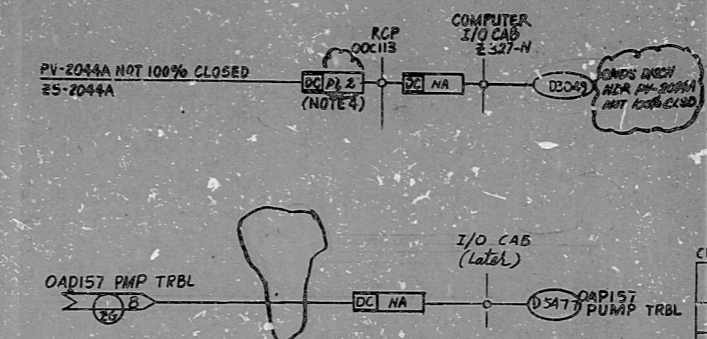


J-08-0 SHT. 8

REMOTE CONTROL PANEL DCC-113

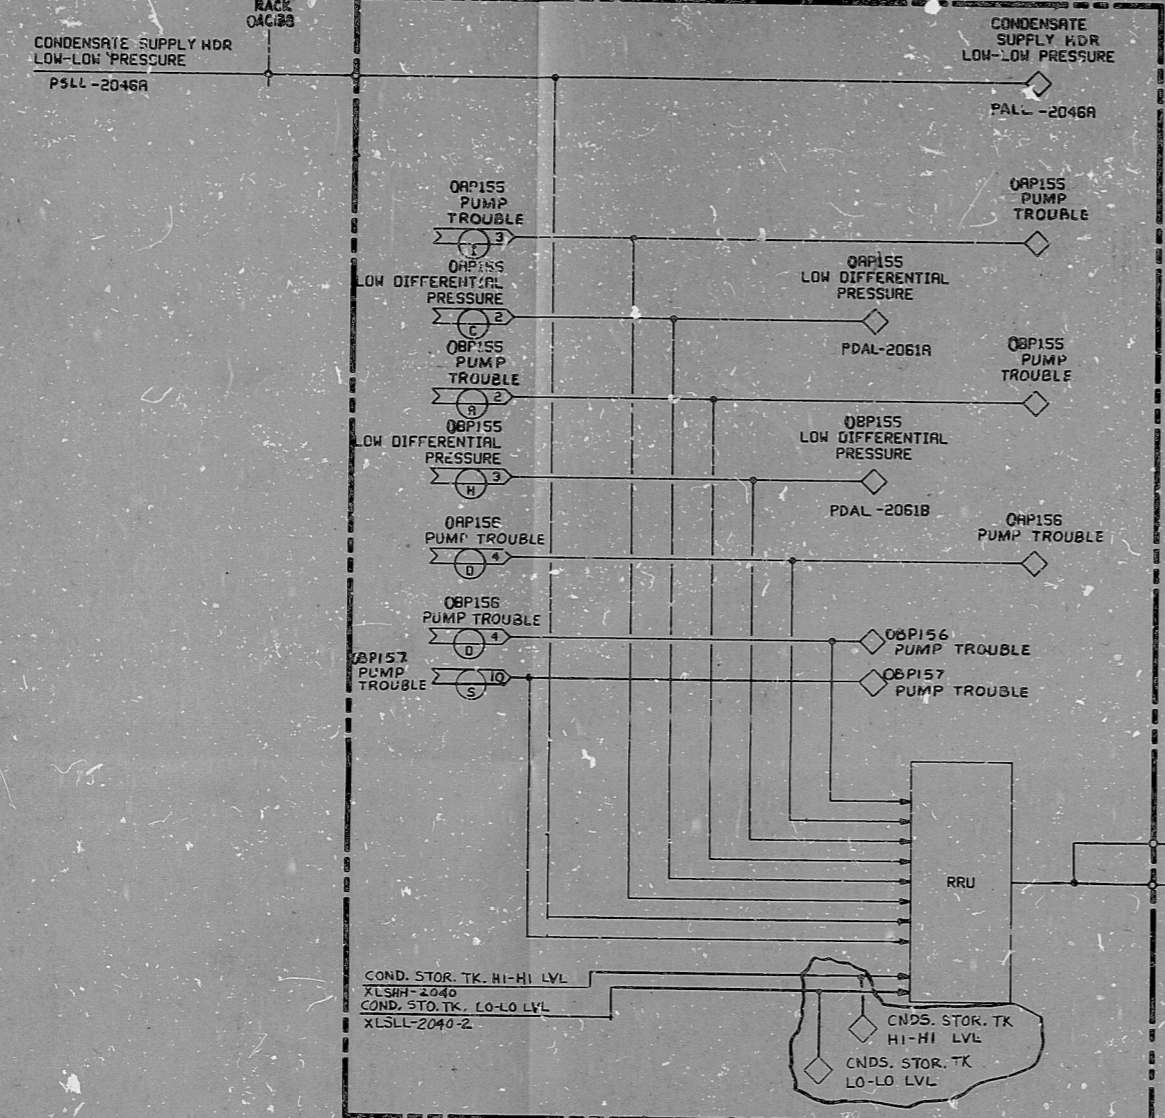



CROSS REFERENCE TABLE

ARROW ID	SHEET	LOGIC CAB	I/O CAB	COMP. IDENT.	DESCRIPTION
ZC	6	BC652	LATER	D2254	HV-2072 OPF
ZE	6	BC652	LATER	D3521	HV-2073 OPF
ZF	6	AC652	LATER	D3600	HV-2069 OPF

CROSS REFERENCE TABLE

ARROW ID	PANEL/CABINET	CMPTR I/O CAB.	CMPTR PT I.D.	WIRE NO TO CMPTR I/O CAB.	SERVICE
ARROW ZA SHT. 9	DC653	D2630	D3046	NA	OAP157 RUNNING
ARROW ZB SHT. 10	DC653	D2630	D5135		OAP157 RUNNING
ARROW ZD SHT. 8	DCC113	D327N	D3051		RMT. PNL. DCC113 TRBL

- NOTES:
1. DELETED
 2. DELETED
 3. DELETED
 4. 125VDC POWER SUPPLIES SHALL BE FROM COMPUTER I/O CABINETS RESPECTIVELY.
 5. DELETED

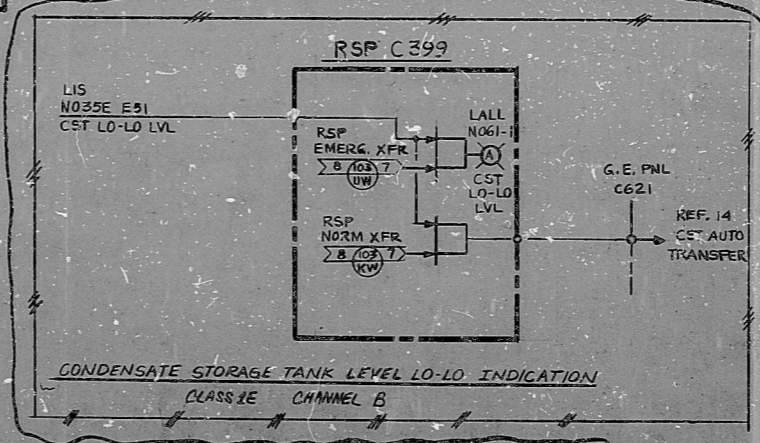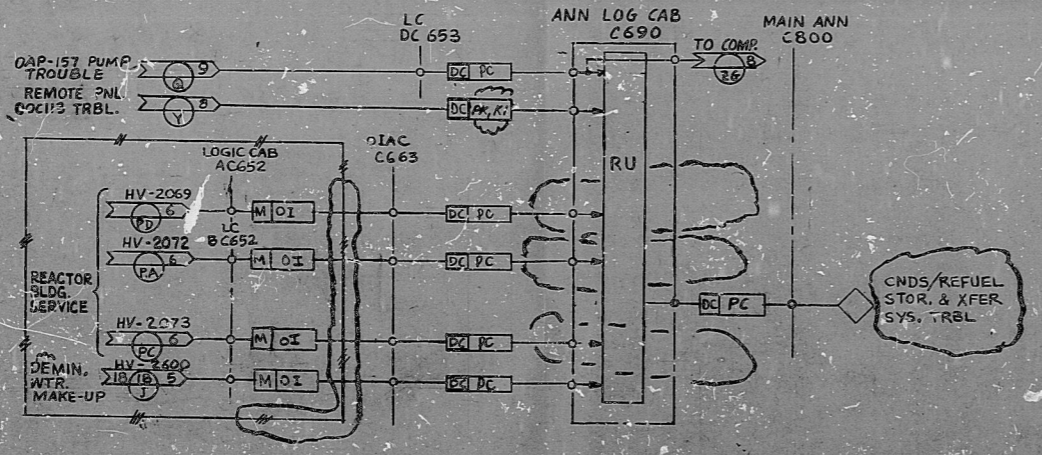

REV.	DATE	BY	CHKD.	APPD.	DESCRIPTION
1/1/78					REVISED FOR RSP INTERFACE AND COMPUTER UPDATE
2/1/78					DESIGN FREEZE ISSUE & UNIT 2 DELETION
3/1/78					REVISED AS NOTED FOR LOCAL PANEL
4/1/78					REVISED BAILEY INTERFACE AS NOTED
5/1/78					REVISED AS NOTED
6/1/78					REVISED AS NOTED, MOVED MOV ON LUPWR. PAN. TO UNIT II
7/1/78					REVISED AS NOTED
10-20-78					ISSUED FOR CONSTRUCTION

BECHTEL
SAN FRANCISCO

PUBLIC SERVICE ELECTRIC AND GAS COMPANY
MOPE CREEK GENERATING STATION

LOGIC DIAGRAM
CONDENSATE RECEIVING WATER STORAGE & TRANSFER
ALARMS AND COMPUTER INPUTS

JOB No.	DRAWING No.	REV.
10855	J-08-0 SHT. 8	Q

This drawing and the design it covers are the property of BECHTEL. They are hereby loaned out on the borrower's express agreement that they will not be reproduced, copied, loaned, exhibited, or used except in the limited way and purpose intended by the issuer to the borrower.

PRC APERTURE CARD

RIDS

8307280003

