


M-468 SH1 (Q)

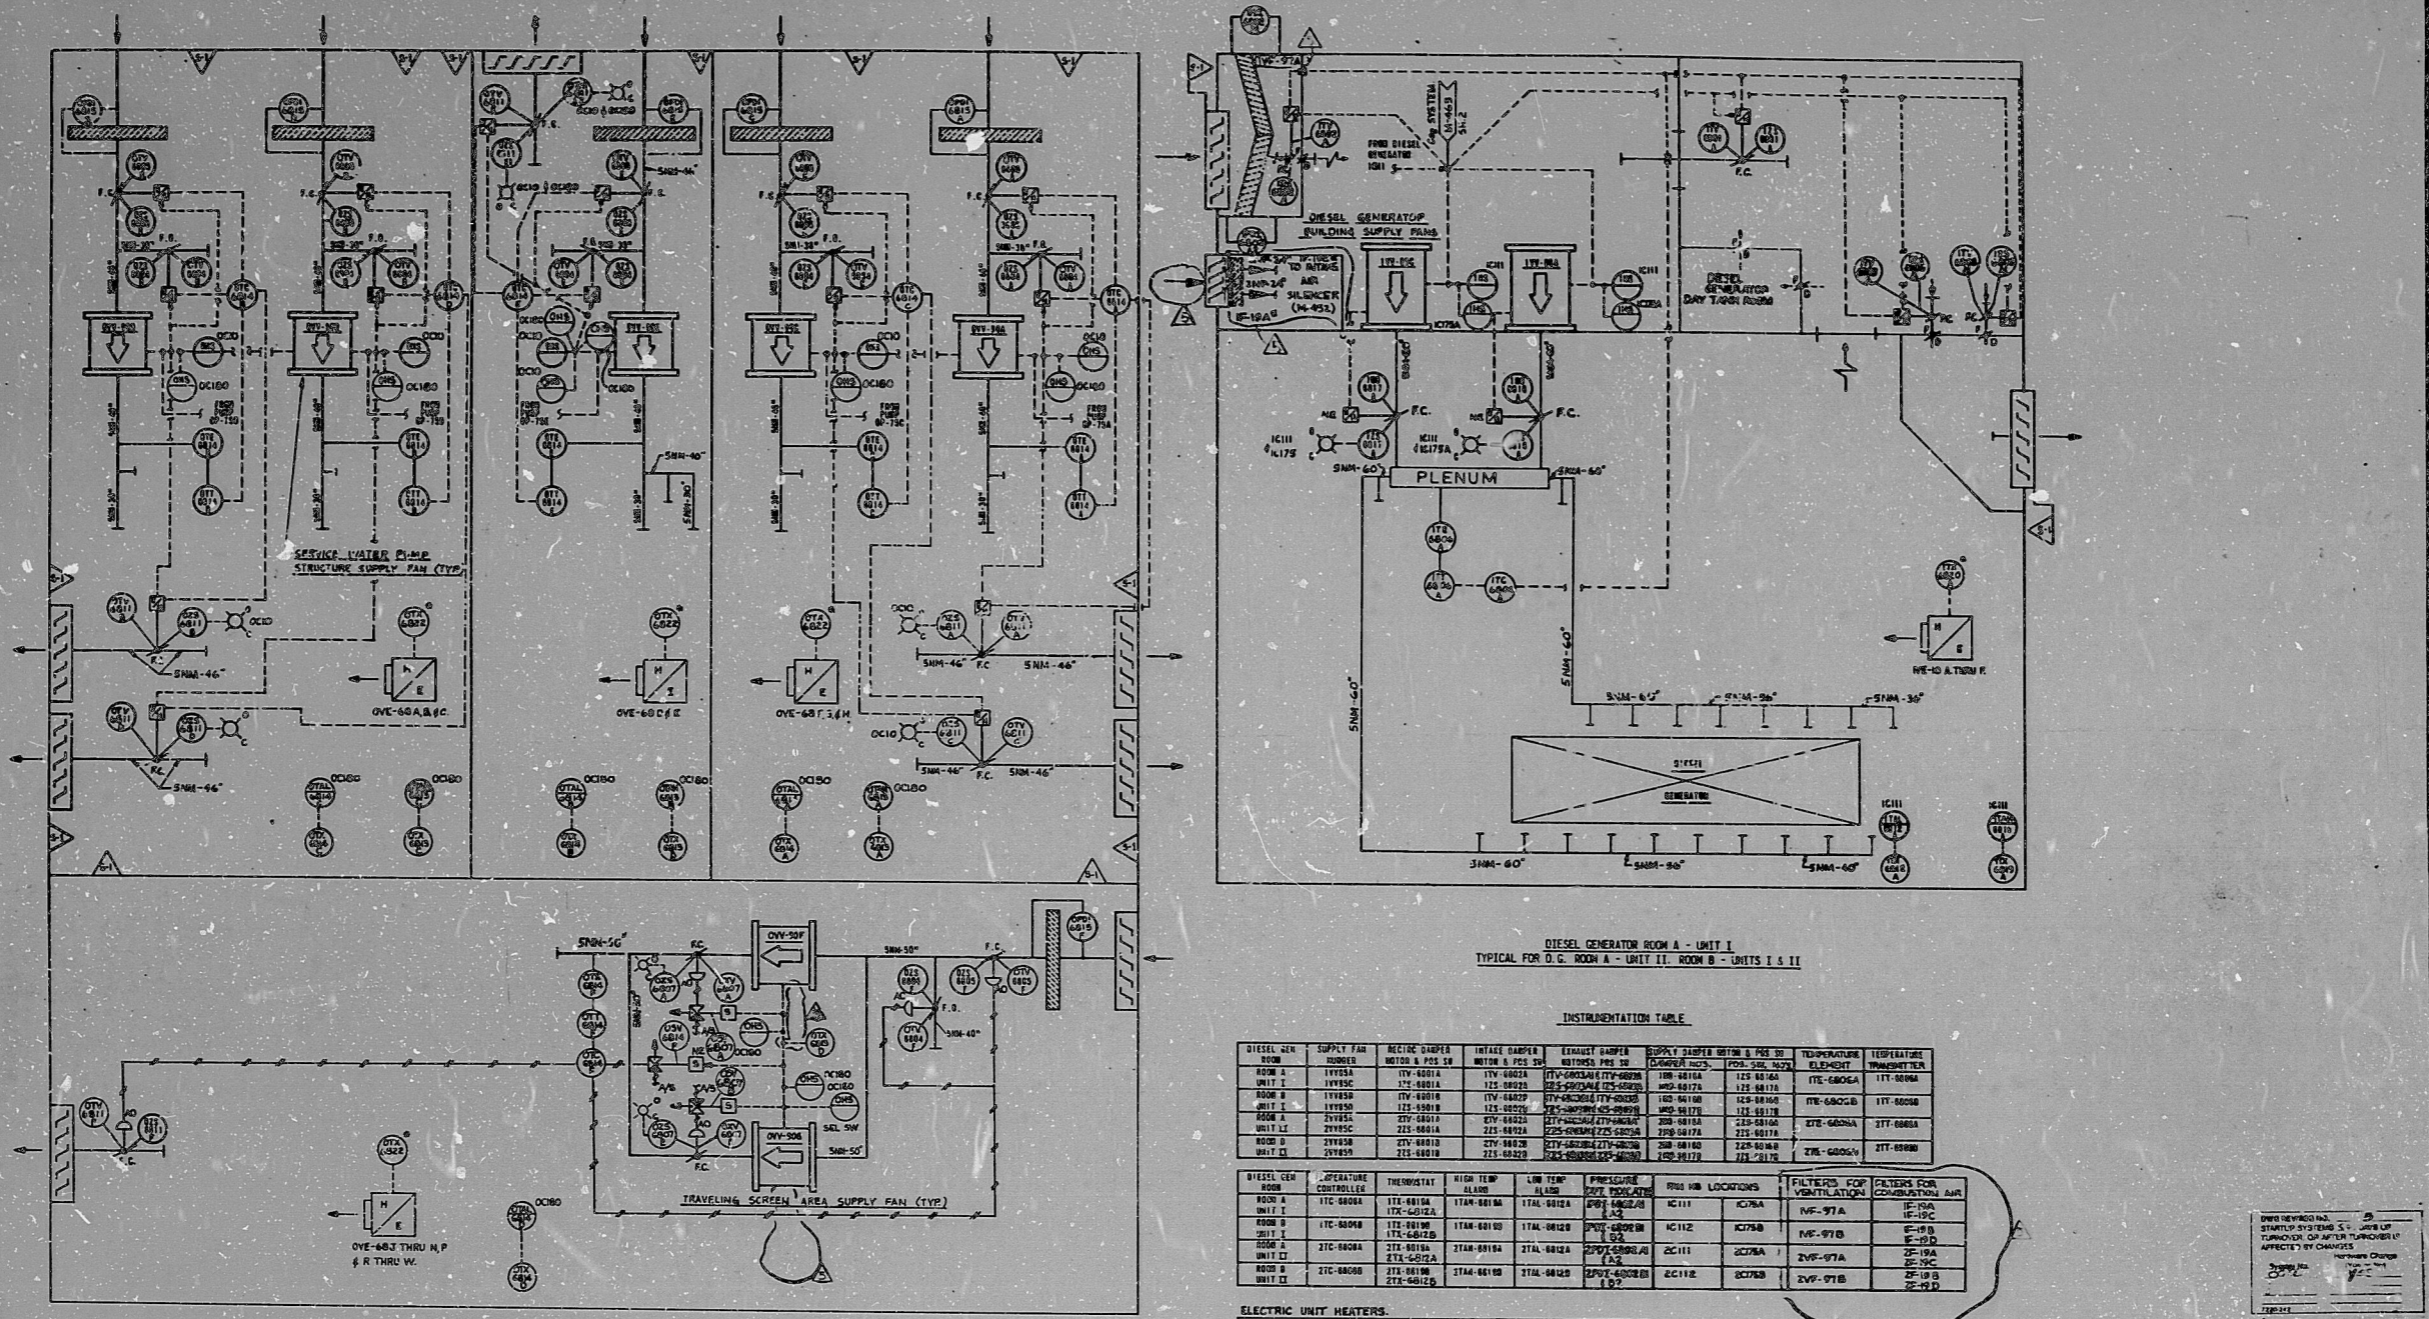

DIESEL GENERATOR ROOM A - UNIT I
TYPICAL FOR D.C. ROOM A - UNIT II, ROOM B - UNITS I & II

INSTRUMENTATION TABLE

DIESEL GEN ROOM	SUPPLY FAN MOTOR & PPS IS	ELECTRIC UNIT HEATER MOTOR & PPS IS	TRIP SIGNAL MOTOR & PPS IS	TRIP SIGNAL MOTOR & PPS IS	TRIP SIGNAL MOTOR & PPS IS	TEMPERATURE ELEMENT	TEMPERATURE TRANSMITTER
ROOM A	1VY85A	1VY85A	1VY85A	1VY85A	1VY85A	1VY85A	1VY85A
UNIT I	1VY85A	1VY85A	1VY85A	1VY85A	1VY85A	1VY85A	1VY85A
ROOM B	1VY85B	1VY85B	1VY85B	1VY85B	1VY85B	1VY85B	1VY85B
UNIT I	1VY85B	1VY85B	1VY85B	1VY85B	1VY85B	1VY85B	1VY85B
UNIT II	1VY85B	1VY85B	1VY85B	1VY85B	1VY85B	1VY85B	1VY85B
ROOM C	1VY85C	1VY85C	1VY85C	1VY85C	1VY85C	1VY85C	1VY85C
UNIT I	1VY85C	1VY85C	1VY85C	1VY85C	1VY85C	1VY85C	1VY85C
UNIT II	1VY85C	1VY85C	1VY85C	1VY85C	1VY85C	1VY85C	1VY85C

ELECTRIC UNIT HEATERS:

ROOM	UNIT	EQUIPMENT No.	THERMOSTAT
A	II	3VE-10 A THRU F	2TX-6820 A THRU F
B	I	1VE-05 A THRU G	1TX-6821 A THRU G
B	II	2VE-05 A THRU G	2TX-6821 A THRU G
A	I	1VE-10 A THRU F	1TX-6820 A THRU F

EQUIPMENT IDENTIFICATION

DIESEL GEN ROOM	UNIFANAL FANS	ELECTRIC UNIT HEATERS
ROOM A	1VY85A	1VE-10 A THRU F
UNIT I	1VY85A	1VE-10 A THRU F
ROOM B	1VY85B	1VE-05 A THRU G
UNIT I	1VY85B	1VE-05 A THRU G
ROOM C	1VY85C	1VE-10 A THRU F
UNIT I	1VY85C	1VE-10 A THRU F
UNIT II	1VY85C	1VE-05 A THRU G

30X

TERA APERTURE CARD

I certify that the image contained on this frame was made in the normal and regular course of business, on the date stated below and that it is an accurate reproduction of the document submitted to rephotography.

1-1-1	DELETED 07-1-68 1/2 AND REVISED AS INDICATED	1/2	1/2	1/2	1/2
1-1-2	REVISIONS TO 1-1-1	1/2	1/2	1/2	1/2
1-1-3	REVISIONS TO 1-1-2	1/2	1/2	1/2	1/2
1-1-4	REVISIONS TO 1-1-3	1/2	1/2	1/2	1/2
1-1-5	REVISIONS TO 1-1-4	1/2	1/2	1/2	1/2
1-1-6	REVISIONS TO 1-1-5	1/2	1/2	1/2	1/2
1-1-7	REVISIONS TO 1-1-6	1/2	1/2	1/2	1/2
1-1-8	REVISIONS TO 1-1-7	1/2	1/2	1/2	1/2
1-1-9	REVISIONS TO 1-1-8	1/2	1/2	1/2	1/2
1-1-10	REVISIONS TO 1-1-9	1/2	1/2	1/2	1/2

BECHTEL
JIM JESSE, DIRECTOR

BRIDLAND PLANT UNITS 1 & 2
CONSUMERS POWER COMPANY

PIPING AND INSTRUMENT DIAGRAM
HEATING, VENTILATING & AIR CONDITIONING
MISC. STRUCTURE

7220	M-468 SH1(Q)	5
------	--------------	---

POOR ORIGINAL

8.5"

11"

17"

8.5"

11"

17"

RIDS

8112230078

