


J-09-0 SHT. 3

This drawing and its design are the property of BECHTEL. They are hereby loaned and on the borrower's express agreement that they will not be reproduced, copied, loaned, exhibited, nor used except in the limited way and private use permitted by any written consent given by the lender to the borrower.

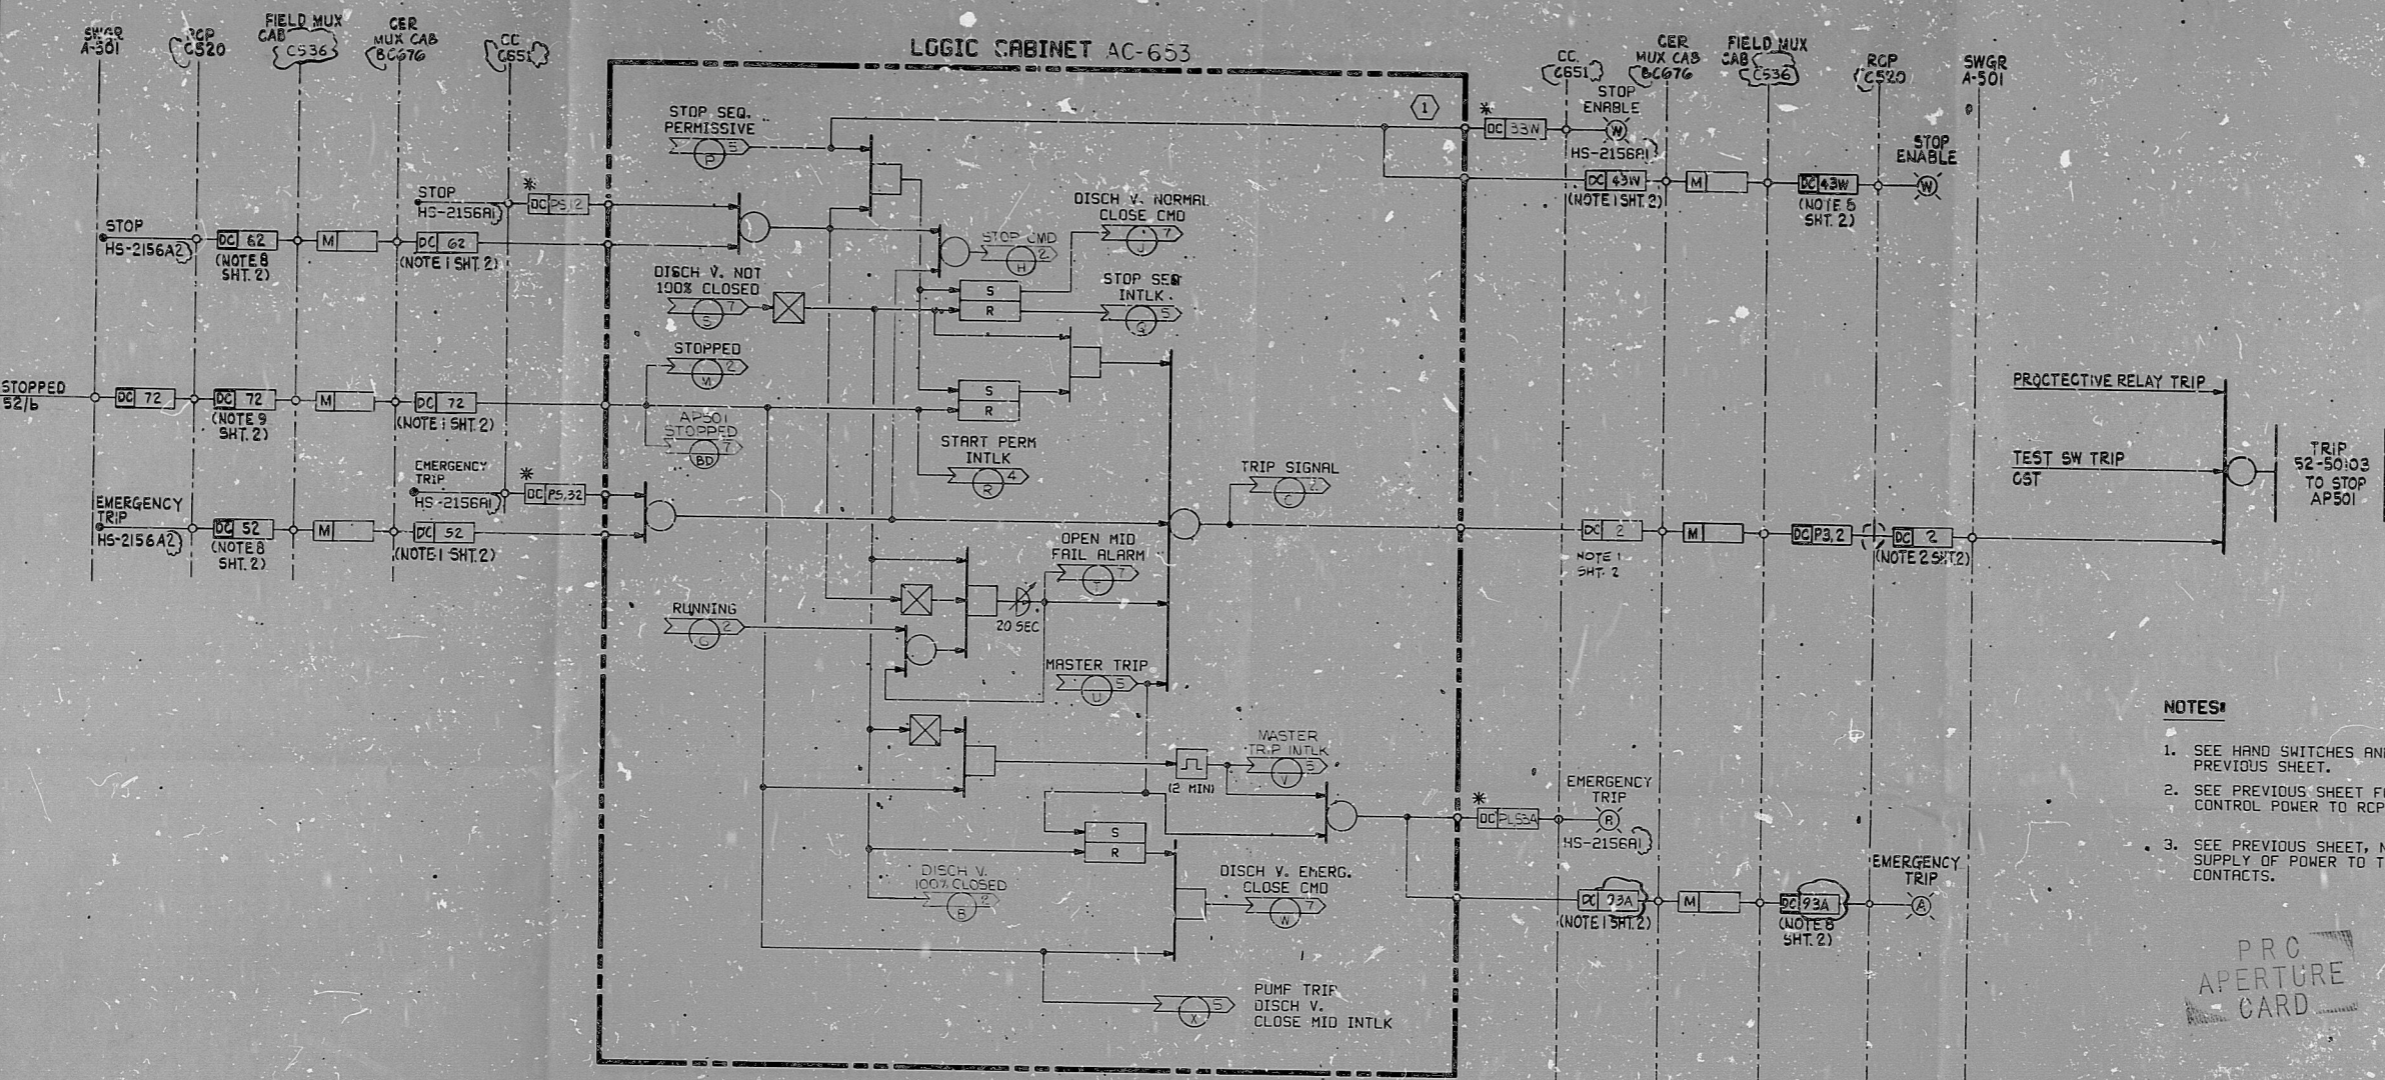

CIRC. WTR PUMP AP501 STOP

- NOTES:**
- SEE HAND SWITCHES AND LIGHTS ON PREVIOUS SHEET.
 - SEE PREVIOUS SHEET FOR SUPPLY OF CONTROL POWER TO RCP.
 - SEE PREVIOUS SHEET, NOTE 2 FOR SUPPLY OF POWER TO TRIP CKT DRIVER CONTACTS.

PRO APERTURE CARD

CROSS REFERENCE TABLE

PUMP	CONTROL SWITCH		DISCH VALVE	BRKR NO	SWGR	FIELD MUX CAB	RCP	LC	CIRCUIT NUMBER (LOGIC CAB.)	CKT. NO. (MUX CAB) (C676)	CER. MUX CAB
	CONTROL ROOM	REMOTE									
AP501	HS-2156A1	HS-2156A2	HV-2152A	52-50103	A501	C536	C520	AC-653	1	1	BC-676
BP501	HS-2156B1	HS-2156B2	HV-2152B	52-50203	A502		C520	BC-653	2	2	AC-676
CP501	HS-2156C1	HS-2156C2	HV-2152C	52-50104	A501		C520	CC-653	3	3	AC-676
DP501	HS-2156D1	HS-2156D2	HV-2152D	52-50204	A502		C520	DC-653	4	4	AC-676

8/4/71	DESIGN FREEZE ISSUE	KM	CD	DES	PLN	CHK
10/1/71	INCORPORATED DCN #, ADDED FIELD MUX CAB	72	LA	YEA	CHL	PLN
11/7/71	REVISED AS NOTED	47	7	7	7	7
11/17/71	REVISED AS NOTED	14	5	5	5	5
1/14/72	ISSUED FOR CONSTRUCTION	47	7	7	7	7

SCALE: NONE DESIGNED: D-H DRAWN: RCD

BECHTEL
SAN FRANCISCO

PUBLIC SERVICE ELECTRIC AND GAS COMPANY
HOPE CREEK GENERATING STATION

LOGIC DIAGRAM
CIRCULATING WATER SYSTEM
CIRC WTR PUMP STOP

JOB No.	DRAWING No.	REV.
10855	J-09-0 SHT. 3	4

S/U - DA

7.5 X 34 "D" SIZE

RIDS

8307280011

