


TERA
APERTURE
CARD

I certify that the work contained on this frame was made on the original and regular course of business, to the date listed below, and that it is an accurate reproduction of the original as permitted to reproduce.

30X

POOR ORIGINAL

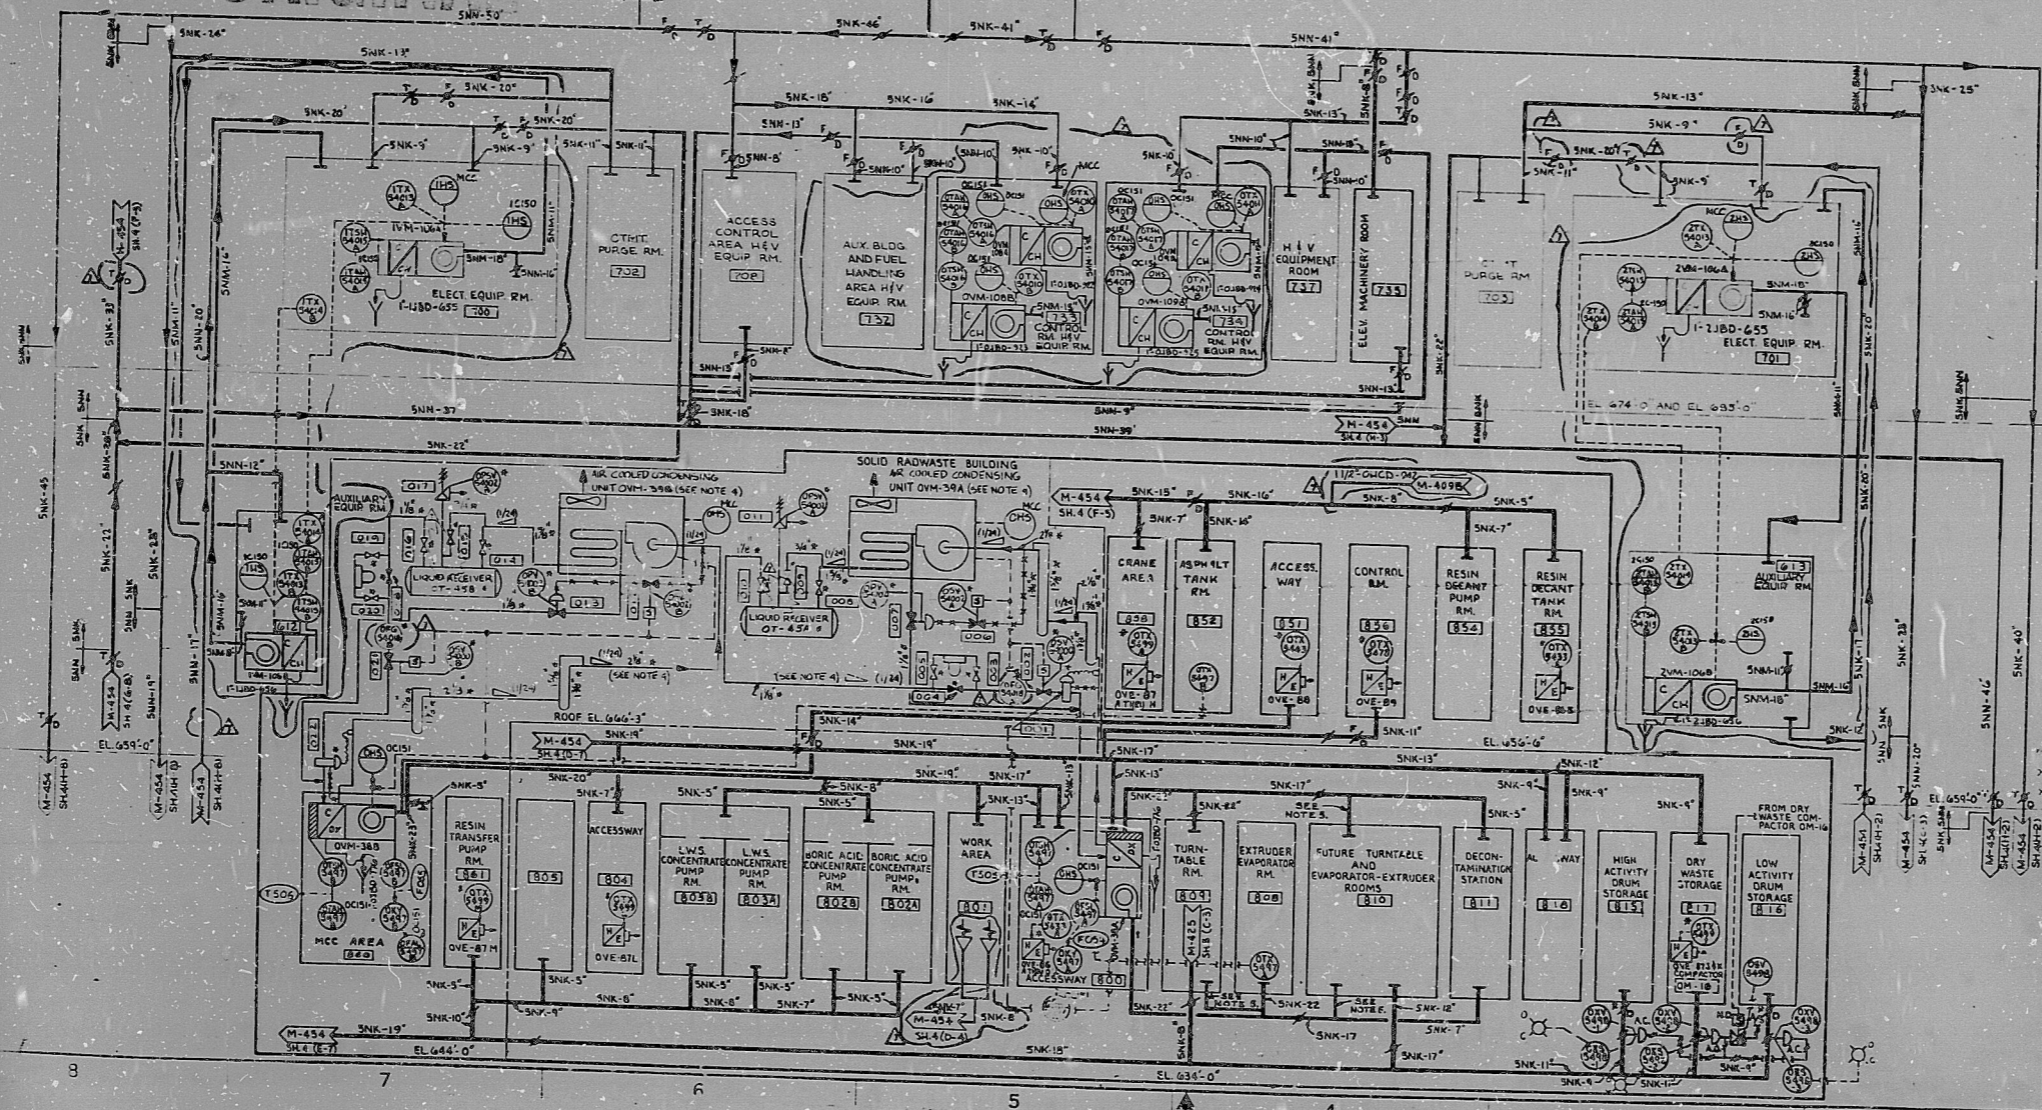

INSTRUMENTATION TABLE
SOLID RADWASTE BUILDING

EQUIPMENT NO.	THERMOSTAT (TA)
OVE-86A	OTR-8433A
OVE-86B	OTR-8433B
OVE-86C	OTR-8433C
OVE-86D	OTR-8433D
OVE-86E	OTR-8433E
OVE-87A	OTR-8444A
OVE-87B	OTR-8444B
OVE-87C	OTR-8444C
OVE-87D	OTR-8444D
OVE-87E	OTR-8444E
OVE-87F	OTR-8444F
OVE-87G	OTR-8444G
OVE-87H	OTR-8444H
OVE-87I	OTR-8444I
OVE-87J	OTR-8444J
OVE-87K	OTR-8444K
OVE-87L	OTR-8444L
OVE-87M	OTR-8444M

- NOTE:
1. AIR FLOW MEASURING UNIT
 2. DELETE
 3. DELETE
 4. ALL PIPING & FITTINGS FOR THE AIR COOLED CONDENSING UNITS OVM-38A & OVM-39B REFRIGERATION CIRCUITS WILL BE SUPPLIED BY VENDOR. PIPE MATERIAL IS TYPE-L BRASS OR COPPER REFRIGERATION TUBE WITH WROUGHT COPPER OR WROUGHT BRASS SWEAT FITTINGS.
 5. THE EXHAUST AND SUPPLY DUCT SERVING ROOM 730 WILL ONLY BE USED WHEN THESE FUTURE EXTENDED EVAPORATOR AND TURNABLE ROOMS ARE ADDED. AT THE PRESENT TIME THEY WILL BE PLANKED OFF. THE SUPPLY DUCT SERVING ROOM 609 WILL BE ELIMINATED WHEN THESE FUTURE ROOMS ARE ADDED.

1	REVISOR	DATE	REVISION
1	REVISED AS INDICATED		
2	REVISED AS INDICATED		
3	REVISED AS INDICATED		
4	REVISED AS INDICATED		
5	ISSUED FOR CONSTRUCTION		

BECHTEL
MIDLAND PLANT UNITS 1 & 2
CONSUMERS POWER COMPANY

PIPING AND INSTRUMENT DIAGRAM
HEATING, VENTILATION AND AIR CONDITIONING
AUXILIARY BUILDING UNITS 1 & 2

JOB NO. 7220 DRAWING NO. M-454, SH (9) REV. 7

RIDS

8112230086

