



J-09-0 SHT. 4

LOGIC CABINET AC-653

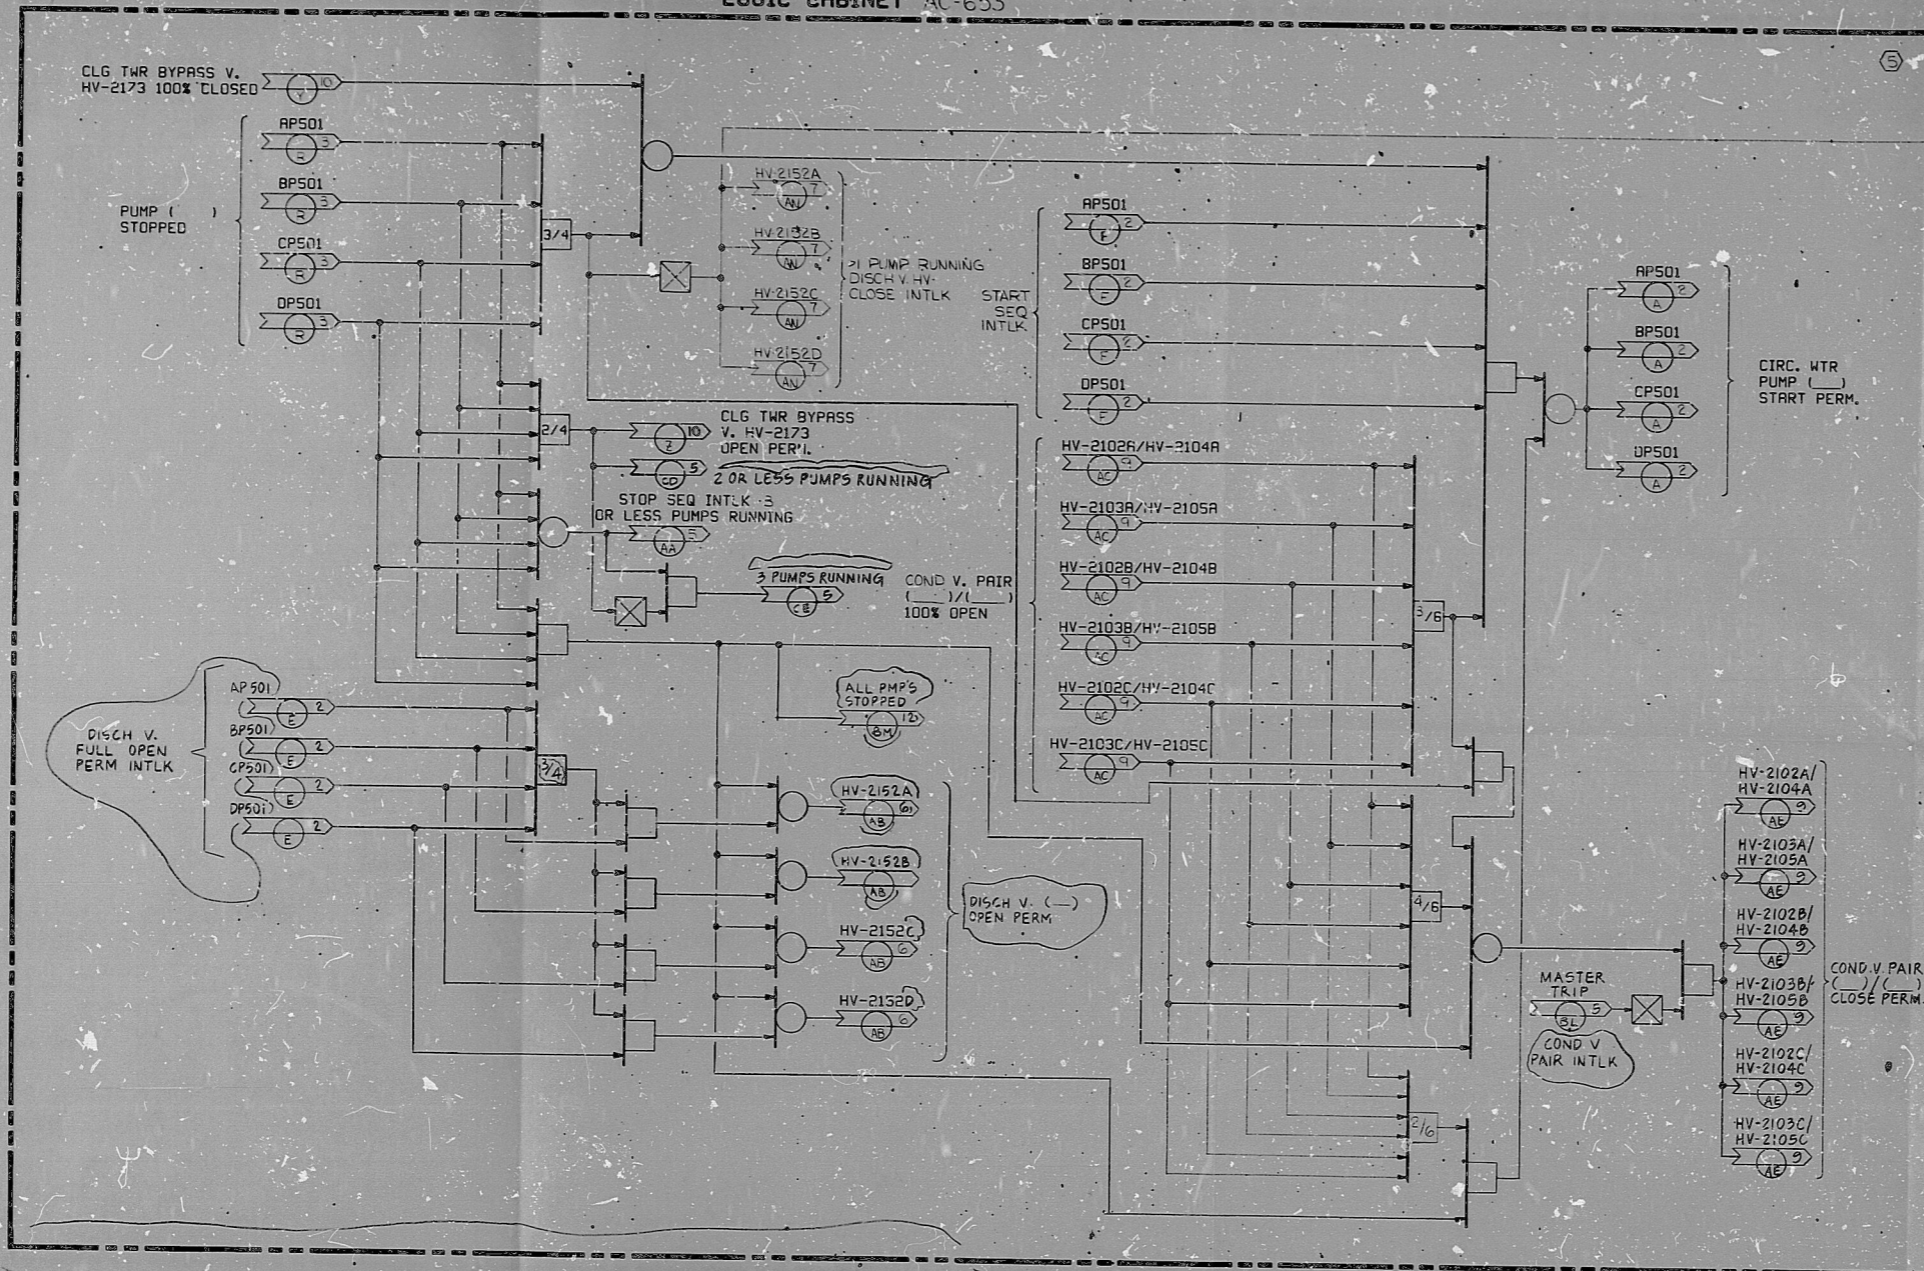

MASTER SEQ CONTROL-START

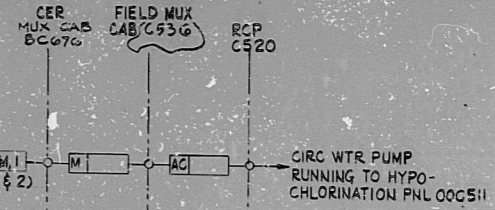

- NOTES:
- 24V DC MULTIPLEXER POWER (PM) IS USED TO POWER OUTPUT FROM LOGIC CAB AC653 TO MUX CAB C676.
 - MUX CAB C676 CKT. NO. 15 5.

PRO APERTURE CARD

NO.	DATE	REVISIONS	BY	CHKD	DESIGN	ENGR	PROJ	APPR
1	1/1/54	DESIGN FREEZE ISSUE	KM	JP	RS	RM	SKL	
2	1/1/54	INCORPORATED DCN # 1	JK	JK	JK	JK	JK	
3	4/1/54	REVISED AS NOTED	SK	SK	SK	SK	SK	
4	7/1/54	REVISED AS NOTED	JK	JK	JK	JK	JK	
5	7/21/54	ISSUED FOR CONSTRUCTION	JK	JK	JK	JK	JK	

SCALE: NONE DESIGNED: DMH DRAWN: RCG BY: CHKD: DESIGN: ENGR: PROJ: APPR:

BECHTEL
SAN FRANCISCO

PUBLIC SERVICE ELECTRIC AND GAS COMPANY
HOPE CREEK GENERATING STATION

LOGIC DIAGRAM
CIRCULATING WATER SYSTEM
MASTER SEQ CONTROL-START

JOB No.	DRAWING No.	REV.
10855	J-09-0 SHT. 4	4

S/U - DR

This drawing and the design it covers are the property of BECHTEL. They are hereby loaned and on the borrower's express agreement that they will not be reproduced, copied, loaned, exhibited, nor used except in the limited way and private use permitted by any written consent given by the lender to the borrower.

RIDS

8307280012

