

11



11

8.5"

8.5"

11"

17"

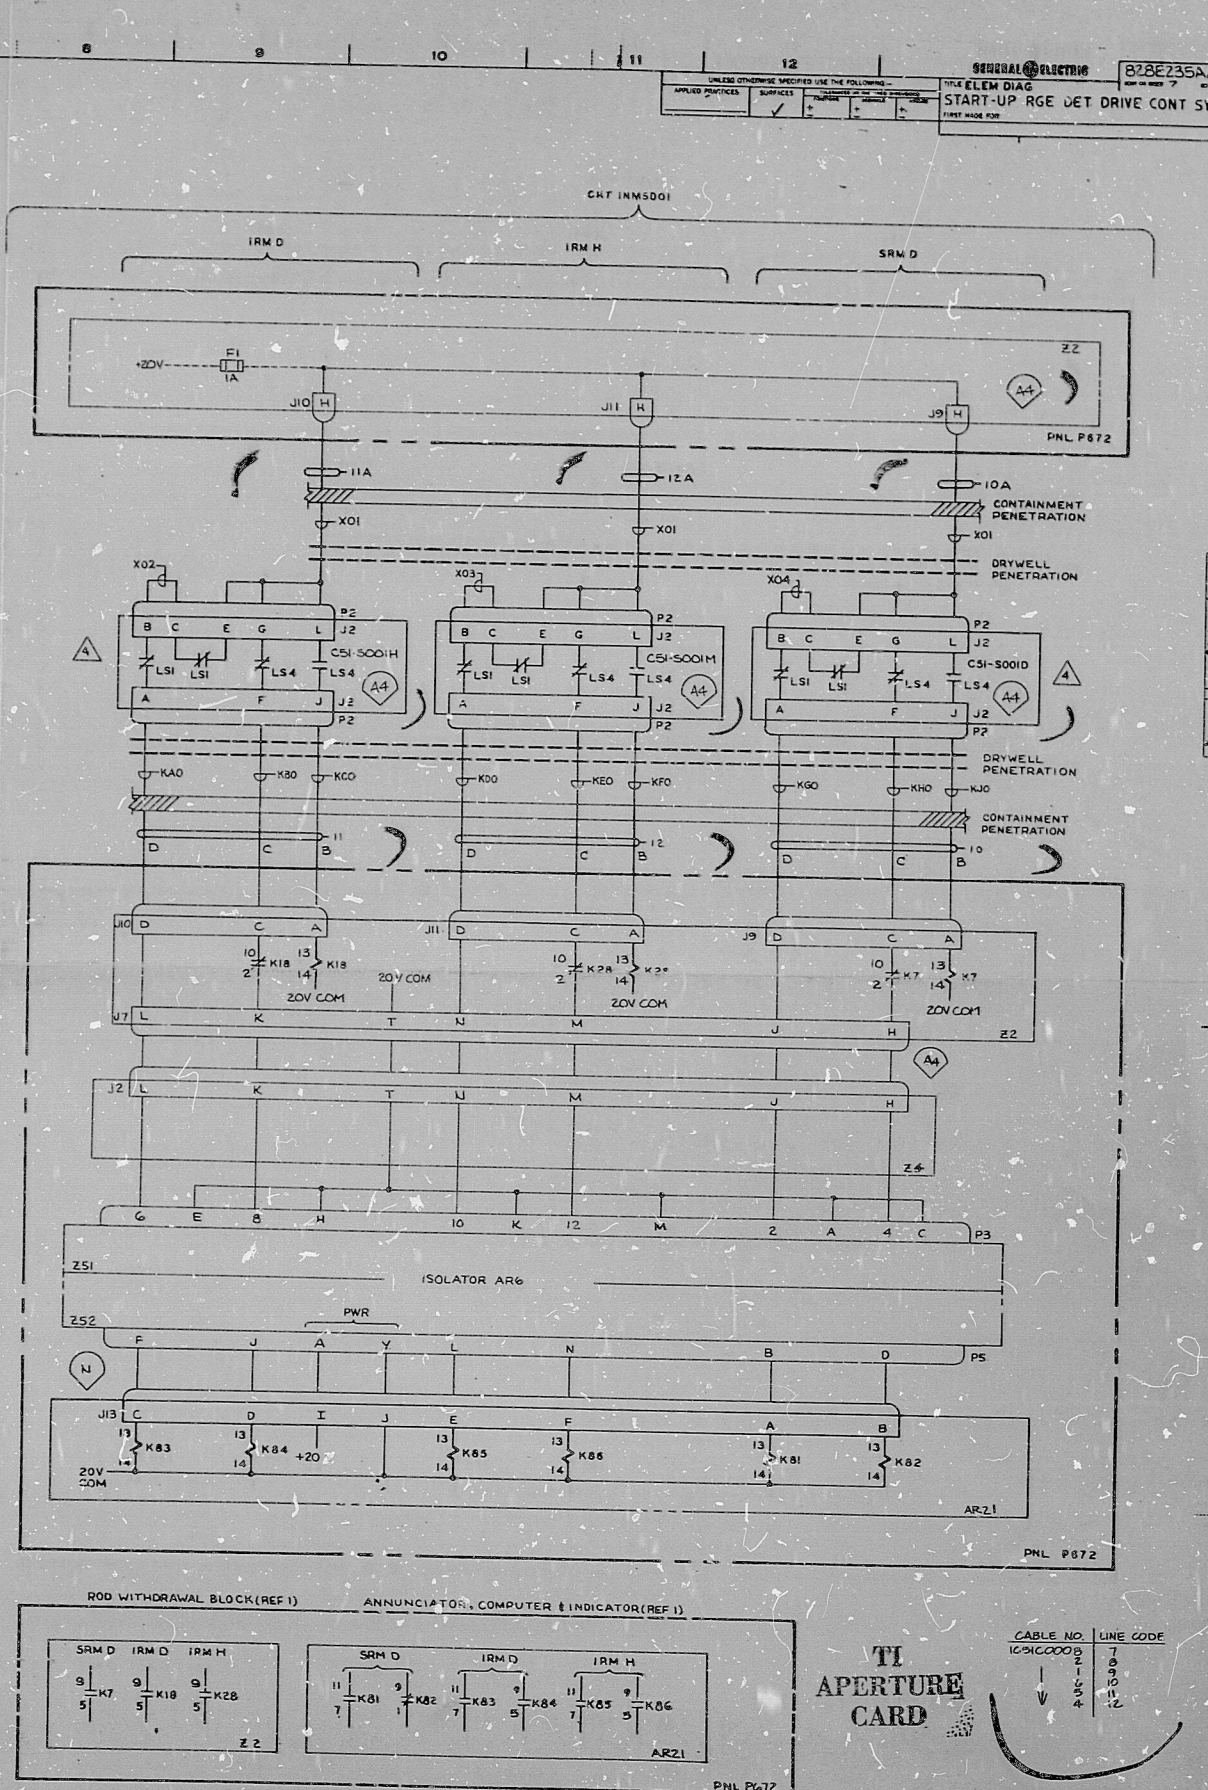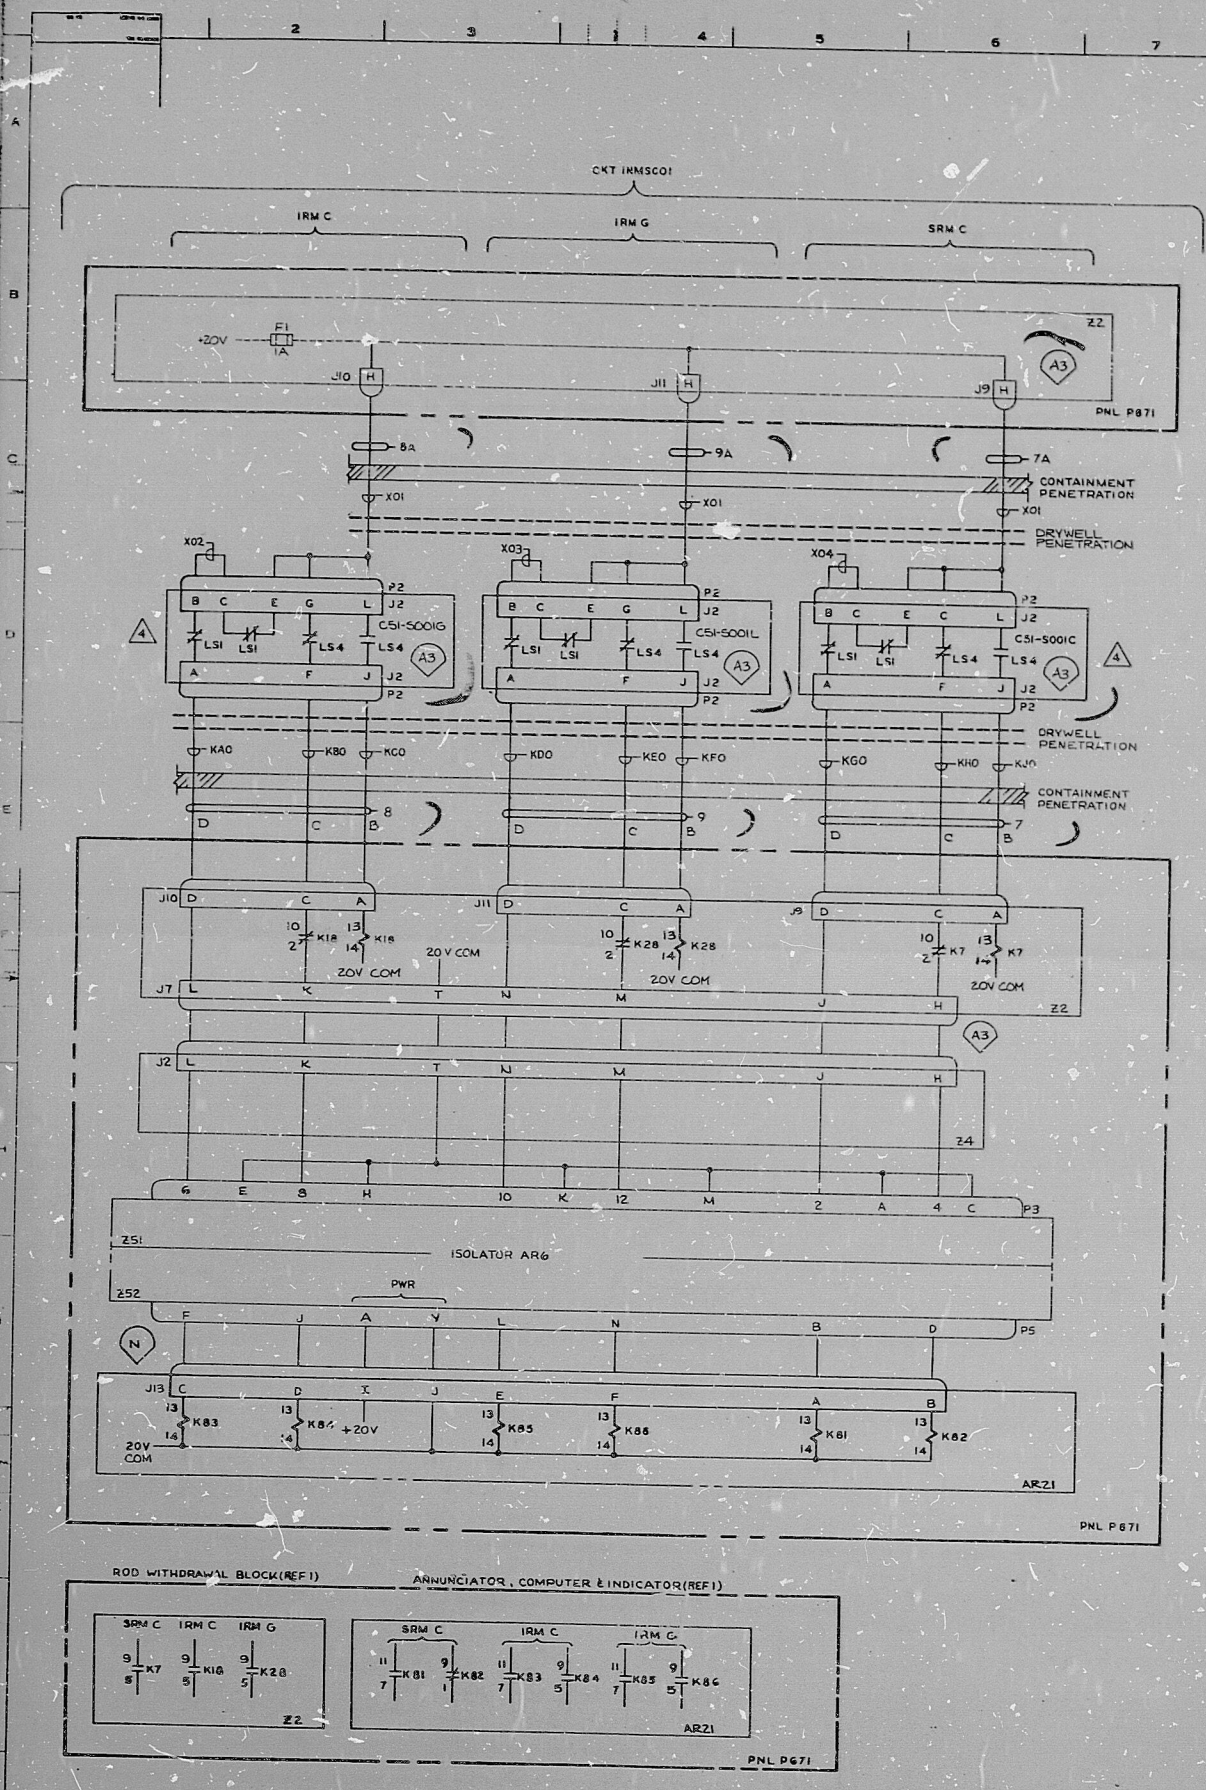

GENERAL ELECTRIC 828235AA

START-UP RGE JET DRIVE CONT SYS

APPLIED SERVICES SURVEYED

UNLESS OTHERWISE SPECIFIED USE THE FOLLOWING:

WIRE GAUGE: 18 AWG

WIRE TYPE: THHN

WIRE COLOR: BLACK

WIRE SIZE: 18 AWG

WIRE TYPE: THHN

WIRE COLOR: BLACK

WIRE SIZE: 18 AWG

WIRE TYPE: THHN

WIRE COLOR: BLACK

WIRE SIZE: 18 AWG

TI APERTURE CARD

CABLE NO.	LINE CODE
10100000	7
10100000	8
10100000	9
10100000	10
10100000	11
10100000	12

LINE CODES: 7-12

NO.	DESCRIPTION	DATE	BY	CHKD BY
4	REVISION			
5	REVISION			
6	REVISION			
7	REVISION			

DESIGNED BY: [Name]

CHECKED BY: [Name]

DATE: [Date]

PROJECT: [Project Name]

828235AA

PDR RIDS

8412190184

