


J-09-0 SHT. 8

This drawing and the design it covers are the property of BECHTEL. They are hereby loaned and on the borrower's express agreement that they will not be reproduced, copied, exhibited, or used except in the limited way and under the conditions permitted by the lender to the borrower.

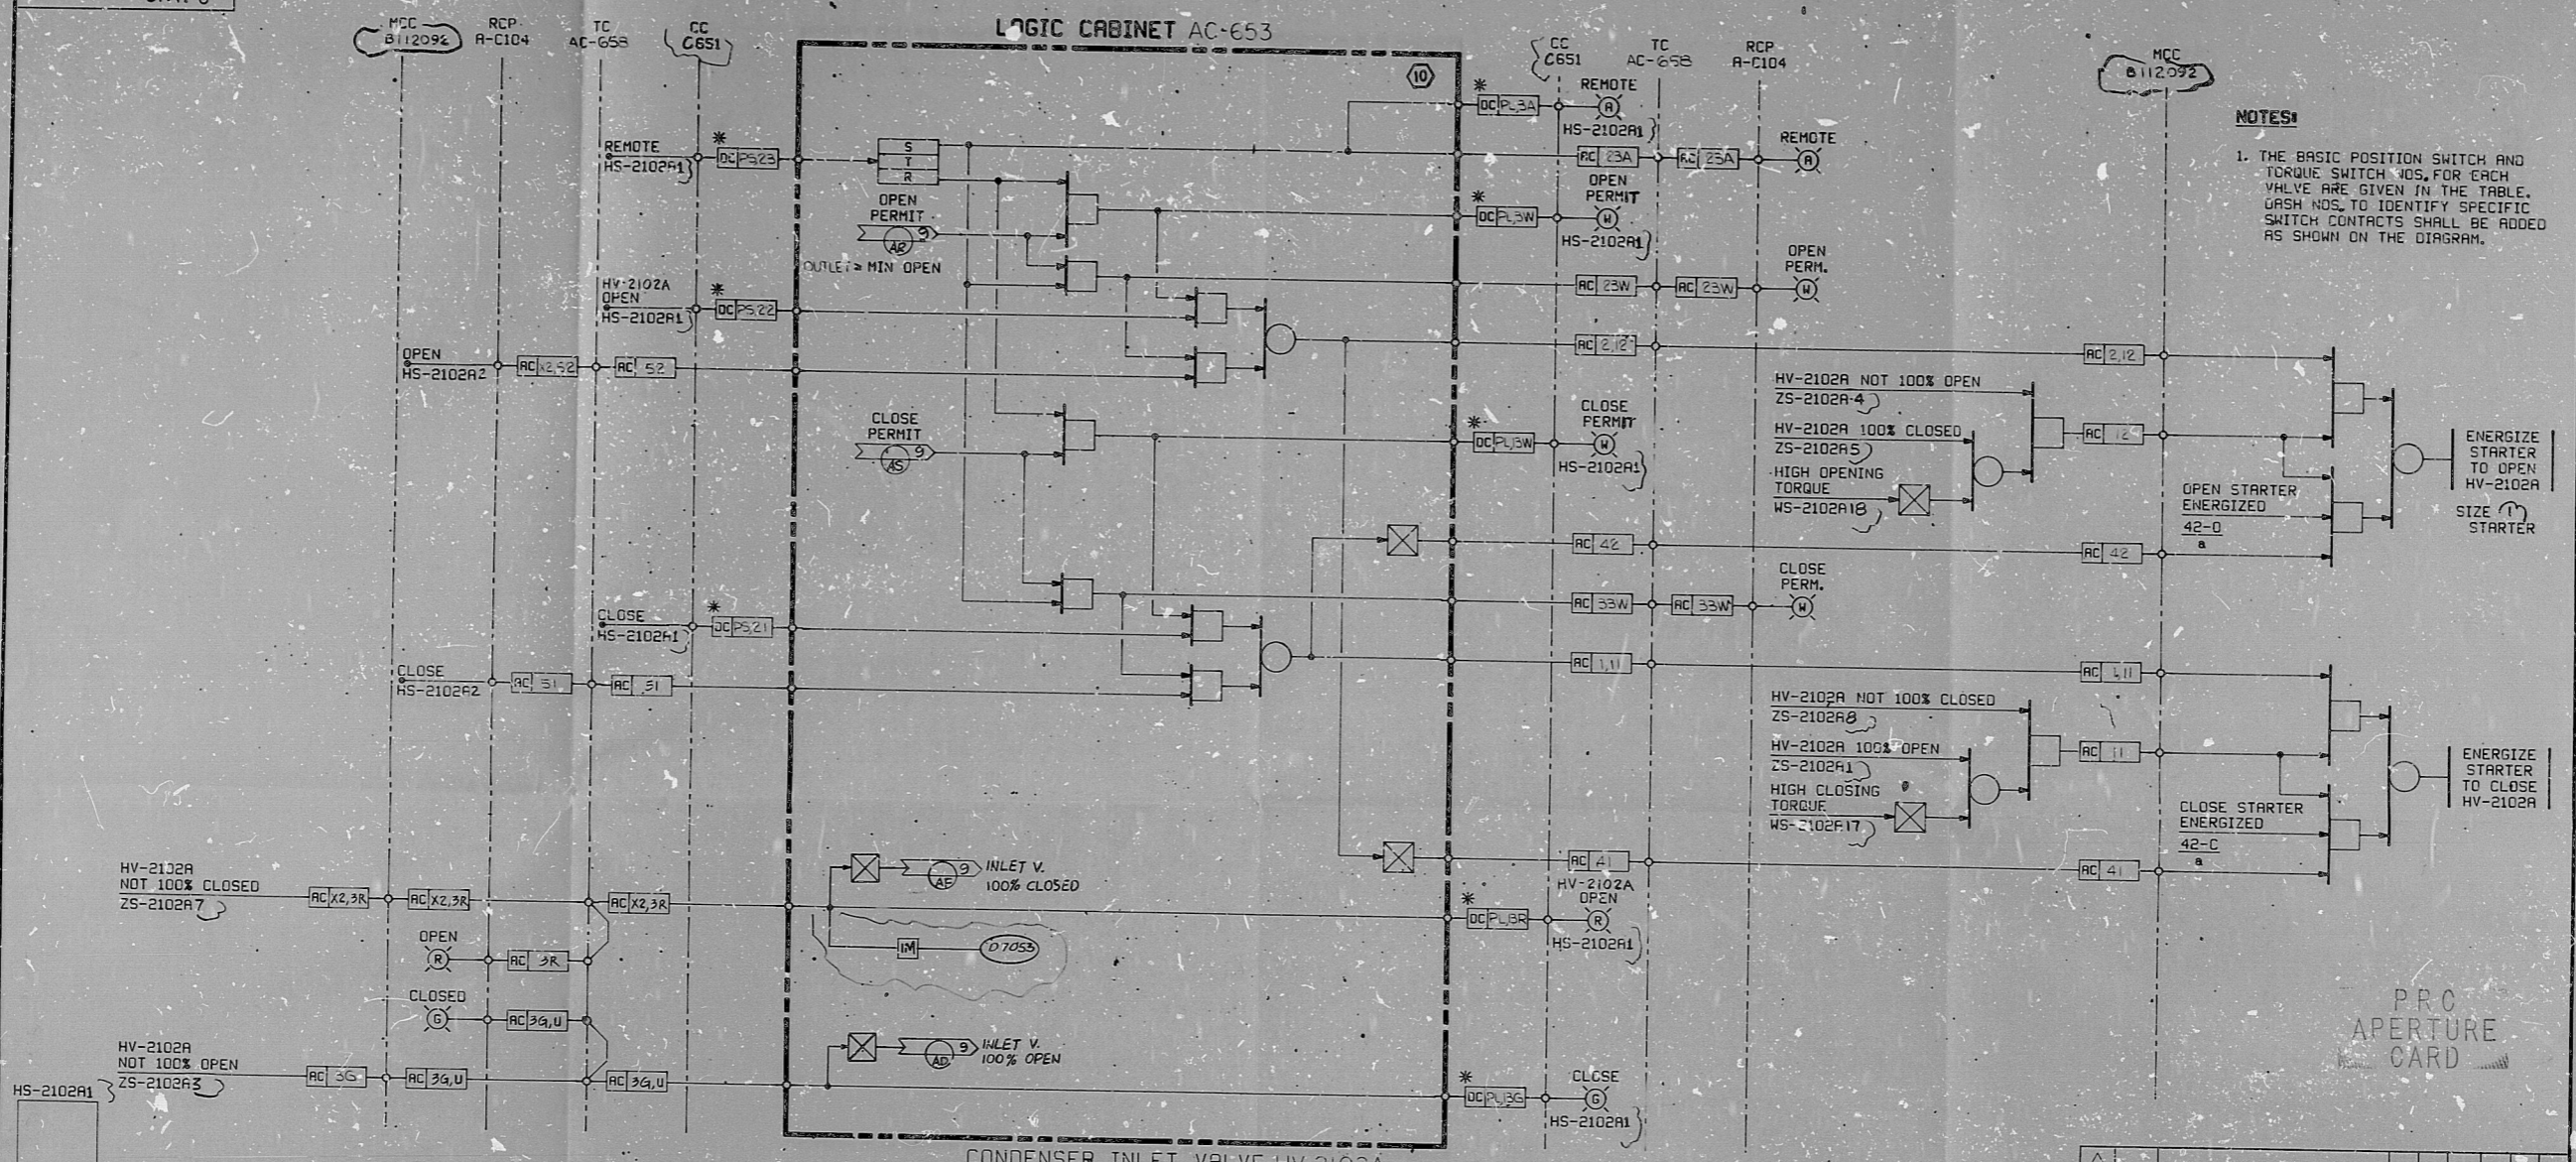


NOTES:
 1. THE BASIC POSITION SWITCH AND TORQUE SWITCH NOS. FOR EACH VALVE ARE GIVEN IN THE TABLE. OPEN NOS. TO IDENTIFY SPECIFIC SWITCH CONTACTS SHALL BE ADDED AS SHOWN ON THE DIAGRAM.

P.P.C. APERTURE CARD

CROSS REFERENCE TABLE

VALVE NO.		HAND. SW.		POSITION SW (NOTE 1)	TORQUE SW (NOTE 1)	LOGIC CABINET	CC	TC	RCP	MCC	CIRCUIT NO.	ERF COMP INPUT ID.
INLET	OUTLET	CONT. RM.	REMOTE									
HV-2102A	HV-2104A	HS-2102A1	HS-2102A2	ZS-2102A	WS-2102A	AC-653	C651	AC-653	A-C104	B112092	10	D7053
HV-2103A	HV-2105A	HS-2103A1	HS-2103A2	ZS-2103A	WS-2103A	AC-653	C651	AC-653	A-C104	B112093	11	D7054
HV-2102B	HV-2104B	HS-2102B1	HS-2102B2	ZS-2102B	WS-2102B	BC-653	C651	BC-653	B-C104	B42092	12	D7055
HV-2103B	HV-2105B	HS-2103B1	HS-2103B2	ZS-2103B	WS-2103B	BC-653	C651	BC-653	B-C104	B42093	13	D7056
HV-2102C	HV-2104C	HS-2102C1	HS-2102C2	ZS-2102C	WS-2102C	CC-653	C651	CC-653	C-C104	B122092	14	D7057
HV-2103C	HV-2105C	HS-2103C1	HS-2103C2	ZS-2103C	WS-2103C	CC-653	C651	CC-653	C-C104	B122093	15	D7058

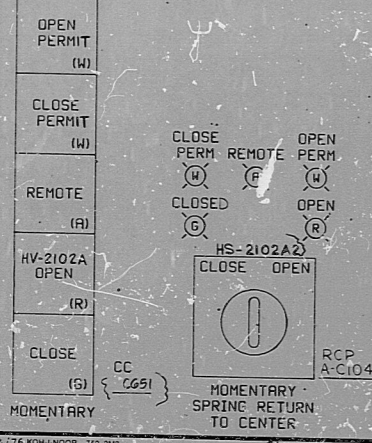

NO.	DATE	REVISIONS	BY	CHKD	DESIGN	ENGR	PROJ	APPR
1	1/14/72	DESIGN FREEZE ISSUE	KM	SPB	SPB	SPB	SPB	SPB
2	1/17/72	REVISED AS NOTED	DL	DL	DL	DL	DL	DL
3	1/17/72	REVISED AS NOTED	DL	DL	DL	DL	DL	DL
4	1/17/72	ISSUED FOR CONSTRUCTION	DL	DL	DL	DL	DL	DL

SCALE: NONE DESIGNED: DWH DRAWN: RCG

BECHTEL
 SAN FRANCISCO

PUBLIC SERVICE ELECTRIC AND GAS COMPANY
 HOPE CREEK GENERATING STATION

LOGIC DIAGRAM
 CIRCULATING WATER SYSTEM
 CONDENSER INLET VALVES

JOB No.	DRAWING No.	REV.
10855	J-09-0 SHT. 8	3

S/U - DA

4776 WOH1400R-710 2/68

22 X 34 "D" SIZE

RIDS

8100870018

