


J-09-0 SHT. 20

RCP C520

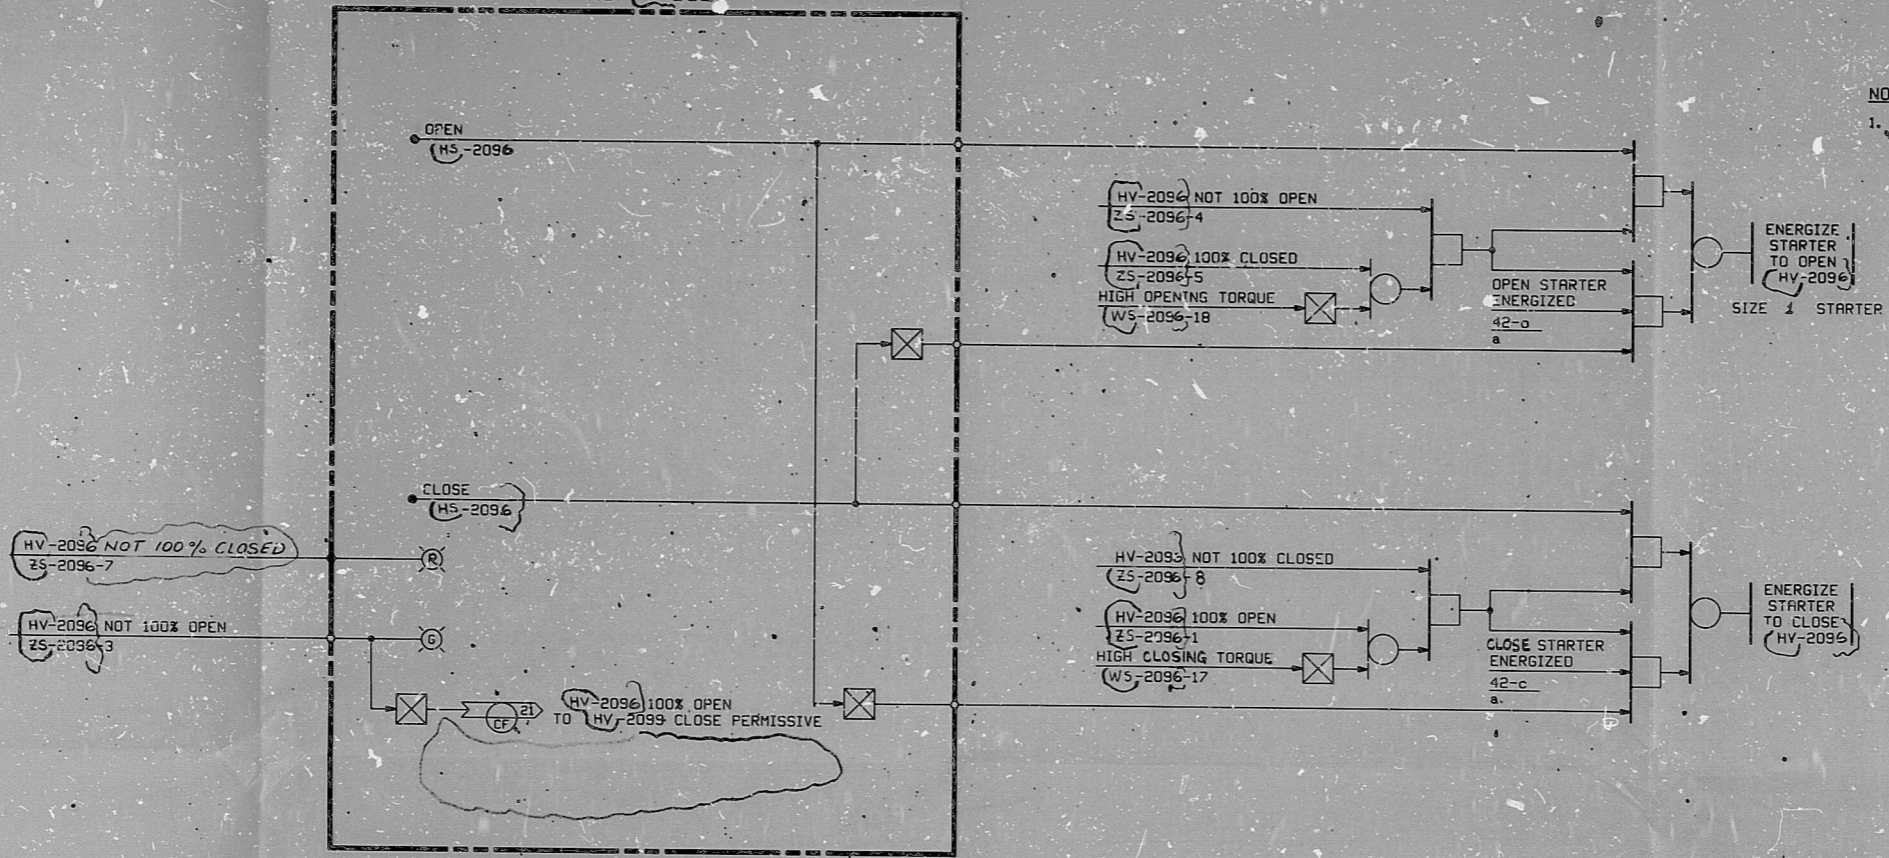

NOTES:  
1. DELETED

COOLING TOWER BASIN MAKEUP TO RIVER VALVE HV-2096

CROSS REFERENCE TABLE

VALVE NO.	SERVICE	HAND SW.	RCP	STARTER SIZE	S/U CODE
HV-2096	COOLING TOWER BASIN MAKEUP TO RIVER	HS-2096	C520	1	DA
HV-2098	COOLING TOWER BASIN MAKEUP TO INTAKE STRUCTURE	HS-2098	C520	1	EA



PRO APERTURE CARD

DESIGNED	I.J.L.	DRAWN	REG.
<b>BECHTEL</b> SAN FRANCISCO			
PUBLIC SERVICE ELECTRIC AND GAS COMPANY HOPE CREEK GENERATING STATION			
LOGIC DIAGRAM CIRCULATING WATER SYSTEM COOLING TOWER BASIN MAKEUP VALVES			
JOB No.	DRAWING No.	REV.	
10855	J-09-0SHT. 20	1	

S/U - EA, DA

This drawing and the design it covers are the property of BECHTEL. They are hereby loaned and on the borrower's express agreement that they will not be reproduced, copied, loaned, exhibited, nor used except in the limited way and private use permitted by any written consent given by the borrower.

22 x 34 1/2" SIZE



RIDS

8307280045

