


J-09-0 SHT. 21

RCP C-20


NOTES:
1. DELETED

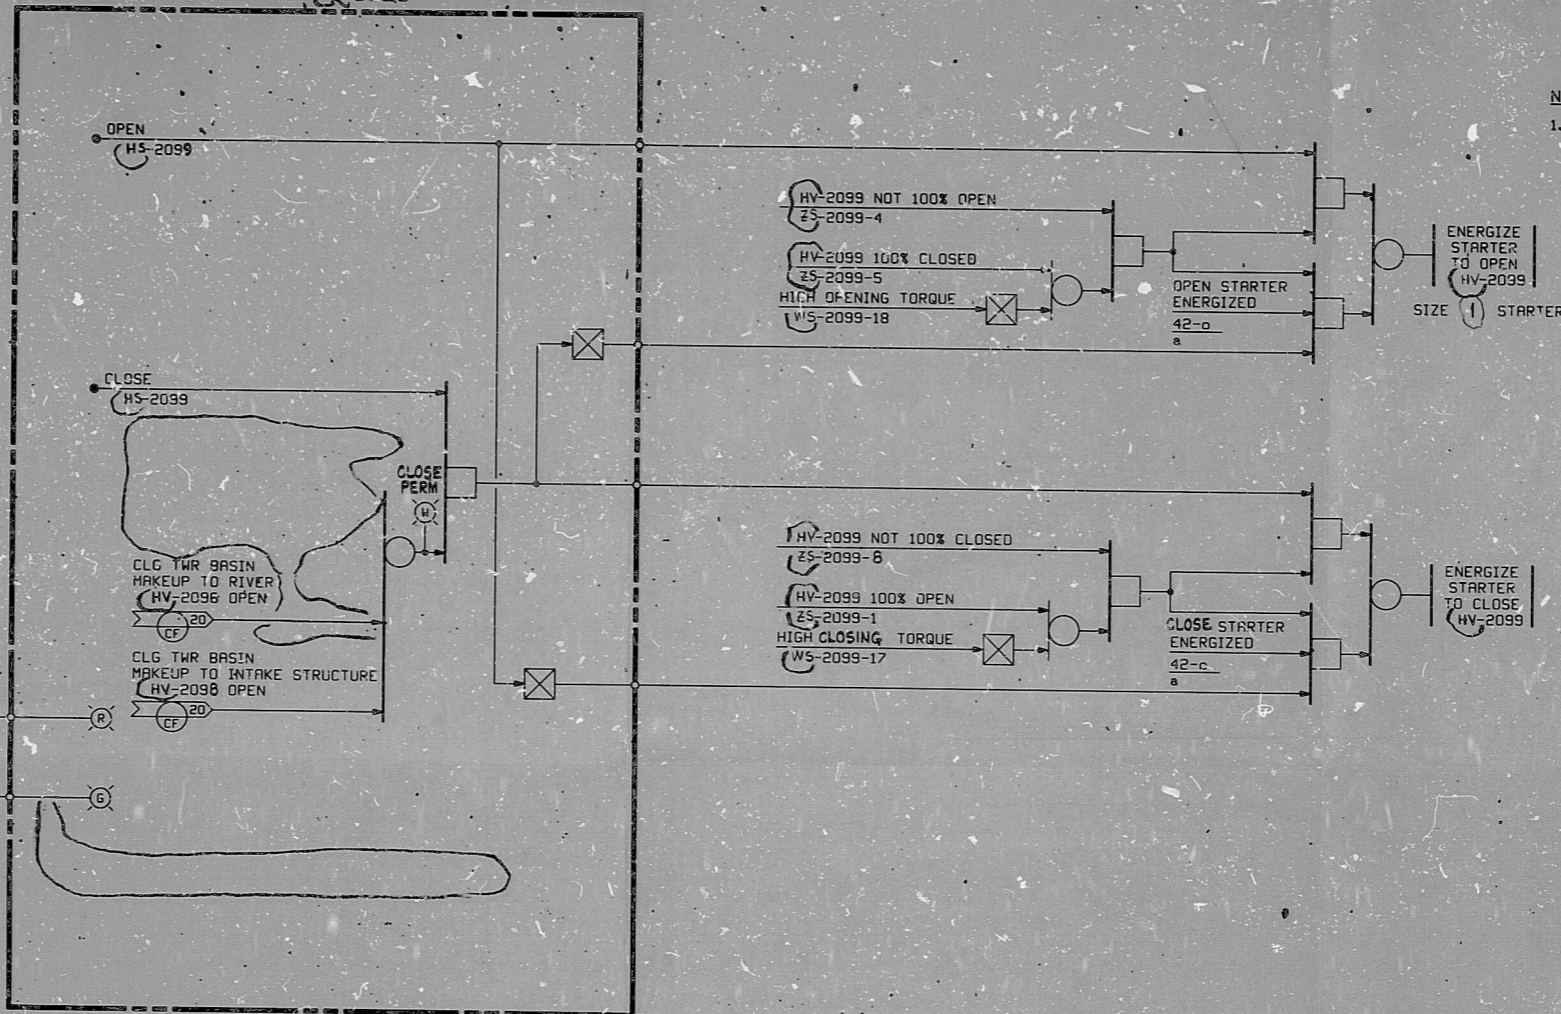

HV-2099 NOT 100% CLOSED ES-2099-7
HV-2099 NOT 100% OPEN ES-2099-3

P.R.C.
APERTURE
CARD

COOLING TOWER BASIN MAKEUP VALVE HV-2099

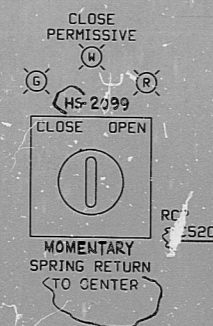

DESIGN	7/10/82	DESIGN FREEZE ISSUE	BY: JF	CHKD: JF	ENGR: JF	APPD: JF
ISSUED FOR CONSTRUCTION	7/6/87	THIS SHEET ADDED	BY: CH	CHKD: CH	ENGR: CH	APPD: CH
SCALE	NONE	DESIGNED	I.J.L.	DRAWN	R.C.G.	
BECHTEL SAN FRANCISCO						
PUBLIC SERVICE ELECTRIC AND GAS COMPANY HOPE CREEK GENERATING STATION						
LOGIC DIAGRAM CIRCULATING WATER SYSTEM COOLING TOWER BASIN MAKEUP VALVE						
JOB No.	DRAWING No.		REV.			
10855	J-09-0 SPT. 21		1			

S/U - ER

22 x 34 "U" SIZE

RIDS

8307289047

