


22"
17"
11"
8.5"
8.5"
17"
22"

22"
17"
11"
8.5"
8.5"
17"
22"

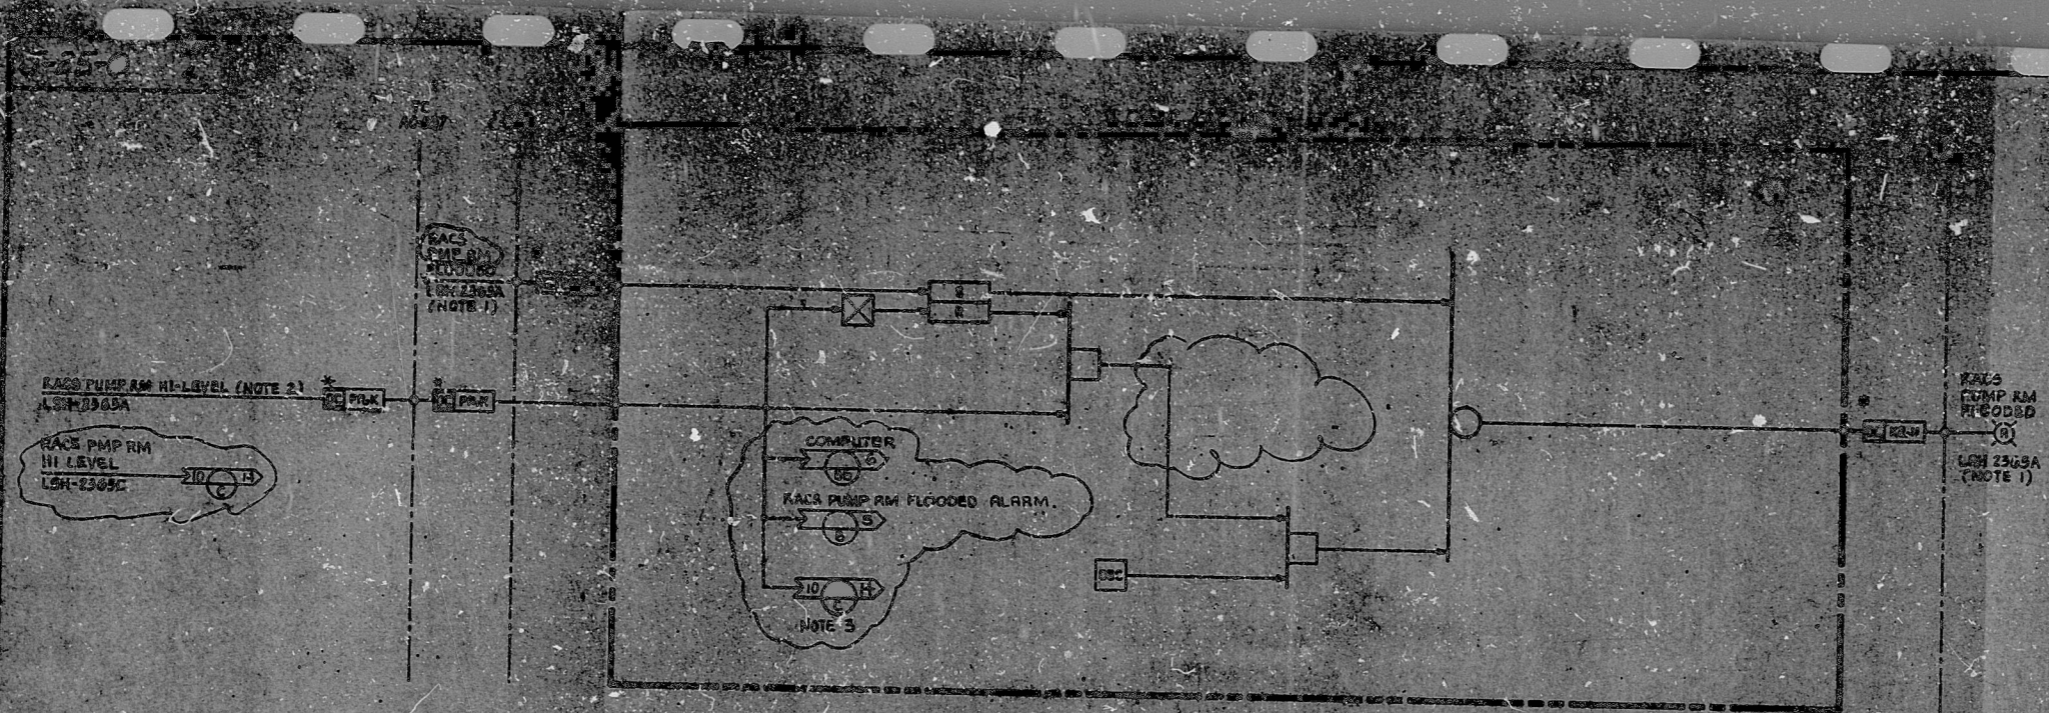

RACS PUMP ROOM FLOODING ALARM
CLASS 1E CHANNEL

- NOTES:**
1. REFER TO CROSS REFERENCE TABLE BELOW FOR COMPLETE PUMP RM FLOODING ALARM LAYOUT SW. LAYOUT REFERENCE.
 2. THESE SWITCH CONTACTS OPEN UPON THE CONDITION STATED.
 3. APPLICABLE TO LSH 2365A & B ONLY.


CROSS REFERENCE TABLE

SERVICE	LEVEL SWITCH / ALM LSH/LAH	CLASS 1E CHANNEL	IC NO.	CIRCUIT NO.	LOGIC CABINET	ALARM LIGHT ACK SW LAYOUT	LEVEL SWITCH INTERLOCK (PROVIDED)	CONTROL COUPLER
RACS ROOM HI-LEVEL	2365A	A	AC-697	9	AC-697			
RACS ROOM HI-LEVEL	2365B	B	DC-697	10	DC-697			
SACS RX AND PUMP ROOM A-4909 HI-LEVEL	2365A	A	AC-697	11	AC-697	J-11-C SWT 2		
SACS RX AND PUMP ROOM A-4909 HI-LEVEL	2365B	B	DC-697	12	DC-697	J-11-D SWT 4		
SACS RX AND PUMP ROOM B-4907 HI-LEVEL	2365A	A	AC-697	13	AC-697	J-13-C SWT 2		
SACS RX AND PUMP ROOM B-4907 HI-LEVEL	2365B	B	DC-697	14	DC-697	J-13-D SWT 4		
SERVICE WATER INTAKE STRUCT. A & C PMP RM HI-LVL	2370A	A	AC-697	15	AC-697	J-15-D SWT 2		
SERVICE WATER INTAKE STRUCT. B & D PMP RM HI-LVL	2372A	B	DC-697	16	DC-697	J-16-D SWT 4		
SERVICE WATER INTAKE STRUCT. C & D PMP RM HI-LVL	2372B	D	DC-697	18	DC-697	J-18-D SWT 4		
DC EQUIP ROOM 5205 HI-LEVEL	4444-1	A	AC	12	AC	SEE TYPICAL DC EQUIP RM MODULE		
5208	44-12	A	AC	19	AC			
5209	45-11	B	DC	20	DC			
5210	45-12	B	DC	21	DC			
5210	54-11	C	CC	22	CC			
5210	54-12	C	CC	23	CC			
5211	51-1	D	DC	24	DC			
5211	51-12	D	DC	25	DC			


TYPICAL DC EQUIPMENT RM ALARM MODULE



TYPICAL RACS PMP RM ALARM MODULE

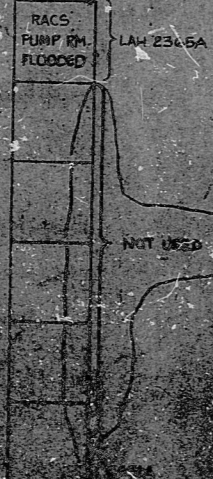

APPROPRIATE
GARD

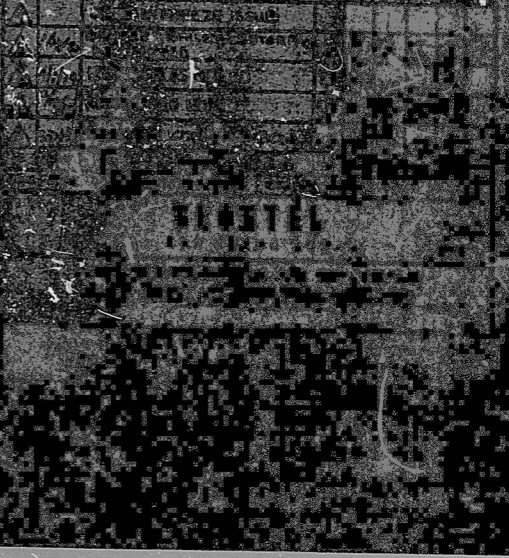

RIDS

8307280976

