
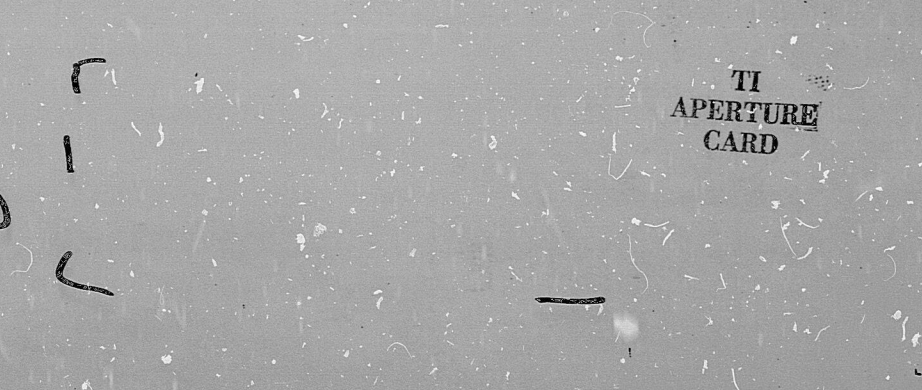
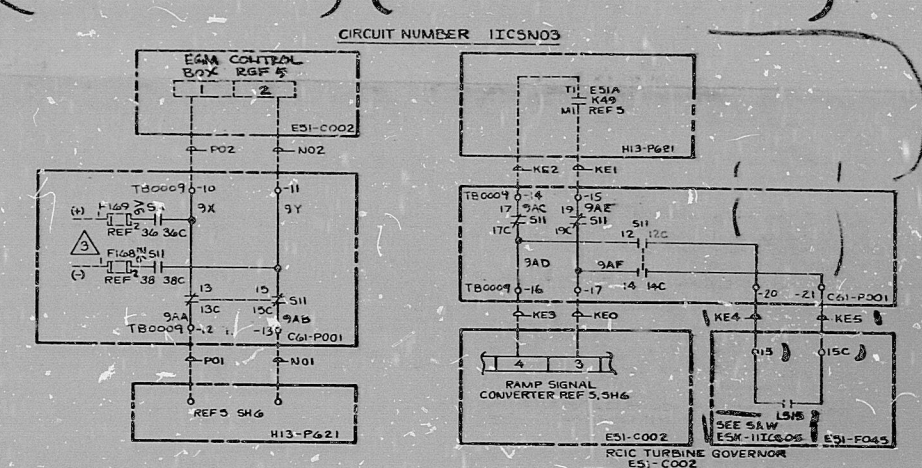
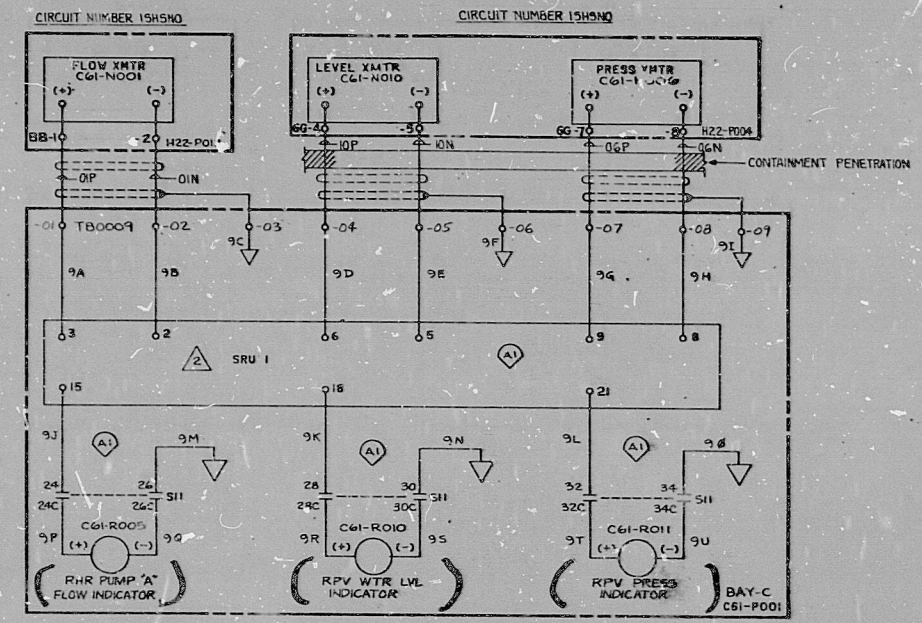


(D1) UNLESS OTHERWISE INDICATED ON THIS SHEET

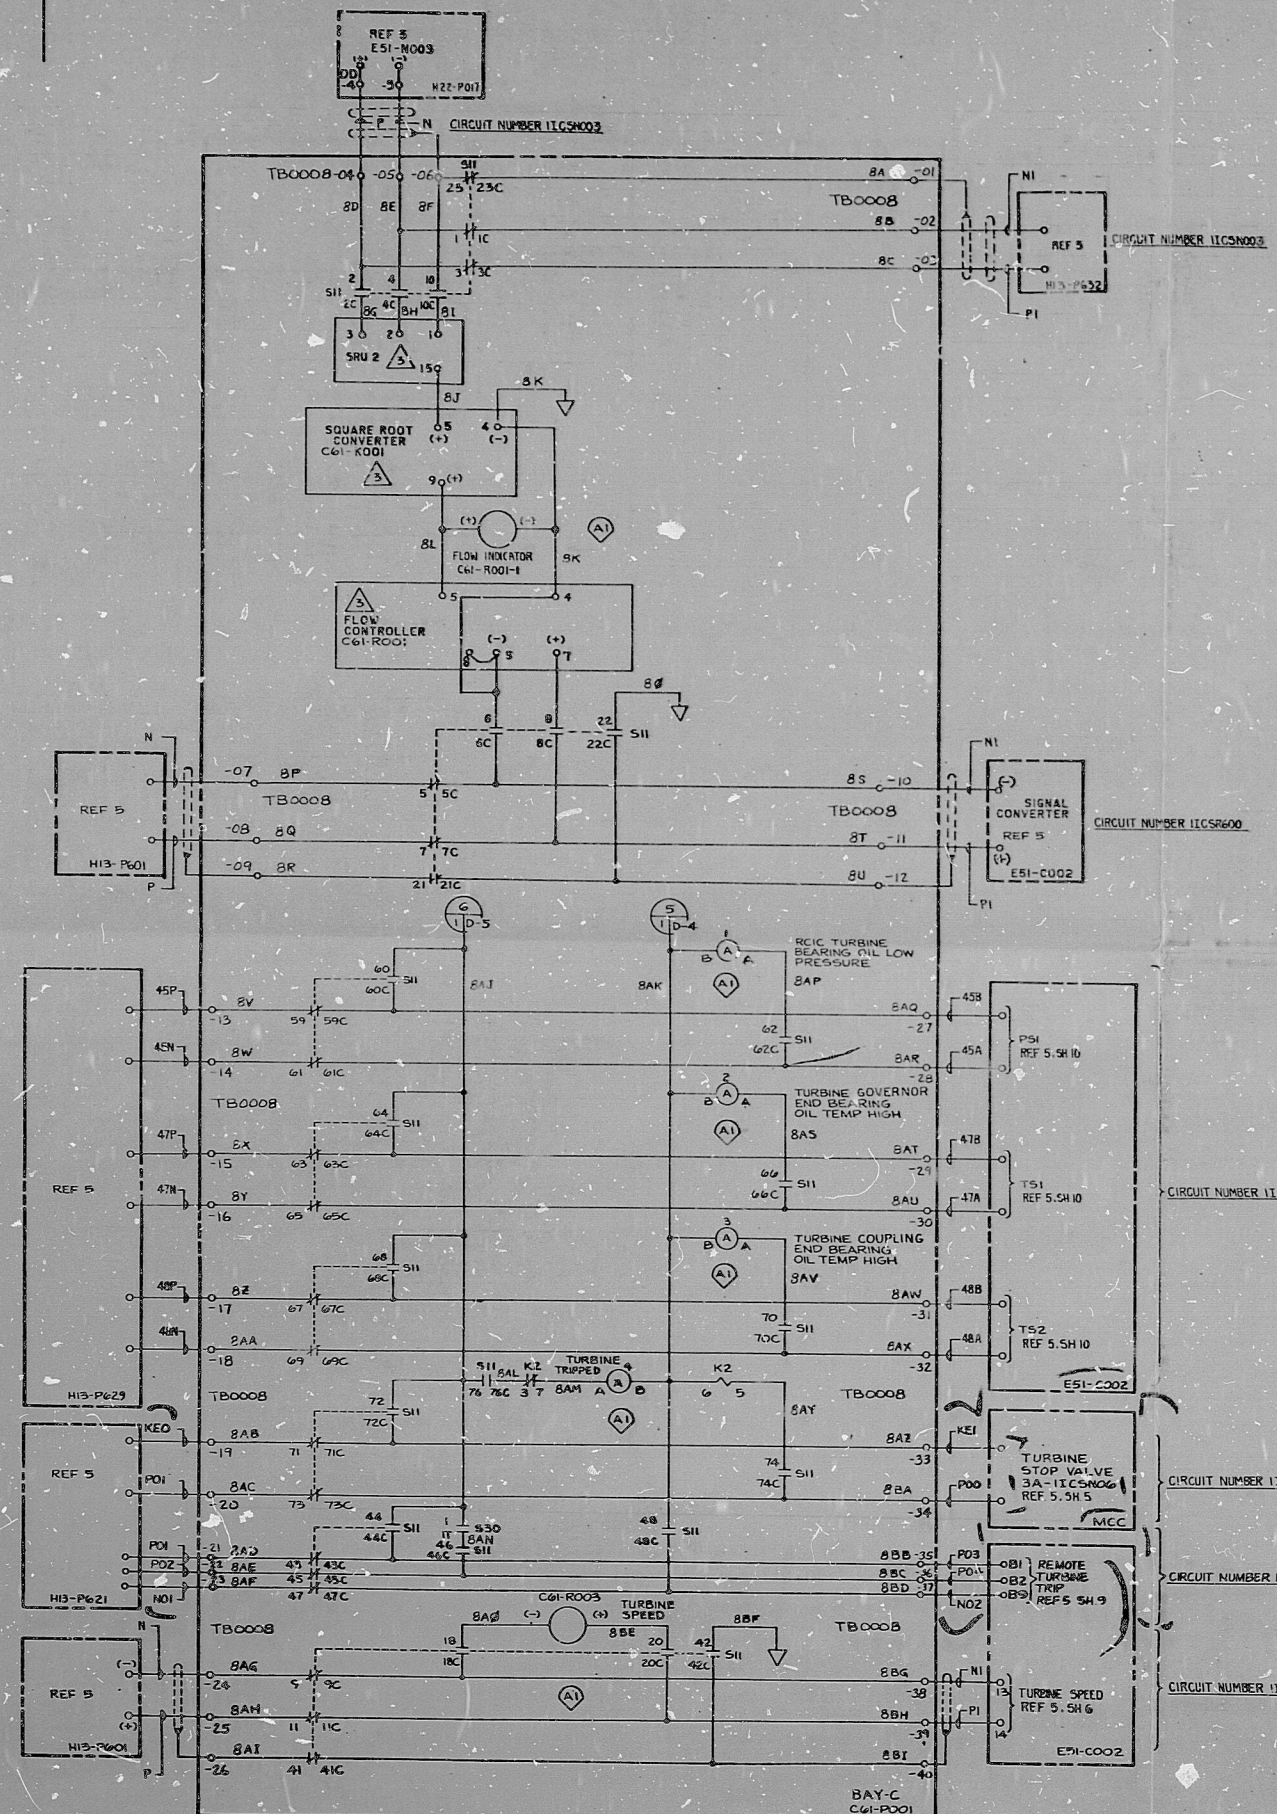

RCIC TURBINE FLOW CONTROL AND INDICATION

TI APERTURE CARD

LINE CODES: 8,9,30

NO.	DATE	BY	CHKD.	APP'D.	REVISION
7	11/10/82
3	11/10/82
2	11/10/82
1	11/10/82

8412190260

PDR RIDS

