


This drawing and its design it covers are the property of BECHTEL. They are hereby loaned and on the borrower's express agreement that they will not be reproduced, copied, loaned, exhibited, or used except in the limited way and extent permitted by any written consent given by the lender to the borrower.

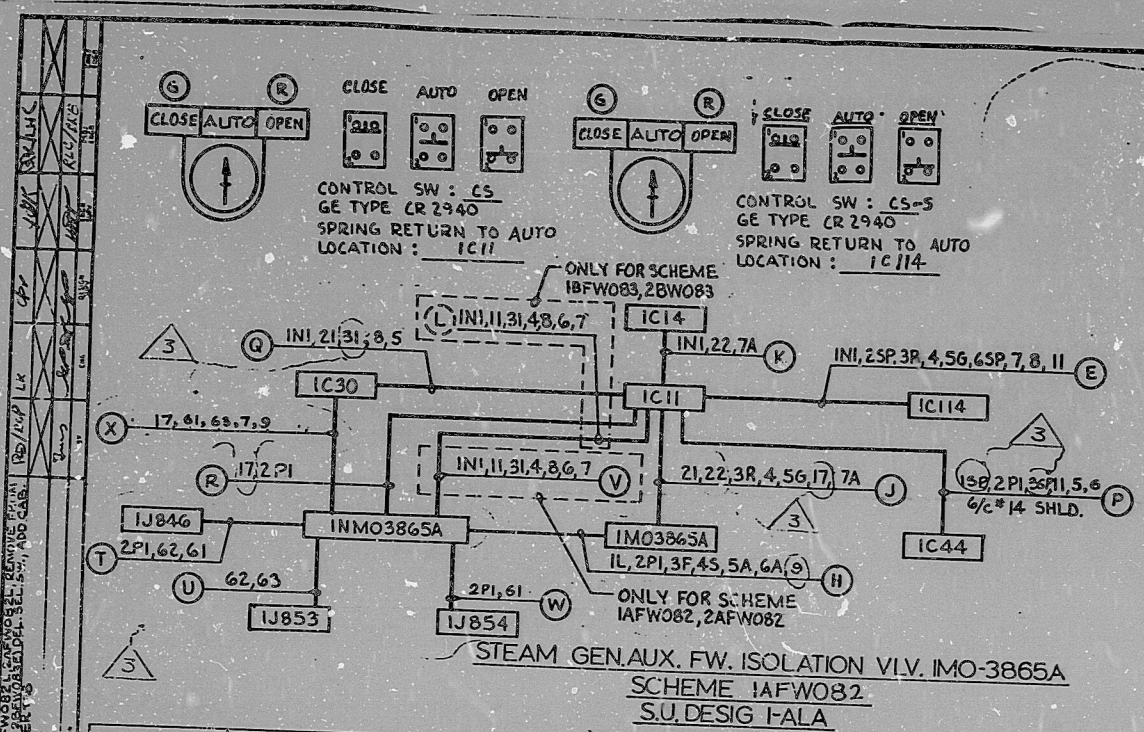

VALVE #5 DEVELOPMENT

ACTOR	CONT. NO.	VALVE POSITION		
		CLOSE	INTER. MED.	OPEN
1	1			
	2			
	3			
	4			
	5			
2	6			
	7			
	8			
	9			
3	10			
	11			
	12			
	13			
	14			
	15			
	16			
4	17			
	18			

DENOTES SPARE

ADAPTER TABLE

VALVE No.	SCHEME No.	AFWAS		FOGG INTLK.		STEAM GEN. LVL. INTLK.		125V DC POWER				
		RELAY	E-375	CHA. NO.	REL. NO.	SCHEME NO.	E-158	PANEL	BKR.			
IMO-3865A	IAFW082	K612	SH.63	A	95-1	ICFW145	SH.43	95-1,95-2	ICFW158	SH.48	ID11	72-14
IMO-3865B	IBFW083	K612	SH.70	B	95-2	IDFW146	SH.43	95-1,95-2	IDFW159	SH.48	ID21	72-16
2MO-3965A	2AFW082	K612	SH.67	A	95-1	2CFW145	SH.43	95-1,95-2	2CFW158	SH.48	2D11	72-14
2MO-3965B	2BFW083	K612	SH.74	B	95-2	2DFW146	SH.43	95-1,95-2	2DFW159	SH.48	2D21	72-16

ADAPTER TABLE

LOCATIONS										S. U. DESIG.
IC11	IC14	IC30	IC44	IC114	IM03865A	INM03865A	IJ846	IJ853	IJ854	
IC11	IC14	IC30	IC44	IC114	IM03865B	INM03865B	IJ837	IJ855	IJ856	I-ALA
2C11	2C14	2C30	2C44	2C114	2M03965A	2NM03965A	2J1123	2J1130	2J1131	2-ALA
2C11	2C14	2C30	2C44	2C114	2M03965B	2NM03965B	2J1114	2J1132	2J1133	2-ALA

TERA APERTURE CARD

BECHTEL
ANN ARBOR, MICHIGAN

MIDLAND PLANT UNITS 1 & 2
CONSUMERS POWER COMPANY

SCHMATIC DIAGRAM
AUX. FEEDWATER SYSTEM VALVES

JOB No.	DRAWING No.	REV.
7220	E158(Q)	SH 3

16X

I certify that the image contained on this frame was made in the normal and regular course of business, on the date stated below and that it is an accurate reproduction of the document submitted to the contractor for filming, by Bechtel Power Corporation.

10-28-81 DATE
R. Caselle CAMERA OPERATOR
M. Adams CONTRACTOR'S SUPERVISOR OR MANAGER

RIDS

8112230242

