


This drawing and the design it covers are the property of BECHTEL. They are hereby loaned and on the borrower's express agreement that they will not be reproduced, copied, loaned, exhibited, or used except in the limited way and private use permitted by any written consent given by the lender to the borrower.

16-4-81	ISSUED FOR CONSTRUCTION	REV	BY	CHK	DATE
15-12-80	ADDED FIELD JUMPER NOTE	1	JKS	JKS	12/15/80
14-12-80	REVISED	2	JKS	JKS	12/15/80
14-12-80	REVISED	3	JKS	JKS	12/15/80

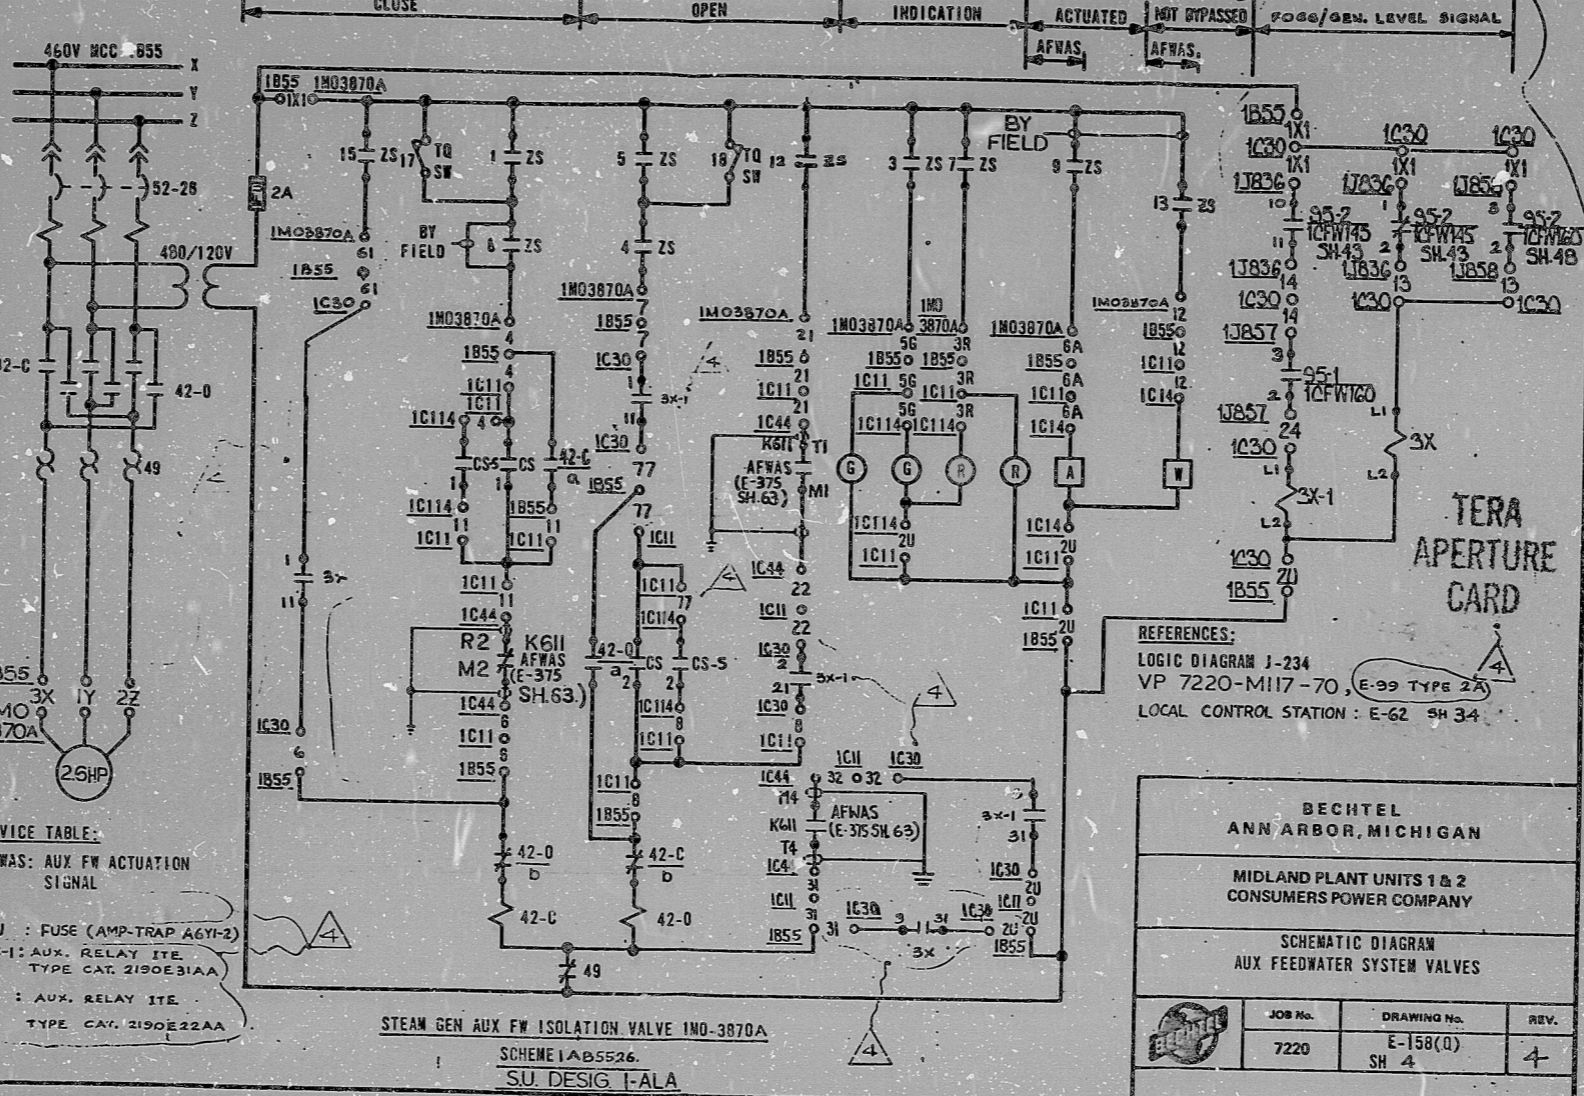

**DEVICE TABLE:**  
 AFWAS: AUX FW ACTUATION SIGNAL  
 FU : FUSE (AMP-TRAP A6VH-2)  
 3X-1: AUX. RELAY ITE TYPE CAT. 210E31AA  
 DX : AUX. RELAY ITE TYPE CAT. 210E22AA

**REFERENCES:**  
 LOGIC DIAGRAM J-234  
 VP 7220-M117-70 (E-99 TYPE 2A)  
 LOCAL CONTROL STATION : E-62 SH 34

BECHTEL ANN ARBOR, MICHIGAN		
MIDLAND PLANT UNITS 1 & 2 CONSUMERS POWER COMPANY		
SCHEMATIC DIAGRAM AUX FEEDWATER SYSTEM VALVES		
JOB No. 7220	DRAWING No. E-158(0) SH 4	REV. 4

**16X**

I certify that the image contained on this frame was made in the normal and regular course of business, on the date stated below and that it is an accurate reproduction of the document submitted to the contractor for filing, by Bechtel Power Corporation.

10-23-81 R. Caselle J. Alvarado  
 DATE CAMERA OPERATOR CONTRACTOR'S SUP'VR OR MANAGER



RIDS

8112230244

