

11

11

8.5"

8.5"

11

17"

11





11

8.5"

8.5"

11

17"

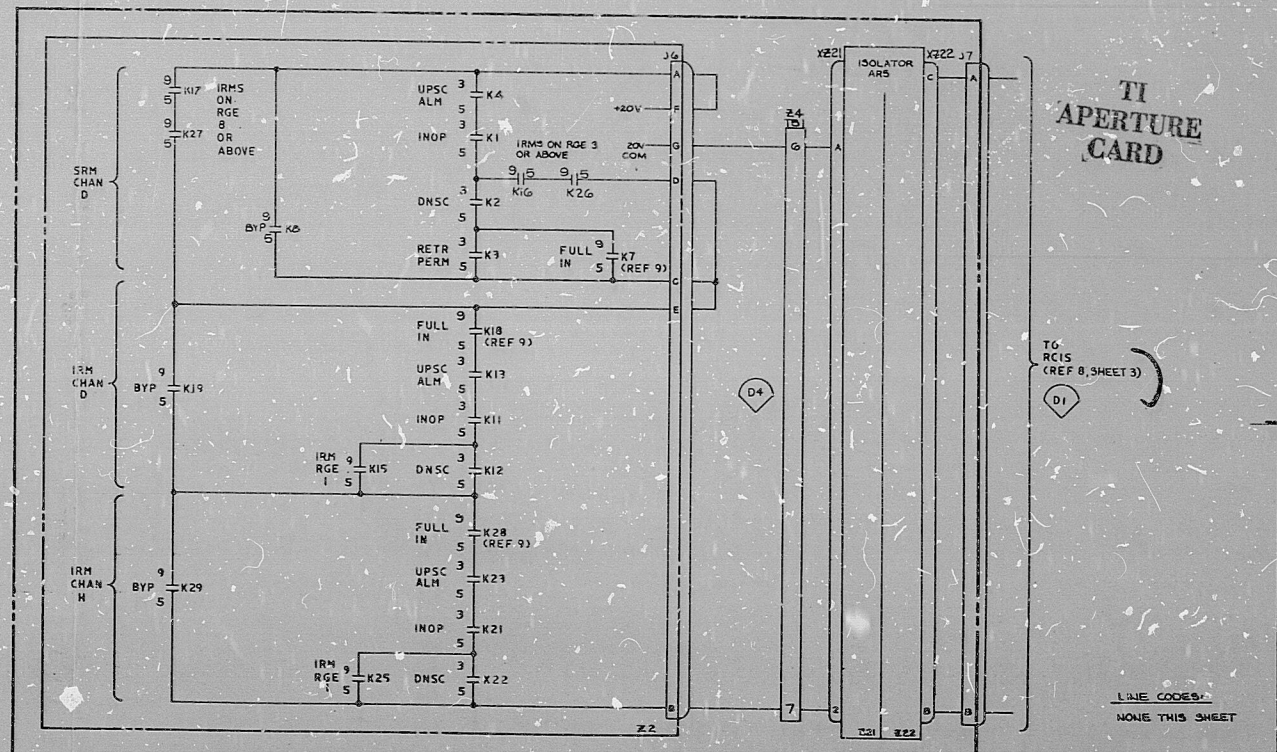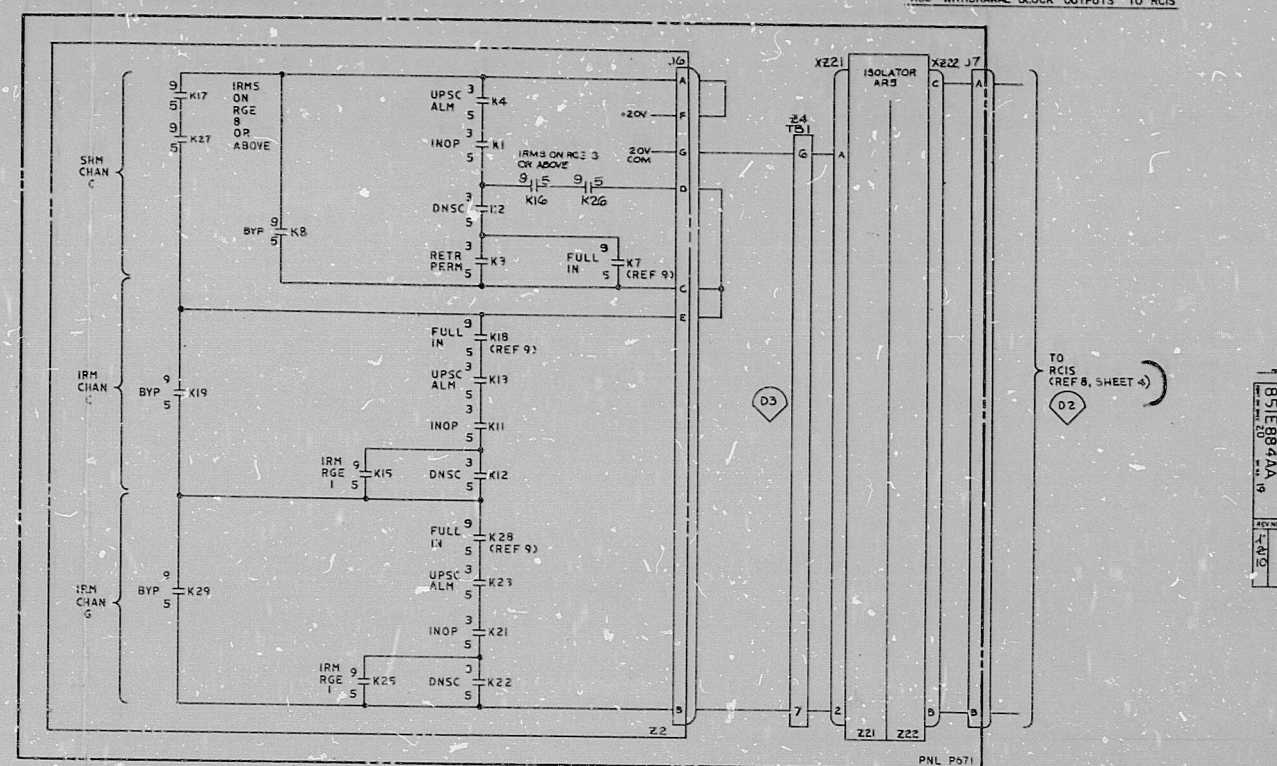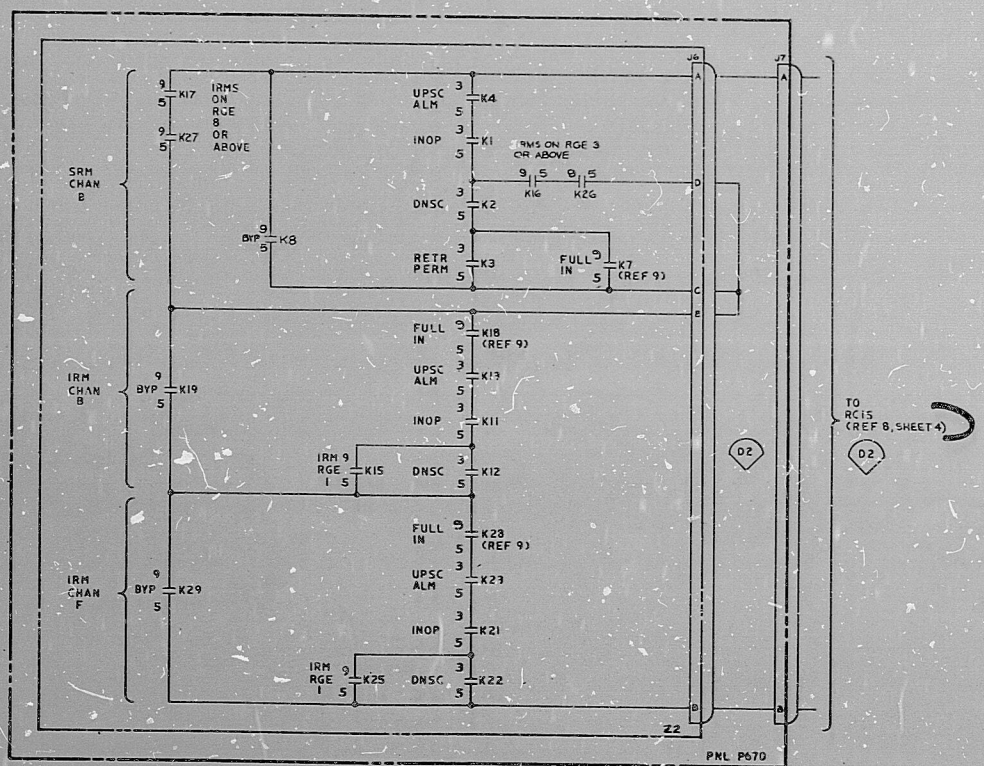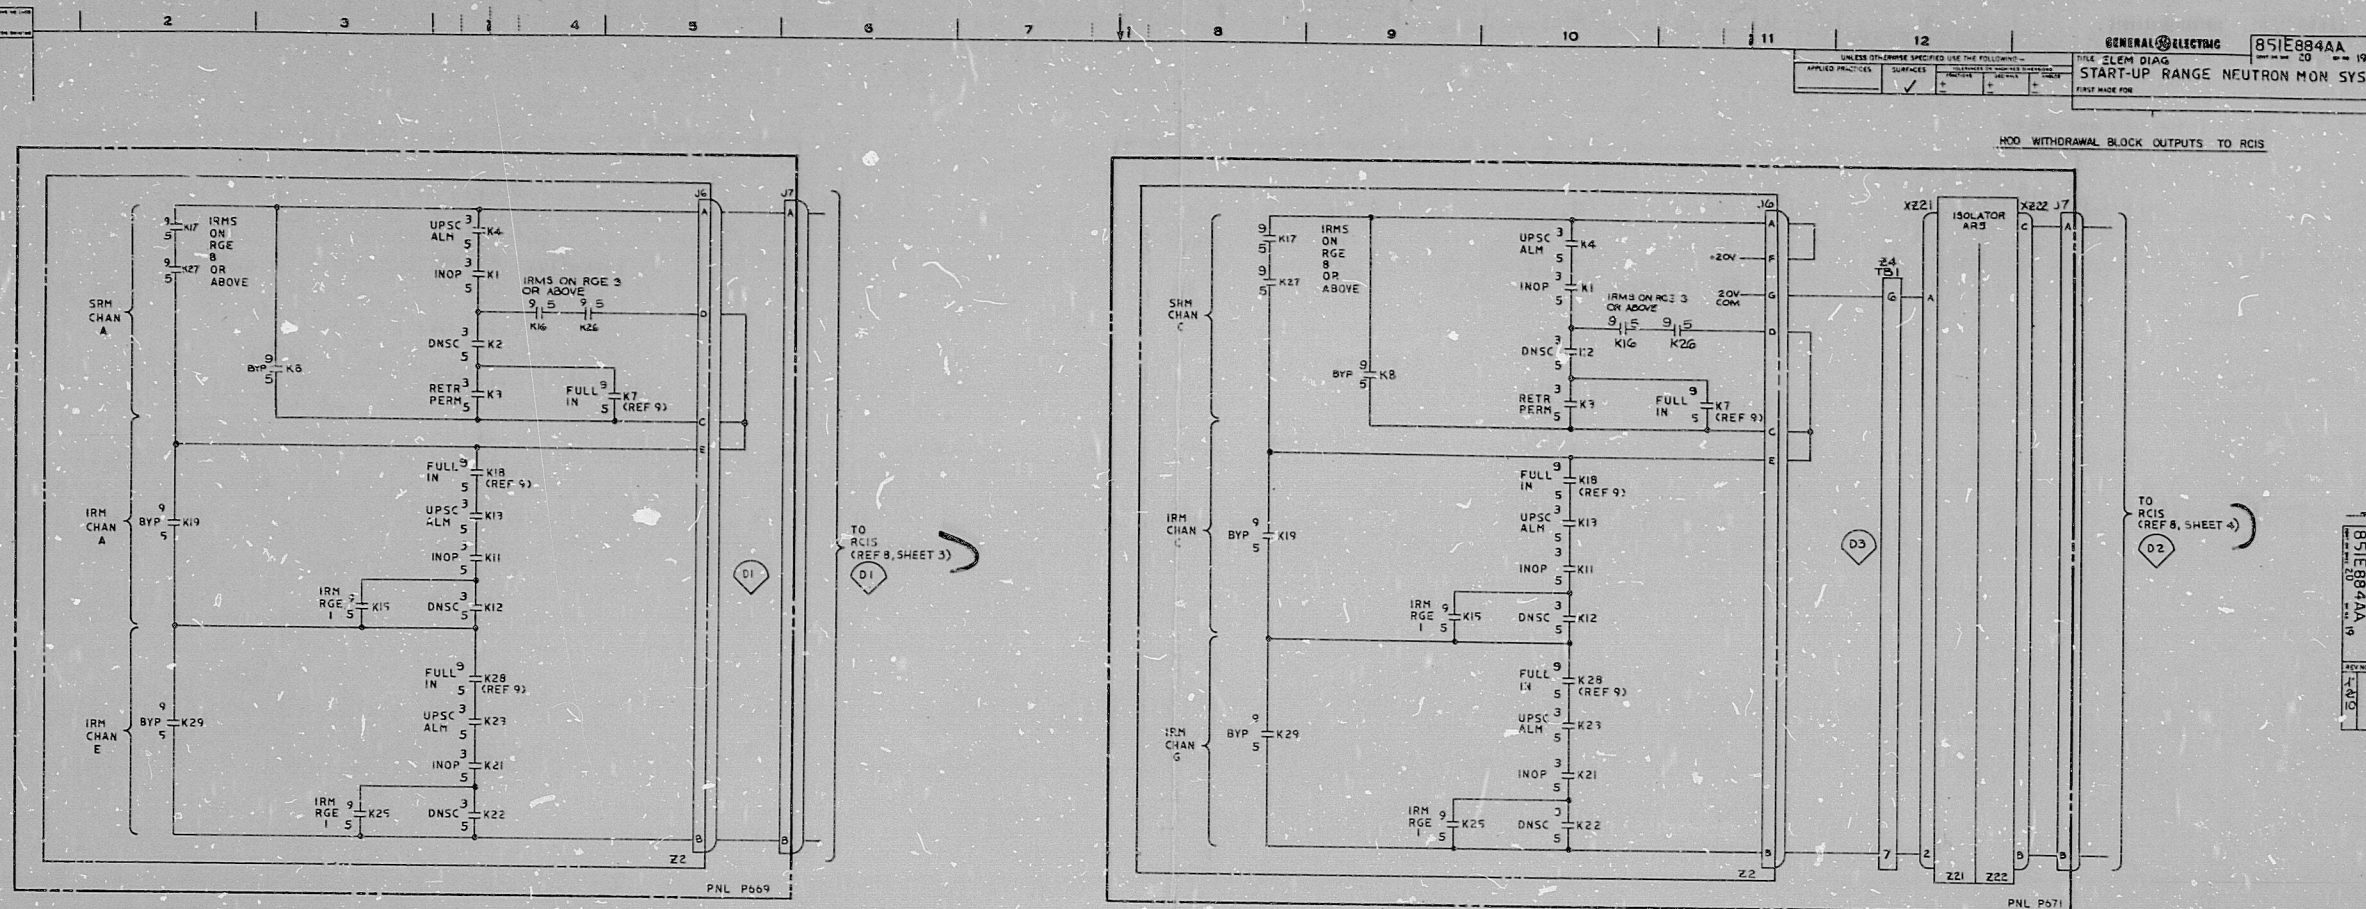

TI APERTURE CARD

TO RCIS (REF 8, SHEET 3)
 D1

LINE CODES:
 NONE THIS SHEET

NO.	DESCRIPTION	DATE	BY
10	NUS845 4-1		
11	RETRACTED WITH CHAS. COC. CHG.		
12	RETRACTED WITH CHAS. COC. CHG.		
13	CHAS. COC. CHG.		
14	CHAS. COC. CHG.		
15	CHAS. COC. CHG.		
16	CHAS. COC. CHG.		
17	CHAS. COC. CHG.		
18	CHAS. COC. CHG.		
19	CHAS. COC. CHG.		
20	CHAS. COC. CHG.		

851E884AA
 SAN JOSE
 CY EIC

8412190367

PDR RIDS

