


This drawing and the design it covers are the property of BECHTEL. They are hereby loaned and on the borrower's express agreement that they will not be reproduced, copied, loaned, established, or used except in the limited way and private use permitted by any written consent given by the issuer to the borrower.

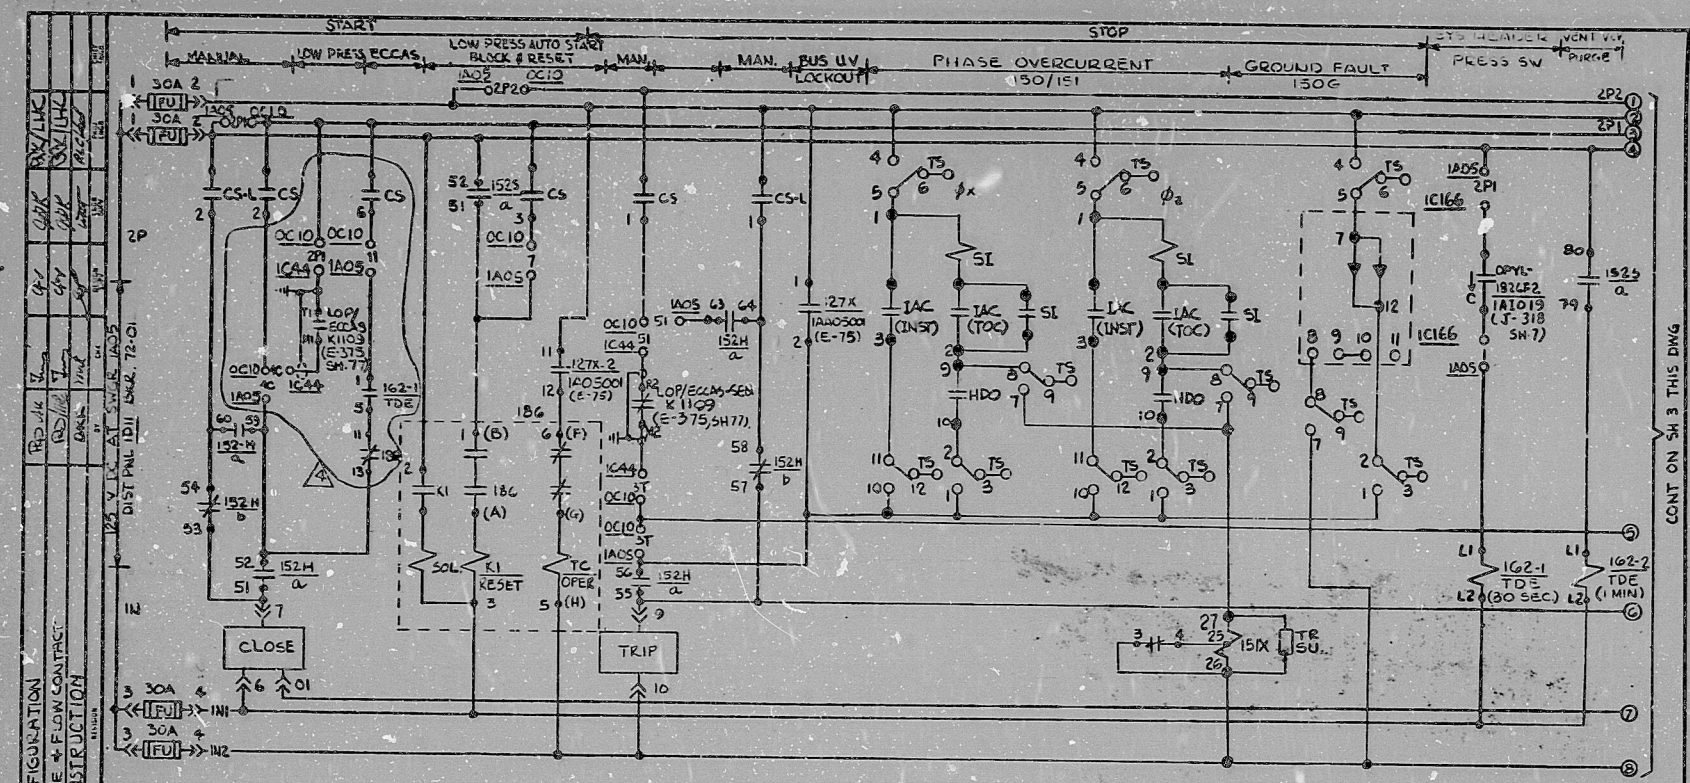

SERVICE WATER PUMP OP-75A
SCHEME IAA0503
SU DESIG O-EAA

REVISIONS	
4	4-1-81 REVISED CKT. CONFIGURATION
3	5-11-81 REVISED DEVICE TABLE & FLOW CONTROL
2	8-27-77 ISSUED FOR CONSTRUCTION

DEVICE TABLE:

OPYL-1826F2	: SYSTEM HEADER PRESS SW INTLK RELAY
IG2-1 & 2/TDE	: TIME DELAY RELAY, AGASTAT 7012 PD + 7012 PF.
18G	: ELECTRICAL RESET & LOCKOUT RELAY (ELECTRO SW LOR-7823)
LOP/ECCAS-SED	: LOSS OF OFF-SITE PWR & EMERGENCY CORE CLA ACTUATION SYS. SEQUENCER (STEP 5-15-80)
15IX	: OVERCURRENT ALARM RELAY (ITE-J13)
3X	: STATUS DISPLAY AUX RELAY (GE-HGA)
FU	: FUSE (CHASE SHAWMUT) A2K30

BECHTEL
ANN ARBOR, MICHIGAN

MIDLAND PLANT UNITS 1 & 2
CONSUMERS POWER COMPANY

SCHEMATIC DIAGRAM
SERVICE WATER PUMPS

JOB No.	DRAWING No.	REV.
7220	E-186(Q) ^{SH2}	4

TERA APERTURE CARD

I certify that the image contained on this frame was made in the normal and regular course of business, on the date stated below and that it is an accurate reproduction of the document submitted to reprographics.

DATE: 11/2/81 CAMERA OPERATOR: [Signature] SUPERVISOR OF REPROGRAPHICS: [Signature]

G-1348

16X

8.5"
11"
17"

8.5"
11"
17"

RIDS

8112230395

