


66 11
 66 11
 66 8
 8.5"
 11"
 17"

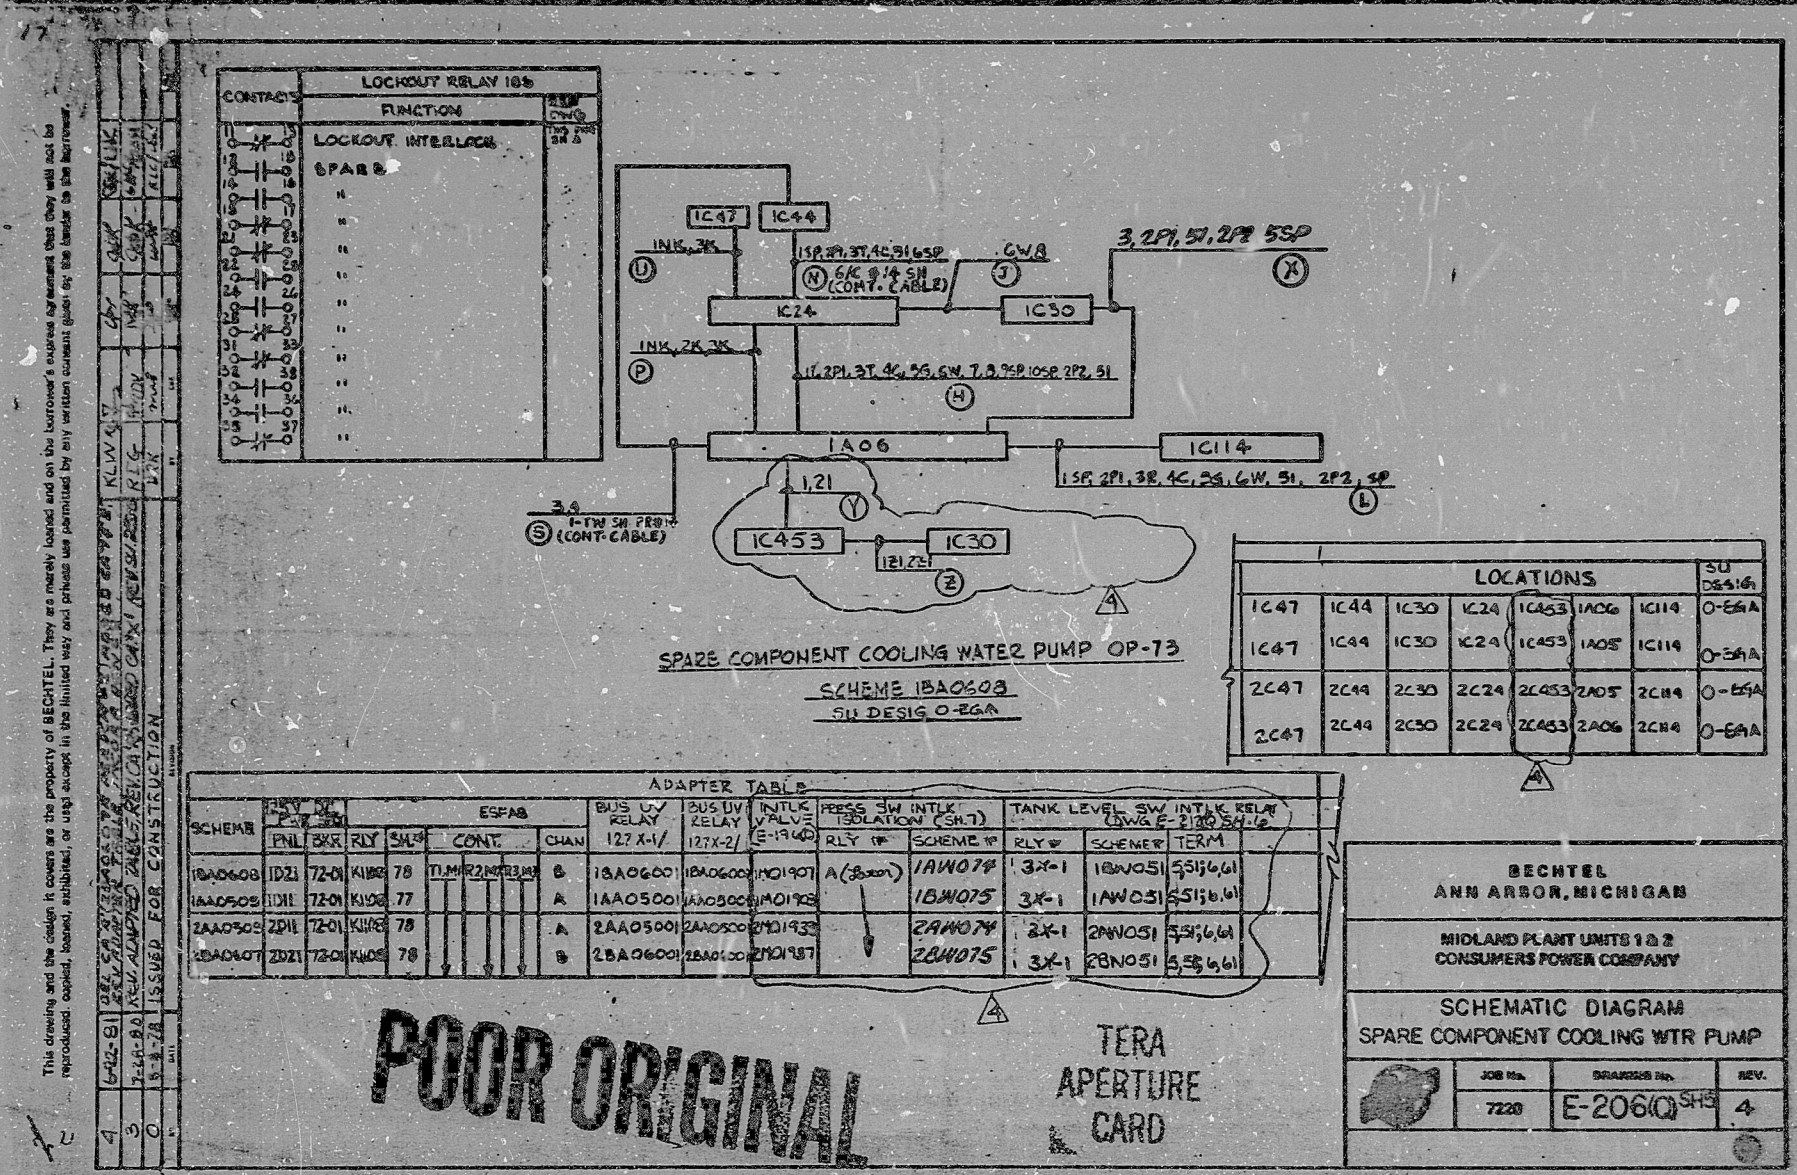

POOR ORIGINAL

TERA APERTURE CARD

16X

I certify that the image contained on this frame was made in the normal and regular course of business, on the date stated below and that it is an accurate reproduction of the document submitted to reprographics.

4-26-81 R. Capelle
 DATE CAMERA OPERATOR SUPERVISOR OF REPROGRAPHICS

0-1348

66 11
 66 11
 66 8
 8.5"
 11"
 17"

R:DS

8112230427

