


This drawing and the design it covers are the property of BECHTEL. They are hereby loaned and the borrower's express agreement that they will not be reproduced, copied, loaned, exhibited, or used except in the limited way and for the purposes intended by the lender in this document.

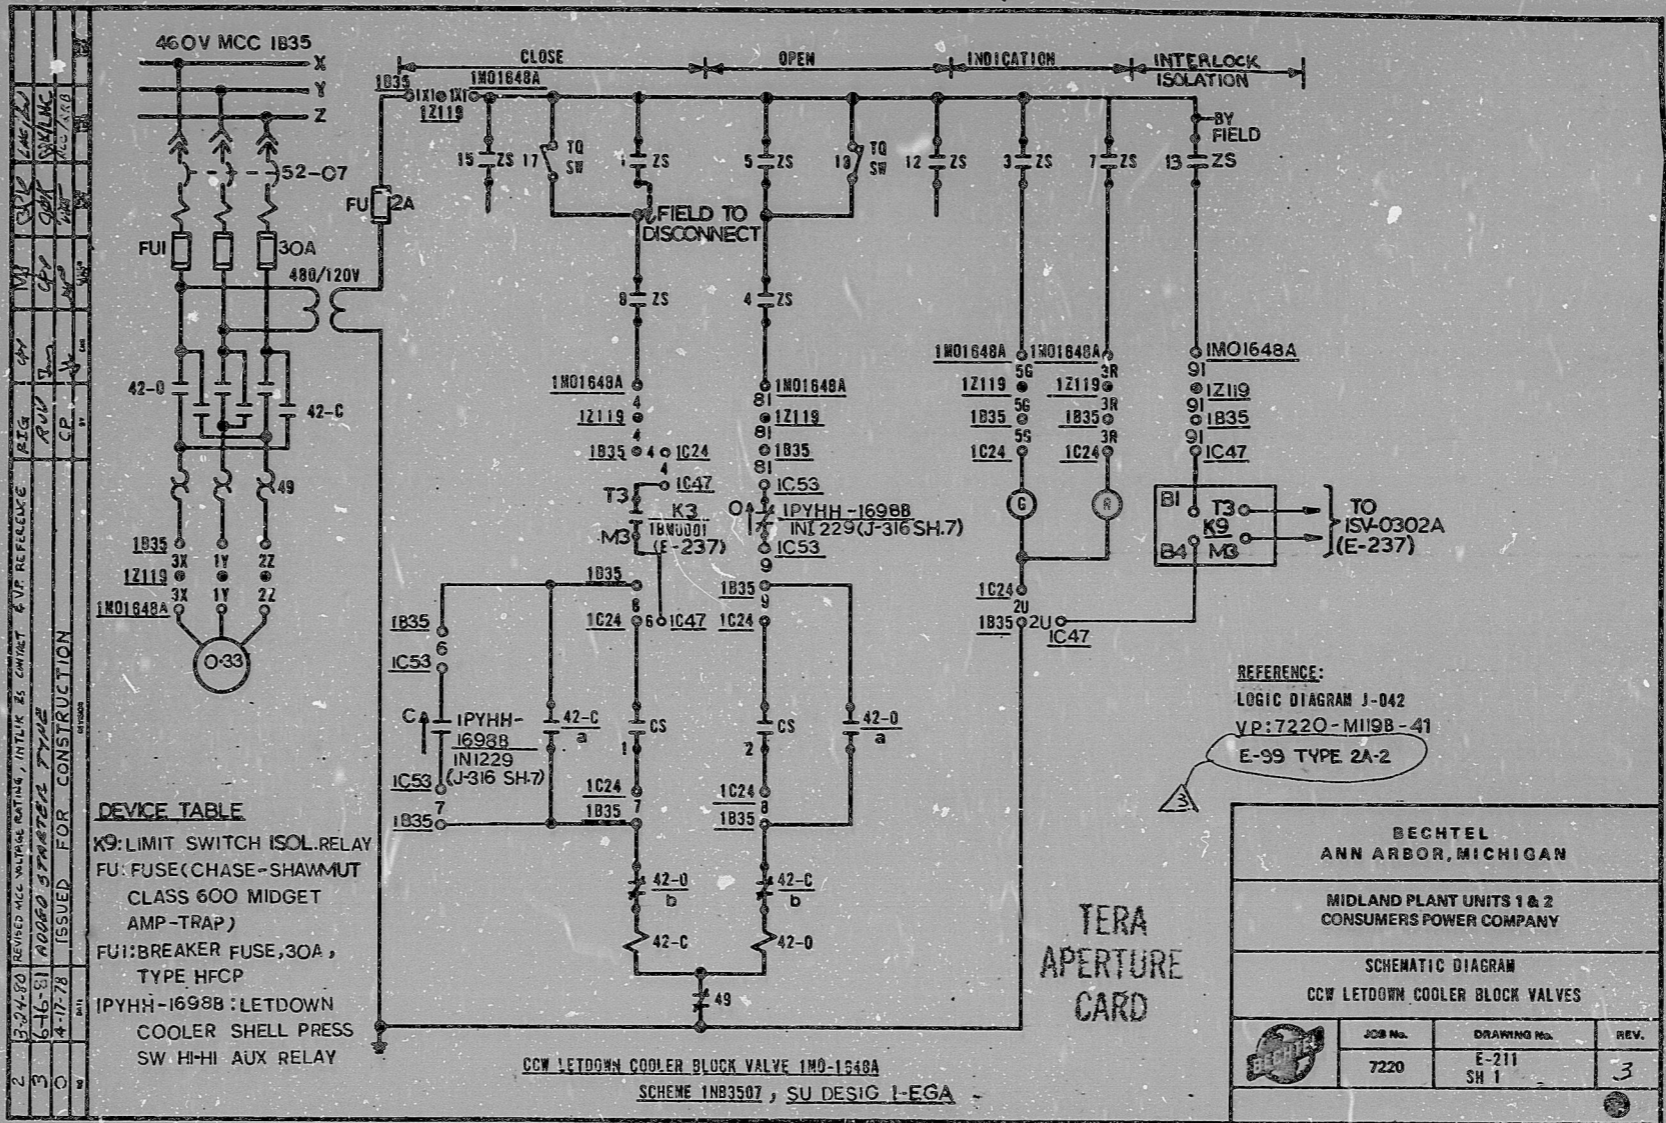

DEVICE TABLE

- X9: LIMIT SWITCH ISOL.RELAY
- FU: FUSE(CHASE-SHAWMUT CLASS 600 MIDGET AMP-TRAP)
- FUI: BREAKER FUSE, 30A, TYPE HFCP
- IPYHH-1698B: LETDOWN COOLER SHELL PRESS SW HI-HI AUX RELAY

REFERENCE:
LOGIC DIAGRAM J-042
VP:7220-M119B-41
E-99 TYPE 2A-2

BECHTEL ANN ARBOR, MICHIGAN		
MIDLAND PLANT UNITS 1 & 2 CONSUMERS POWER COMPANY		
SCHEMATIC DIAGRAM CCW LETDOWN COOLER BLOCK VALVES		
JOB No. 7220	DRAWING No. E-211 SH 1	REV. 3

I certify that the image contained on this frame was made in the normal and regular course of business, on the date stated below and that it is an accurate reproduction of the document submitted to reprographics.

6-19-81 *R. L. ...*
DATE CAMERA OPERATOR SUPERVISOR OF REPROGRAPHICS

16X

C-1348

RIDS

8112230450

