


LFMG SET DRIVE MOTOR BREAKER NO. 'A' CONTROL
REF 24

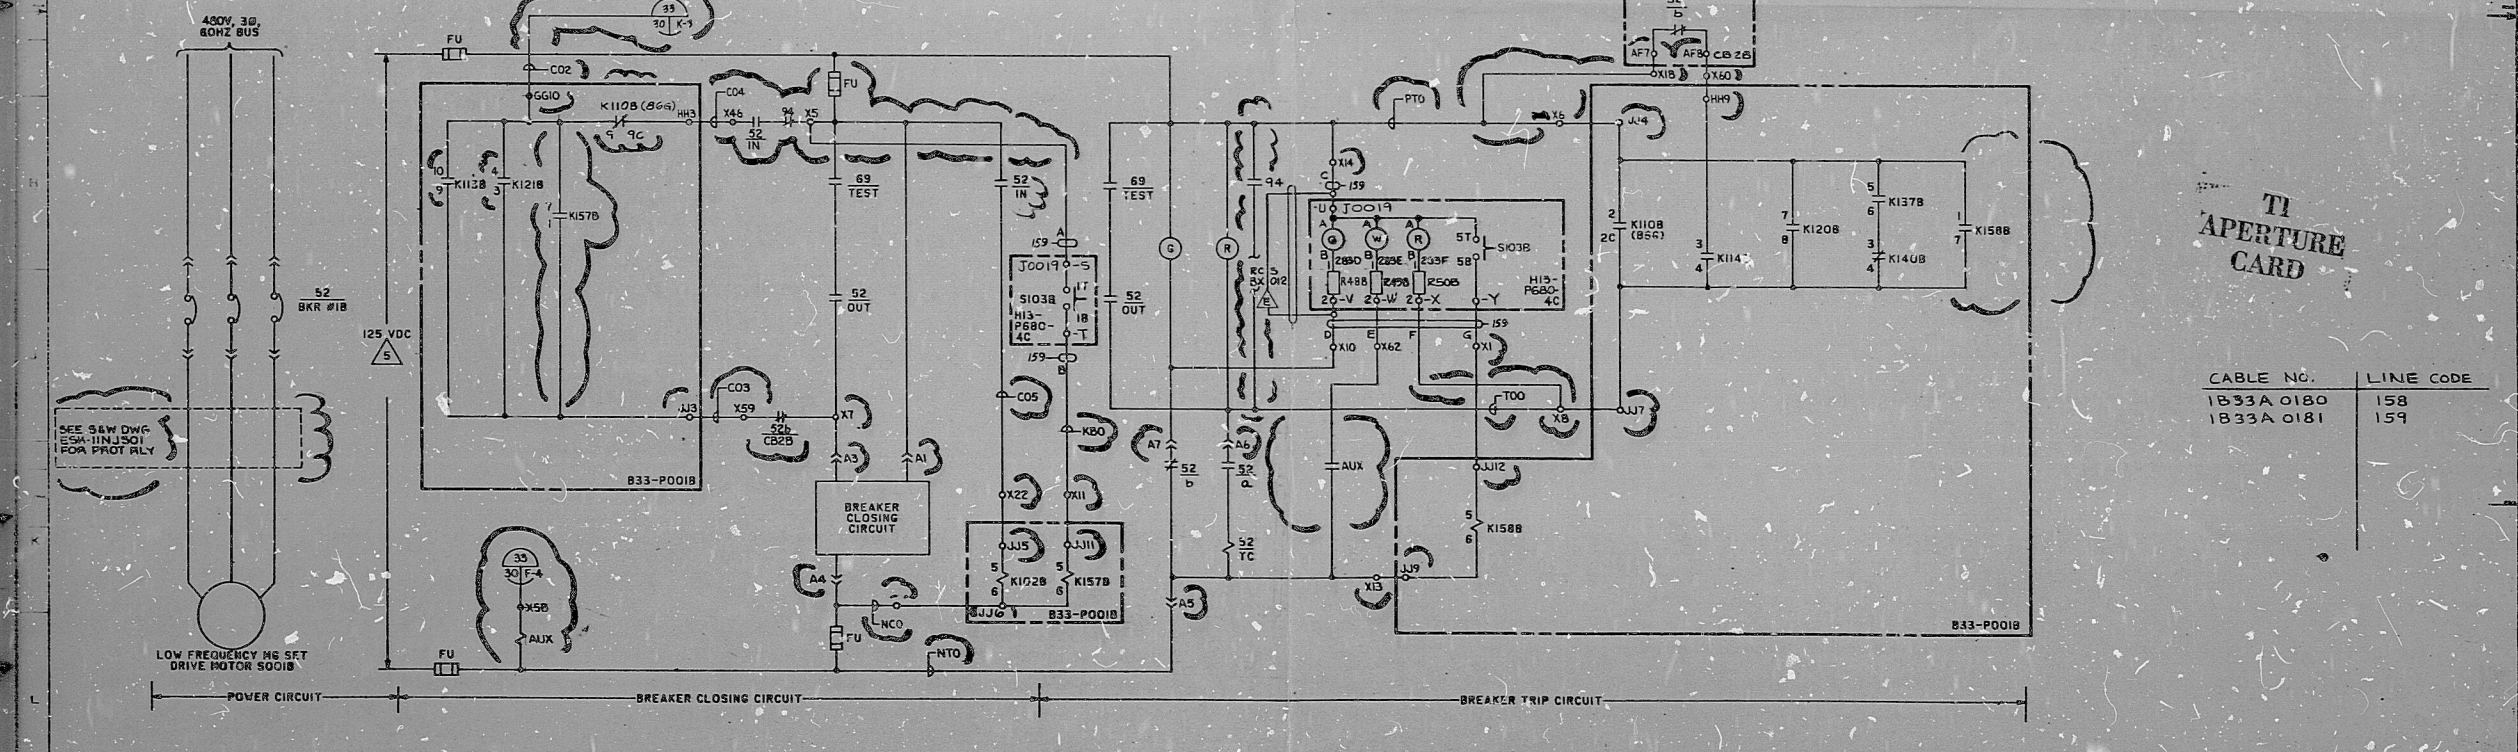

LFMG SET DRIVE MOTOR BREAKER NO. 'B' CONTROL
REF 25

TI
APERTURE
CARD

CABLE NO.	LINE CODE
1B33A 0180	158
1B33A 0181	159

LINE CODES 154, 159, 203.

NO.	DESCRIPTION	DATE	BY
11	REVISION		
10	REVISION		
9	REVISION		
8	REVISION		
7	REVISION		
6	REVISION		
5	REVISION		
4	REVISION		
3	REVISION		
2	REVISION		
1	REVISION		

8412200051

PDR RIDS

