


This drawing and the data, if letters are the property of BECHTEL. They are hereby loaned and on the borrower's express agreement that they will not be reproduced, copied, loaned, utilized, or used except in the limited way and phrase use permitted by any written consent given by the lender to the borrower.

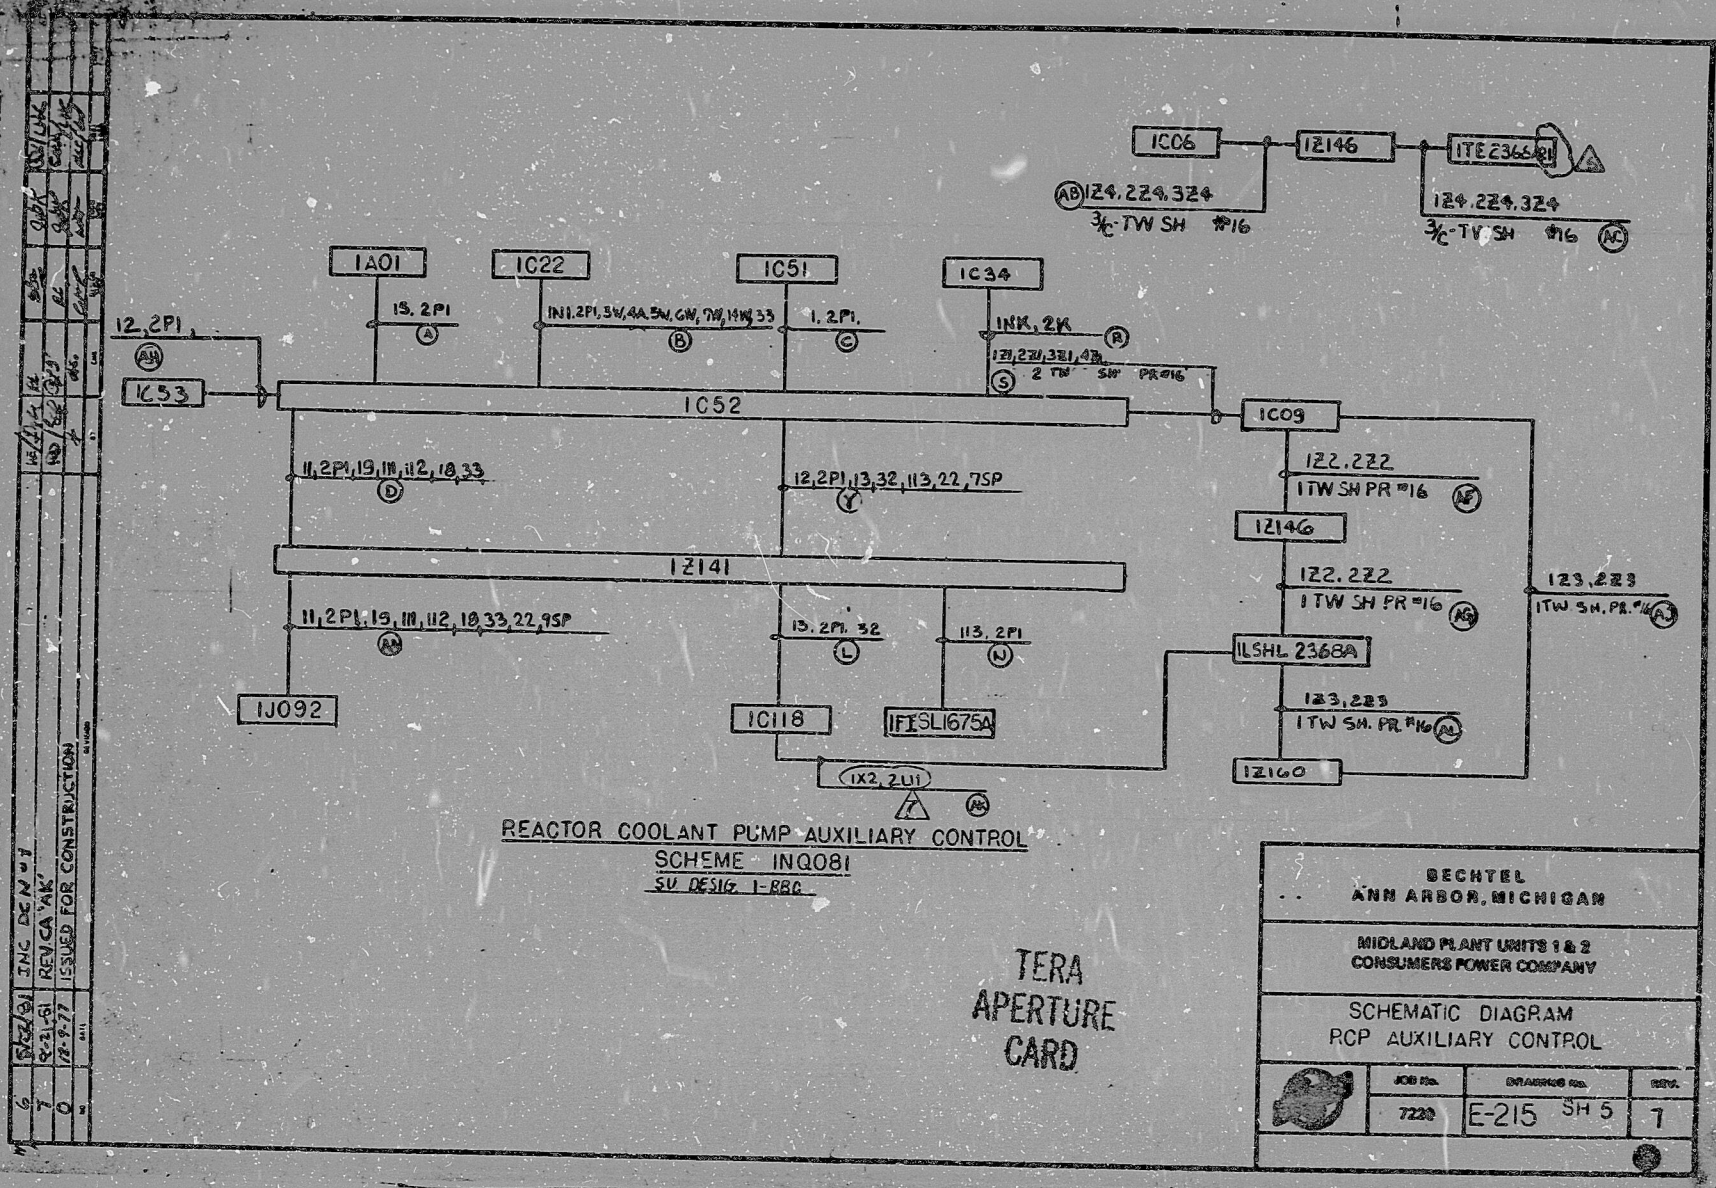

REACTOR COOLANT PUMP AUXILIARY CONTROL
SCHEME INQ081
SU DESIG 1-RBC

TERA
APERTURE
CARD

BECHTEL ANN ARBOR, MICHIGAN			
MIDLAND PLANT UNITS 1 & 2 CONSUMERS POWER COMPANY			
SCHEMATIC DIAGRAM RCP AUXILIARY CONTROL			
JOB NO.	CONTRACT NO.	REV.	
7220	E-215 SH 5	7	

I certify that the image contained on this frame was made in the normal and regular course of business, on the date stated below and that it is an accurate reproduction of the document submitted to reprographics.

9-1-81 DATE
CAMERA OPERATOR
SUPERVISOR OF REPROGRAPHICS

16X

RIDS

81/2230482

