


This drawing and the design it depicts are the property of BECHTEL. They are hereby loaned and on the borrower's express agreement that they will not be reproduced, copied, loaned, exhibited, or used in any way without the written consent given by the loaner to the borrower.

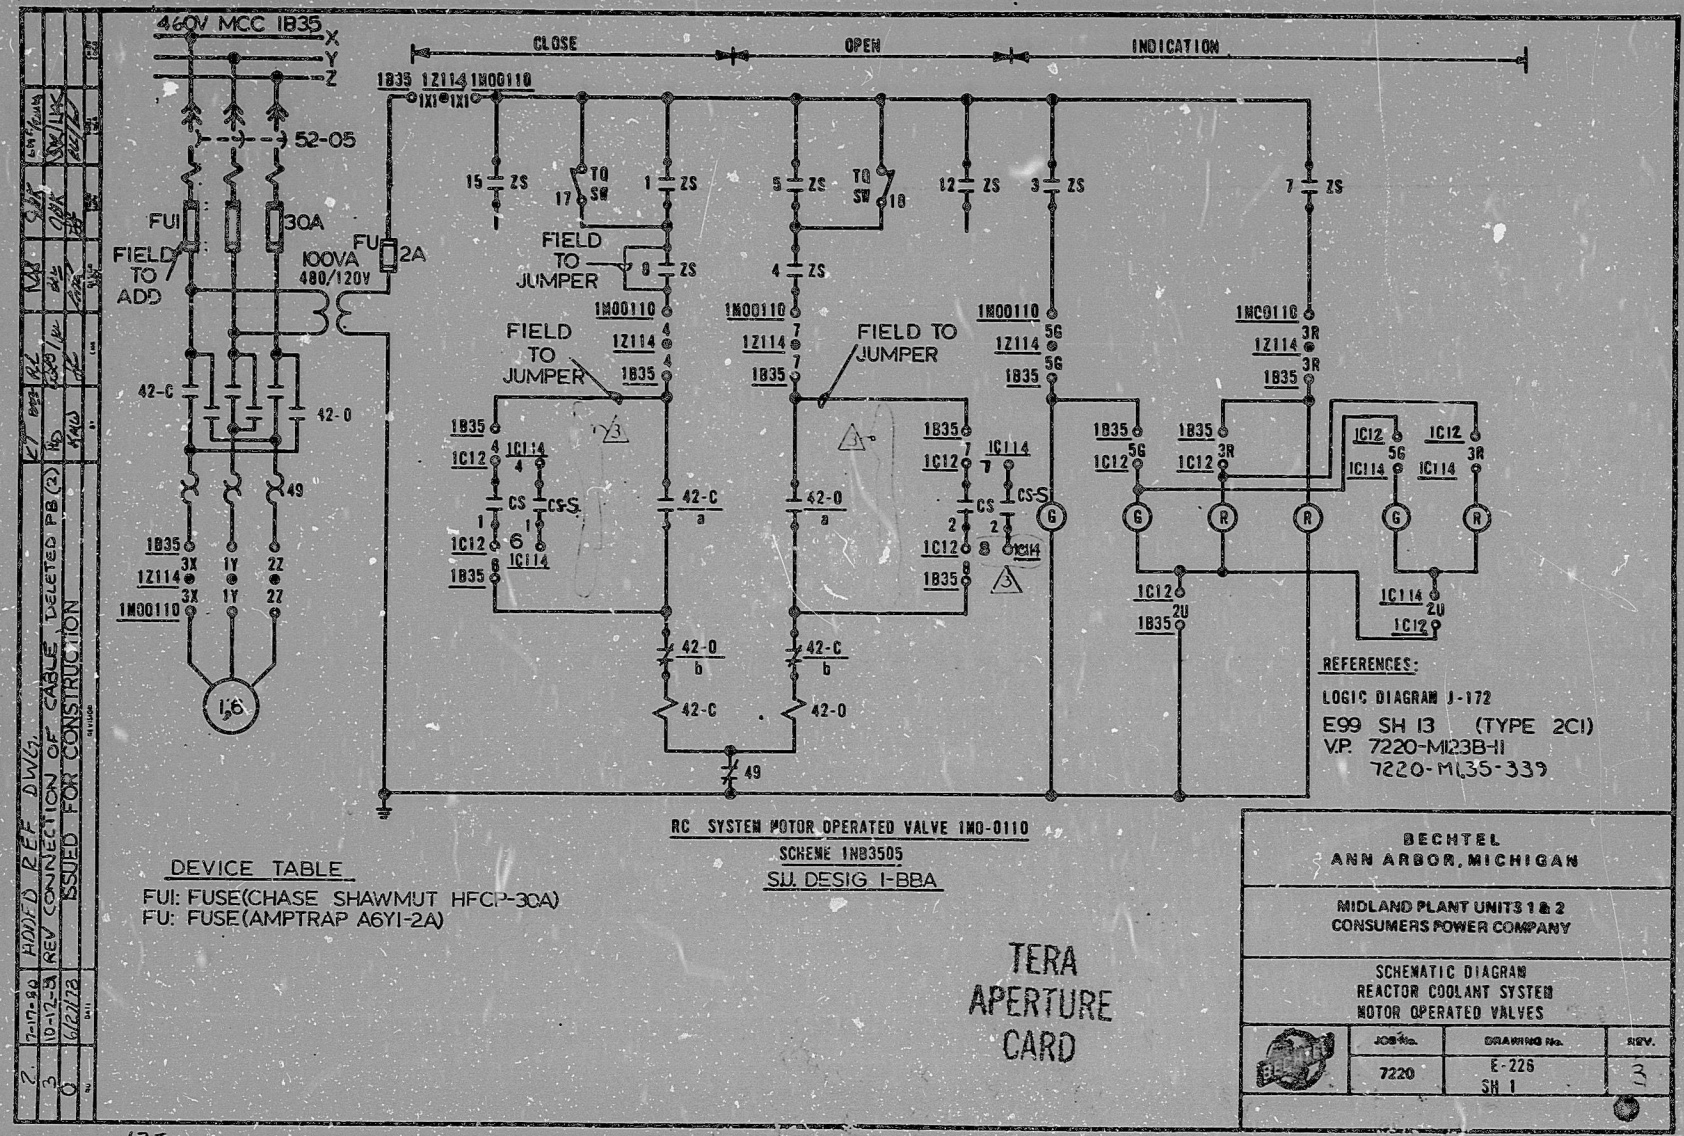

1	12-17-80	ADDED REF DWG.	1M00110	1Z114	1Z114	1Z114
2	10-17-81	REV CONNECTION OF CABLE DELETED FE (2)	1M00110	1Z114	1Z114	1Z114
3	10-17-81	REV CONNECTION OF CABLE DELETED FE (2)	1M00110	1Z114	1Z114	1Z114
4	10-17-81	ISSUED FOR CONSTRUCTION	1M00110	1Z114	1Z114	1Z114

DEVICE TABLE
 FUI: FUSE(CHASE SHAWMUT HFC-30A)
 FU: FUSE(AMPTRAP A6Y1-2A)

RC SYSTEM MOTOR OPERATED VALVE IMO-0110
 SCHEME 1B3505
 SII, DESIG 1-BBA

REFERENCES:
 LOGIC DIAGRAM J-172
 E99 SH 13 (TYPE 2C1)
 VP. 7220-M123B-II
 7220-M135-339

BECHTEL ANN ARBOR, MICHIGAN		
MIDLAND PLANT UNITS 1 & 2 CONSUMERS POWER COMPANY		
SCHEMATIC DIAGRAM REACTOR COOLANT SYSTEM MOTOR OPERATED VALVES		
JOB No. 7220	DRAWING No. E-226 SH 1	REV. 3

TERA
 APERTURE
 CARD

"I certify that the image contained on this frame was made in the normal and regular course of business, on the date stated below and that it is an accurate reproduction of the document submitted to the contractor for filing, by Bechtel Power Corporation."

10-13-81 DATE
 R. Capelle CAMERA OPERATOR
 J. Williams CONTRACTOR'S SUPERVISOR OR MANAGER

16X

R.D.S

8112230496

