


This drawing and the design it covers are the property of BECHTEL. They are hereby licensed and used on the licensee's premises under the licensee's copyright agreement that they will not be reproduced, copied, loaned, exhibited, or used except in the manner and for the purpose permitted by the written contract given by the licensor to the licensee.

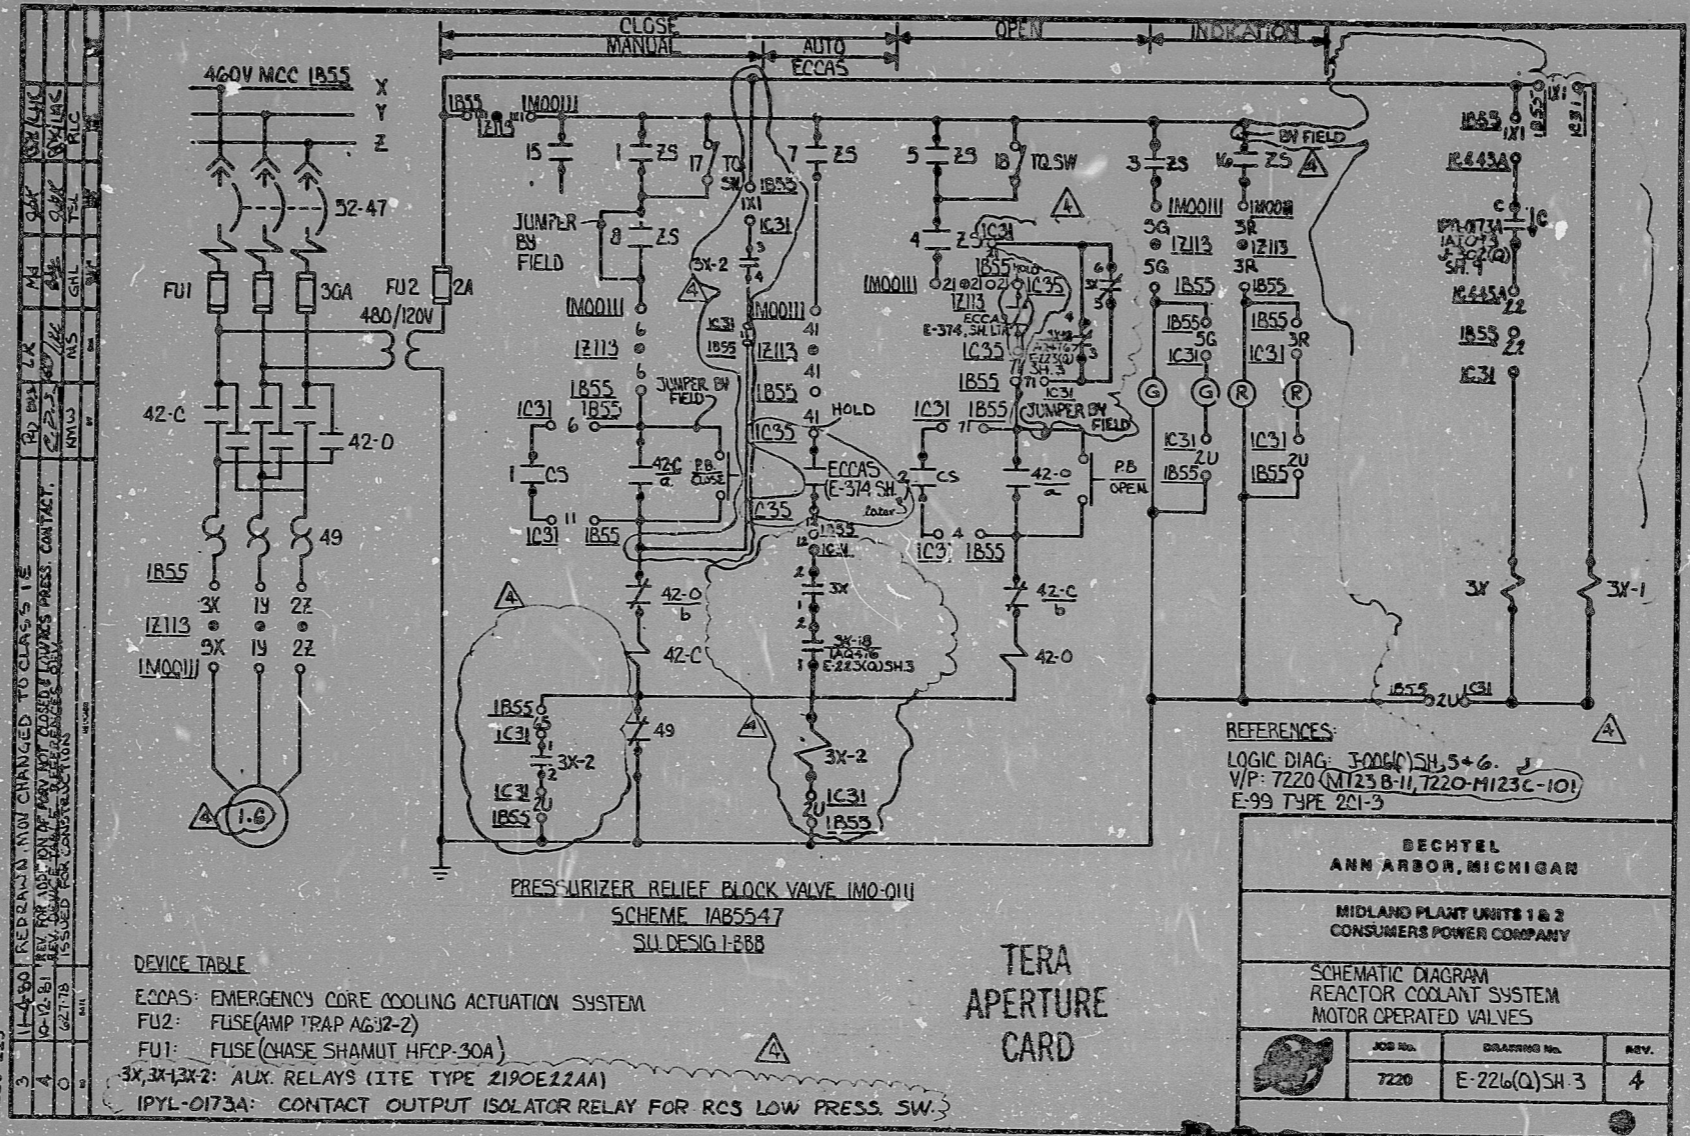

7220-115

NO.	DESCRIPTION	DATE	BY	CHKD.
1	ISSUED FOR CONSTRUCTION	12/15/59	W.S.	W.S.
2	REVISED FOR CONSTRUCTION	12/15/59	W.S.	W.S.
3	REVISED FOR CONSTRUCTION	12/15/59	W.S.	W.S.
4	REVISED FOR CONSTRUCTION	12/15/59	W.S.	W.S.

1A-850: REVISIONS NOT CHANGED TO CLASS 'E'
 1A-12-15: REV. FOR ASSEMBLY OF PRESS. CONTACT.
 1A-12-15: REV. FOR ASSEMBLY OF PRESS. CONTACT.
 1A-12-15: REV. FOR ASSEMBLY OF PRESS. CONTACT.

DEVICE TABLE
 ECCAS: EMERGENCY CORE COOLING ACTUATION SYSTEM
 FU2: FUSE (AMP TRAP AG32-2)
 FU1: FUSE (CHASE SHAMUT HFOP-30A)
 3X, 3X-1, 3X-2: AUX. RELAYS (ITE TYPE Z190E22AA)
 IPYL-0173A: CONTACT OUTPUT ISOLATOR RELAY FOR RCS LOW PRESS. SW.

REFERENCES:
 LOGIC DIAG: J006(N)SH 5+6
 V/P: 7220 (M125 B-II, 7220-M123C-101)
 E-99 TYPE 201-3

BECHTEL ANN ARBOR, MICHIGAN		
MIDLAND PLANT UNITS 1 & 2 CONSUMERS POWER COMPANY		
SCHEMATIC DIAGRAM REACTOR COOLANT SYSTEM MOTOR OPERATED VALVES		
JOB No. 7220	DRAWING No. E-226(Q)SH 3	REV. 4

TERA
 APERTURE
 CARD

16X

I certify that the image obtained on this frame was made in the normal and regular course of business, on the date stated below and that it is an accurate reproduction of the document submitted to the contractor for filming, by Bechtel Power Corporation.

DATE: 10-13-81
 CAMERA OPERATOR: R. Capelle
 CONTRACTOR'S SUPERVISOR OR MANAGER: J. Williams

POOR ORIGINAL

8.5"
 11"
 17"

8.5"
 11"
 17"

RIDS

8112230499

