

11

11

8.5

8.5

11

17

11

11

8.5


8.5

11

17

This drawing and the design it covers are the property of BECHTEL. They are hereby loaned and on the borrower's express agreement that they will not be reproduced, copied, loaned, exhibited, or used except in the limited way and for the purposes permitted by any written contract given by the lender to the borrower.

REVISED	S.U. DESIGNATION & DATE NOS.	ISSUED FOR CONSTRUCTION
1	2P53A	2P53A
2	2P53B	2P53B
3	2P53C	2P53C
4	2P53D	2P53D
5	2P53E	2P53E
6	2P53F	2P53F
7	2P53G	2P53G
8	2P53H	2P53H
9	2P53I	2P53I
10	2P53J	2P53J
11	2P53K	2P53K
12	2P53L	2P53L
13	2P53M	2P53M
14	2P53N	2P53N
15	2P53O	2P53O
16	2P53P	2P53P
17	2P53Q	2P53Q
18	2P53R	2P53R
19	2P53S	2P53S
20	2P53T	2P53T
21	2P53U	2P53U
22	2P53V	2P53V
23	2P53W	2P53W
24	2P53X	2P53X
25	2P53Y	2P53Y
26	2P53Z	2P53Z

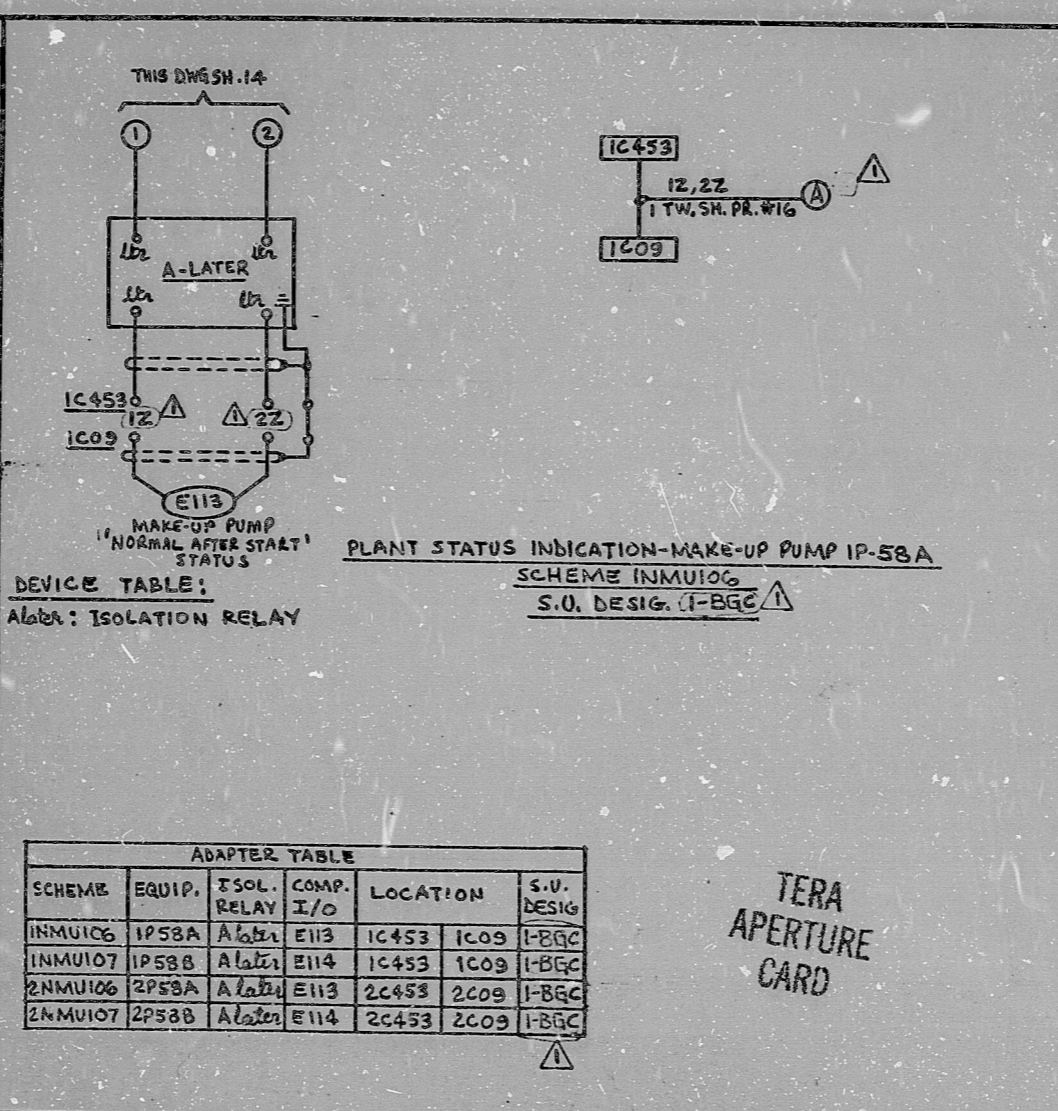

CERTIFICATE OF MICROFILMING

"I certify that the image contained on this frame was made in the normal and regular course of business, on the date stated below and that it is an accurate reproduction of the document submitted to the contractor for filming, by Bechtel Power Corporation.

9-20-81 Date  
 [Signature] Camera Operator  
 [Signature] Contractor's Sup'vr. or Manager

REFERENCES:

LOGIC DIAGRAM: J232 SH.3-10.  
 V.P.: later

BECHTEL ANN ARBOR, MICHIGAN		
MIDLAND PLANT UNITS 1 & 2 CONSUMERS POWER COMPANY		
SCHEMATIC DIAGRAM MAKE-UP PUMPS		
JOB No.	DRAWING No.	REV.
7220	E-231(R) SH.15	5

TERA APERTURE CARD

16X

RIDS

8112230523

