


This drawing and the design it covers are the property of BECHTEL. They are hereby loaned and on the loaner's return agreement that they will not be reproduced, copied, loaned, exhibited, or used except in full compliance with the terms and conditions set forth in the loan agreement.

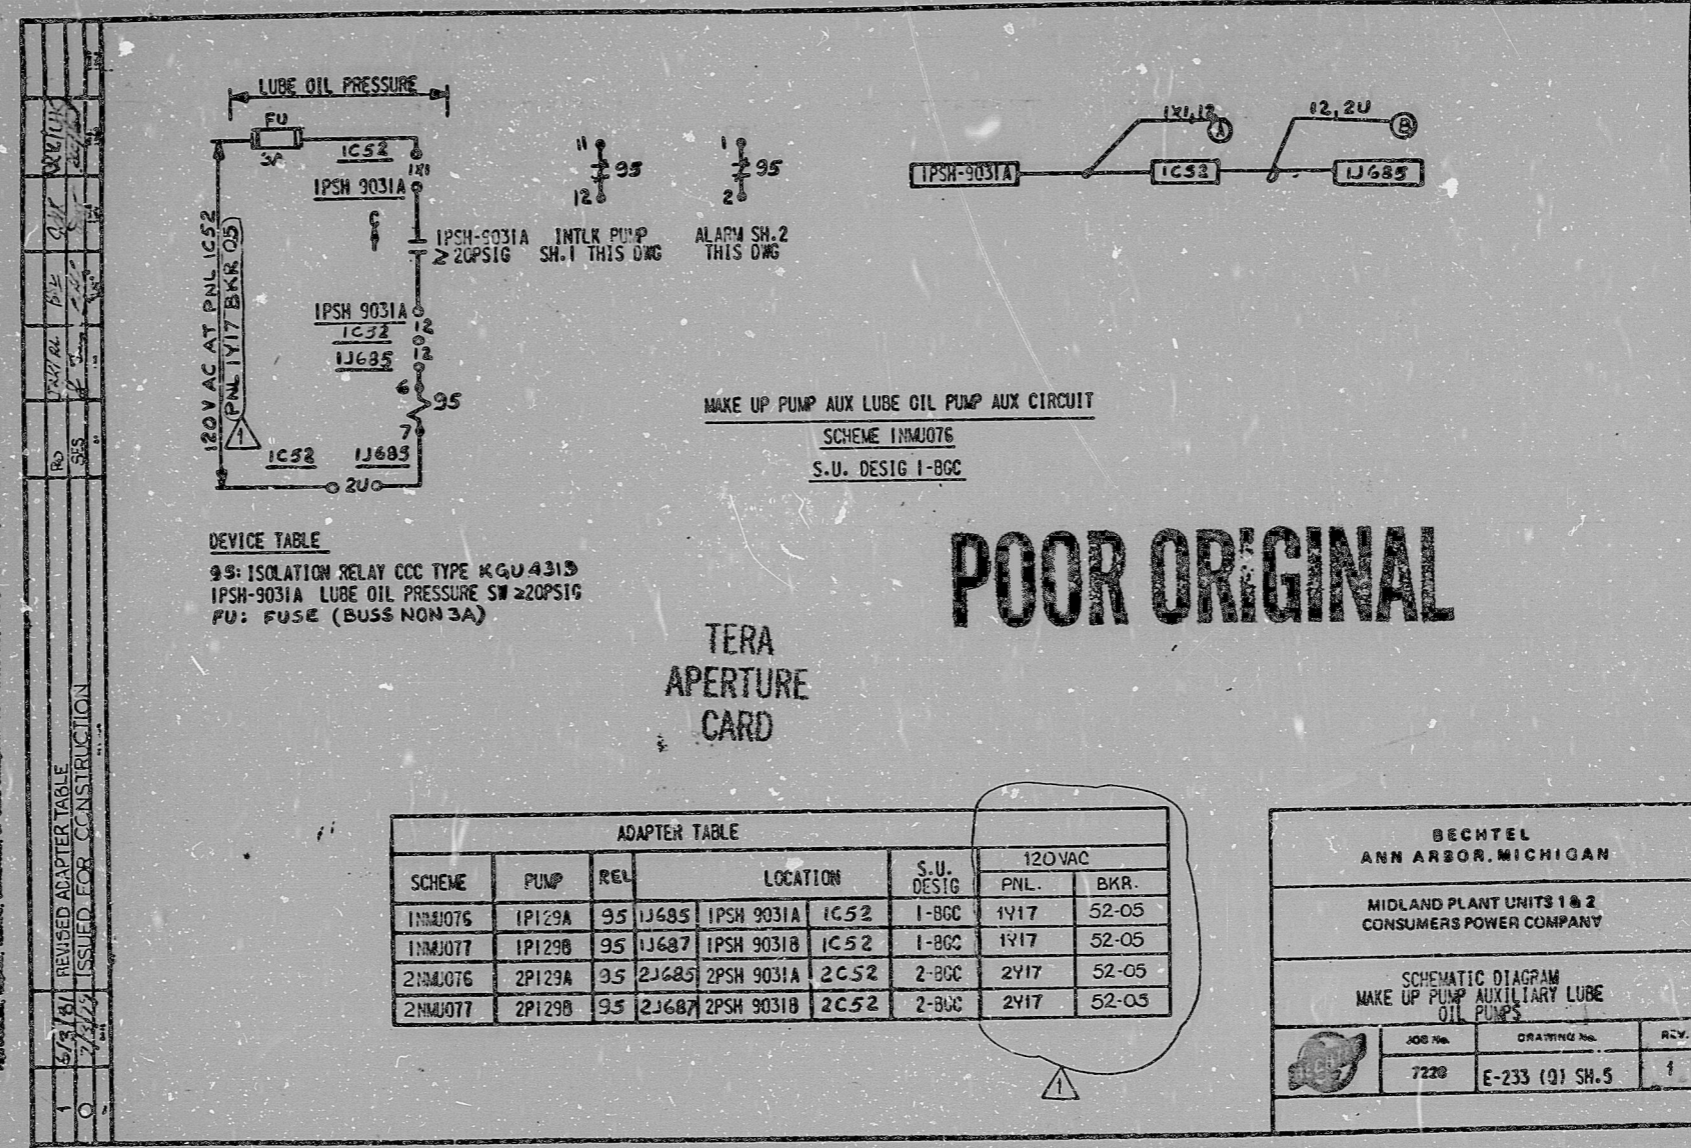

**DEVICE TABLE**  
 95: ISOLATION RELAY CCC TYPE KGU4315  
 IPSH-9031A LUBE OIL PRESSURE SW 20PSIG  
 FU: FUSE (BUSS NON 3A)

MAKE UP PUMP AUX LUBE OIL PUMP AUX CIRCUIT  
 SCHEME 1NMJ076  
 S.U. DESIG 1-BGC

**POOR ORIGINAL**

TERA  
 APERTURE  
 CARD

ADAPTER TABLE								
SCHEME	PUMP	REL	LOCATION			S.U. DESIG	120VAC	
			PNL.	BKR.	PNL.		BKR.	
1NMJ076	1P129A	95	1J685	IPSH 9031A	1C52	1-BGC	1Y17	52-05
1NMJ077	1P129B	95	1J687	IPSH 9031B	1C52	1-BGC	1Y17	52-05
2NMJ076	2P129A	95	2J685	2PSH 9031A	2C52	2-BGC	2Y17	52-05
2NMJ077	2P129B	95	2J687	2PSH 9031B	2C52	2-BGC	2Y17	52-05

BECHTEL ANN ARBOR, MICHIGAN		
MIDLAND PLANT UNITS 1 & 2 CONSUMERS POWER COMPANY		
SCHEMATIC DIAGRAM MAKE UP PUMP AUXILIARY LUBE OIL PUMPS		
JOB No.	DRAWING No.	REV.
7220	E-233 (Q) SH.5	1

I certify that the image contained on this frame was made in the normal and regular course of business, on the date stated below and that it is an accurate reproduction of the document submitted to reprographics.

6-12-81 M. C. CROSBY  
 DATE CAMERA OPERATOR SUPERVISOR OF REPROGRAPHICS

**16X**

G-1348

RIDS

8112230592

