


ALL WIRING IS UNLESS OTHERWISE INDICATED.

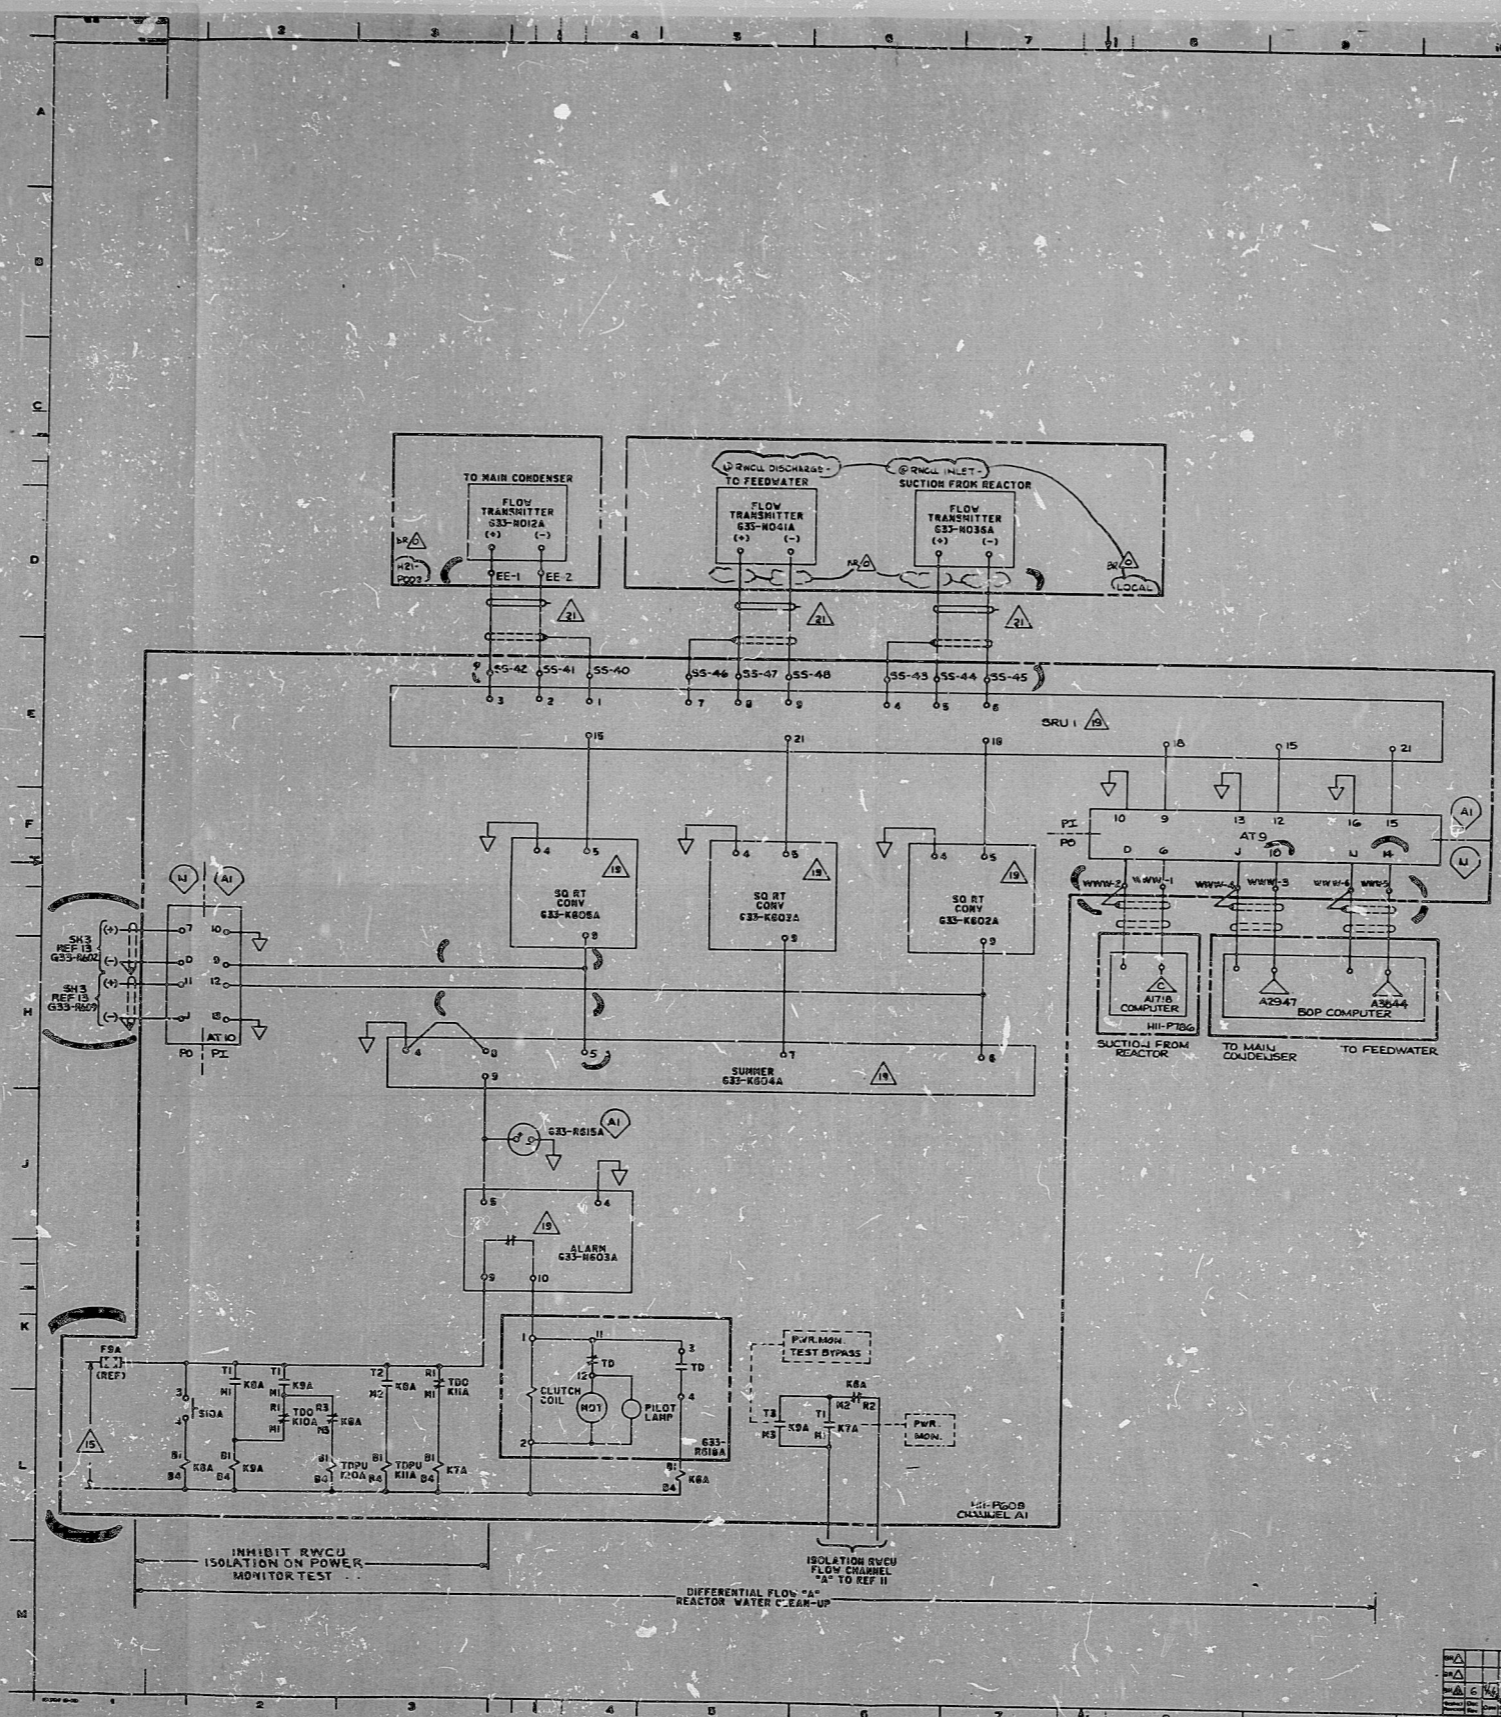

PRC APERTURE CARD

APR 1982

10850-NI-521-102-1-10-11

871-1050

87-315200/CC

AUG 03 1982

NO.	REV.	DATE	BY	CHKD BY
1				
2				
3				
4				
5				
6				

NO.	REV.	DATE	BY	CHKD BY
1				
2				
3				
4				
5				
6				

22"
17"
11"
8.5"
8.5"
11"
17"
22"

22"
17"
11"
8.5"
8.5"
11"
17"
22"

RIDS

8397280424

