
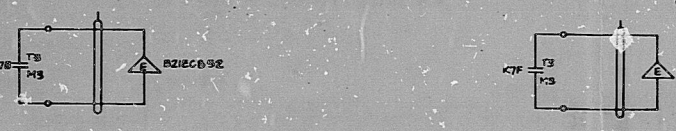


CABLE NO.	LINE CODE
JB21C0100	12
0105	13
0051	14
0050	15

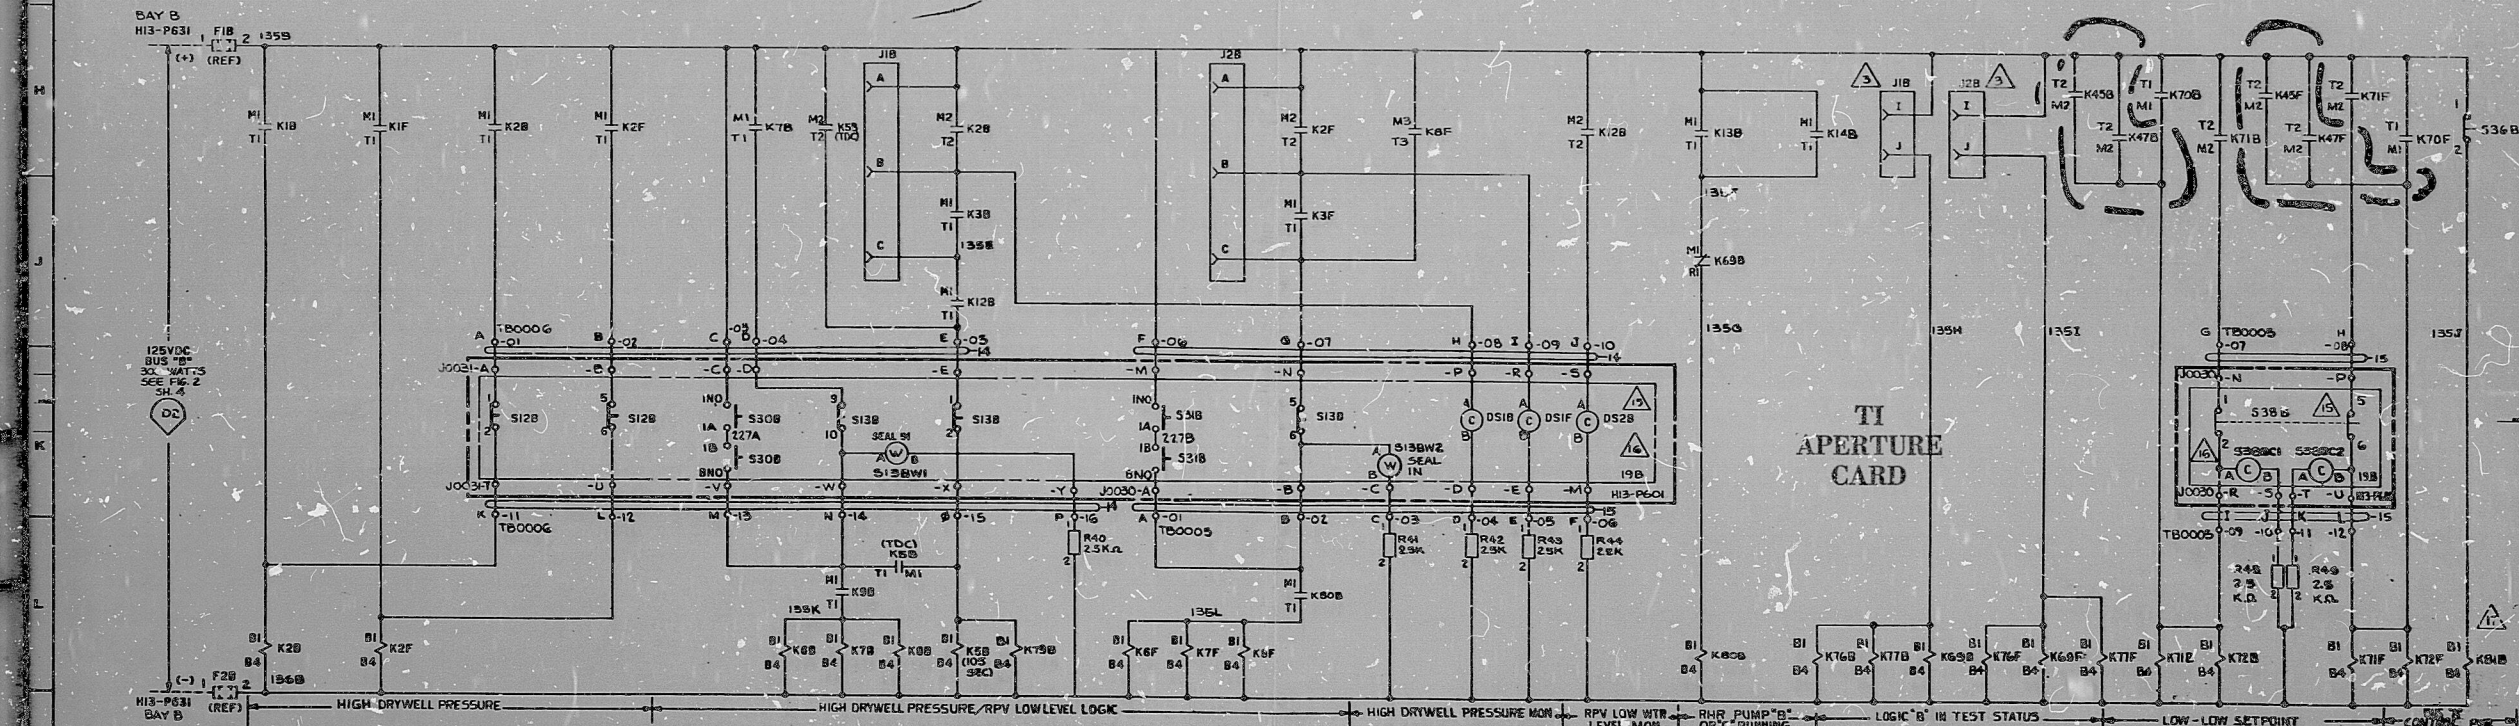

LINE CODES	IN	OUT
1	1	1
2	2	2
3	3	3
4	4	4
5	5	5
6	6	6

TI APERTURE CARD

84121²⁰200102

PDR RIDS

