


ALL WIRING IS 04 UNLESS OTHERWISE INDICATED

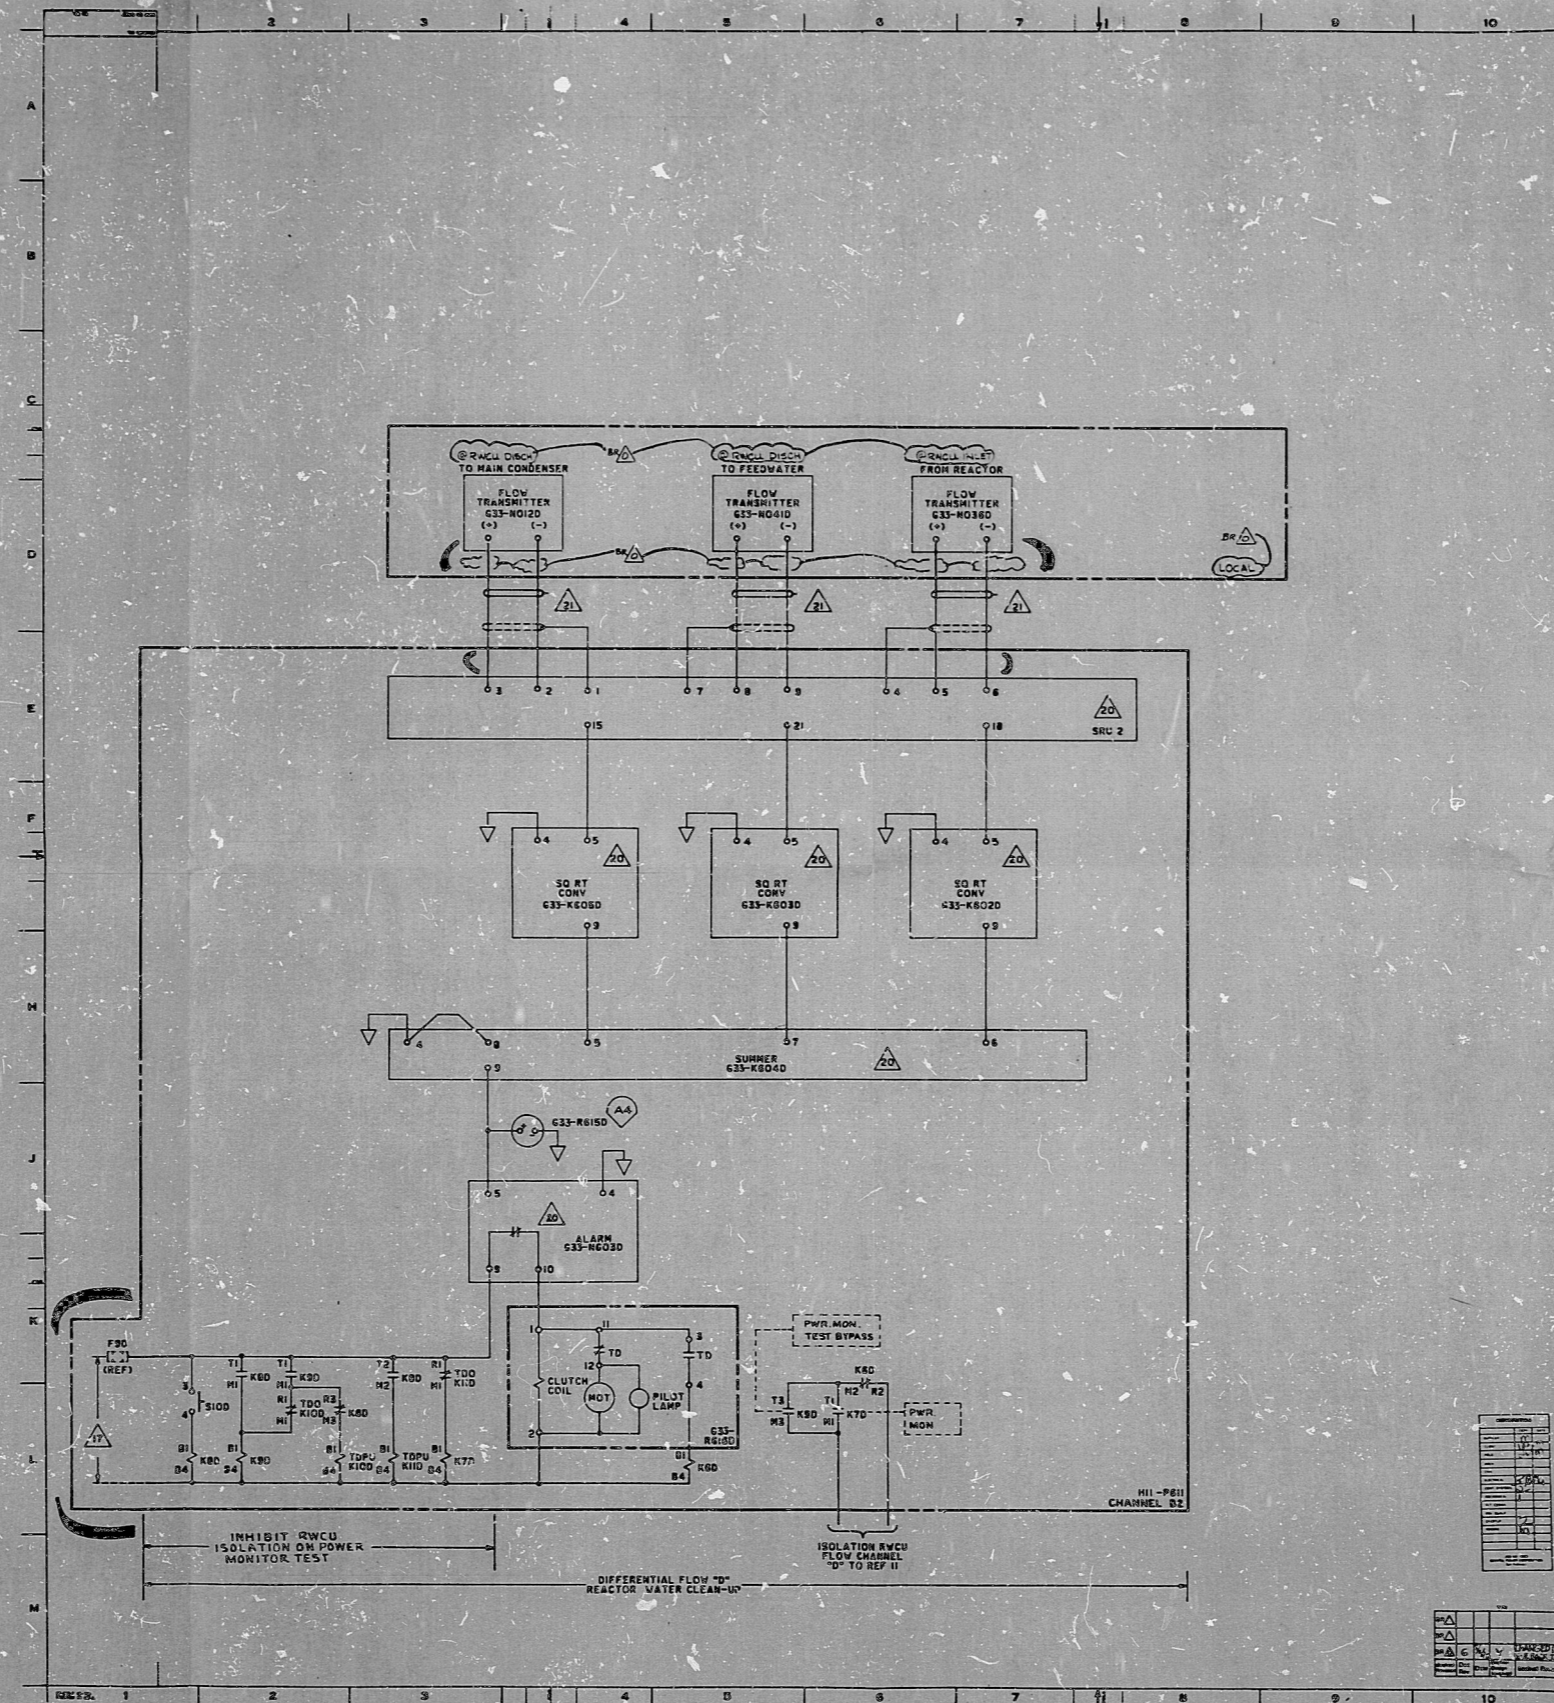

P.R.C. APERTURE CARD

B21-1050
 AS SHOWN

10655-NI-500-10064 (91)-8

NO.	DESCRIPTION	DATE	BY
1	ISSUED FOR CONSTRUCTION	10/1/68	J. J. [unclear]
2	REVISION		
3	REVISION		
4	REVISION		
5	REVISION		
6	REVISION		
7	REVISION		
8	REVISION		
9	REVISION		
10	REVISION		

RIDS

8307280426

