


11
8.5
8.5
11
17

11
8.5
8.5
11
17

The drawings and the design it contains are the property of BECHTEL. They are made to be used on the borrower's special agreement that they are not to be reproduced, copied, loaned, exhibited, or used except in the limited way and purpose as permitted by any written consent given by the lender to the borrower.

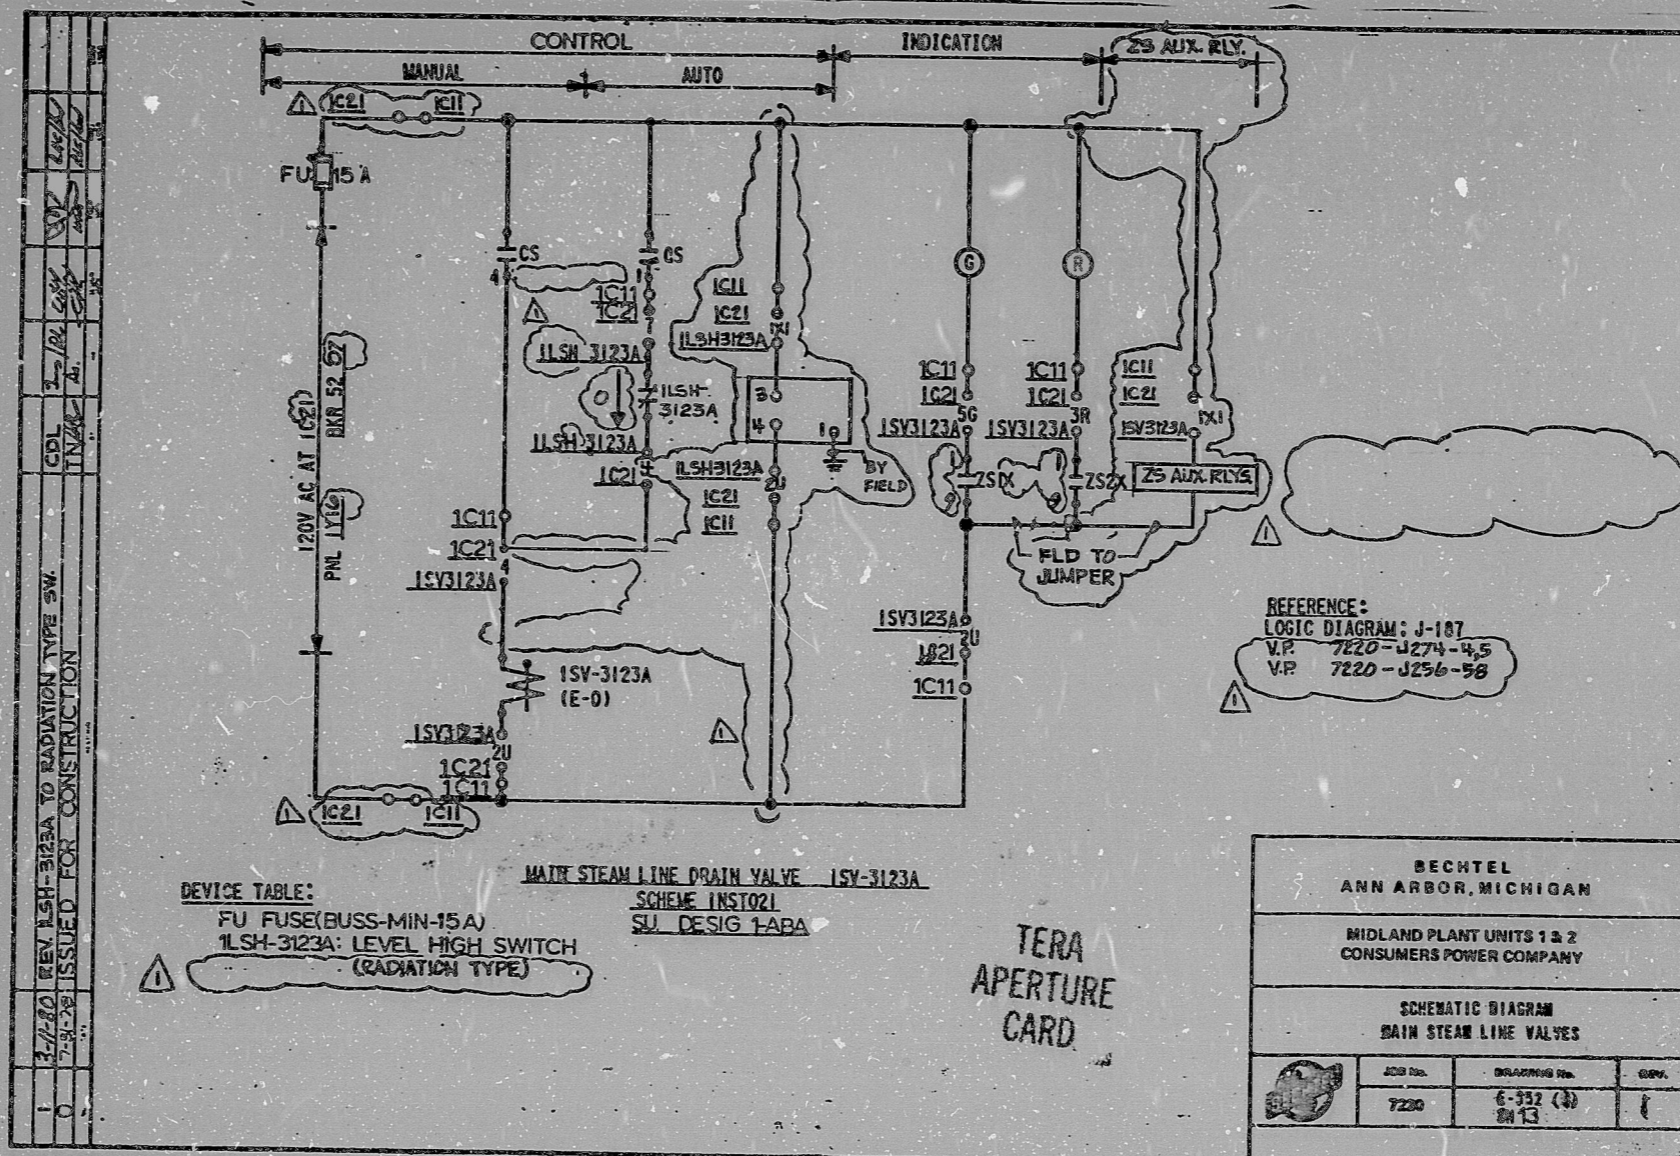

DEVICE TABLE:
 FU FUSE(BUSS-MIN-15A)
 LSH-3123A: LEVEL HIGH SWITCH
 (RADIATION TYPE)

MAIN STEAM LINE DRAIN VALVE ISV-3123A
 SCHEME INST021
 SU DESIG 1-ABA

REFERENCE:
 LOGIC DIAGRAM: J-187
 V.P. 7220-3274-4,5
 V.P. 7220-3256-58

BECHTEL ANN ARBOR, MICHIGAN		
MIDLAND PLANT UNITS 1 & 2 CONSUMERS POWER COMPANY		
SCHEMATIC DIAGRAM MAIN STEAM LINE VALVES		
JOB No.	DRAWING No.	COMP.
7220	6-352 (3) EN 13	

TERA
APERTURE
CARD

26

16X

I certify that the image contained on this frame
 was made in the normal and regular course of
 business, on the date stated below and that it is
 an accurate reproduction of the document submitted
 to the contractor for filing, by Bechtel Power
 Corporation.
 10-28-81 R. Capelle J. Alvarado
 DATE CAMERA OPERATOR CONTRACTOR'S SUP'VR
 OR MANAGER

RIPS

8112280120

